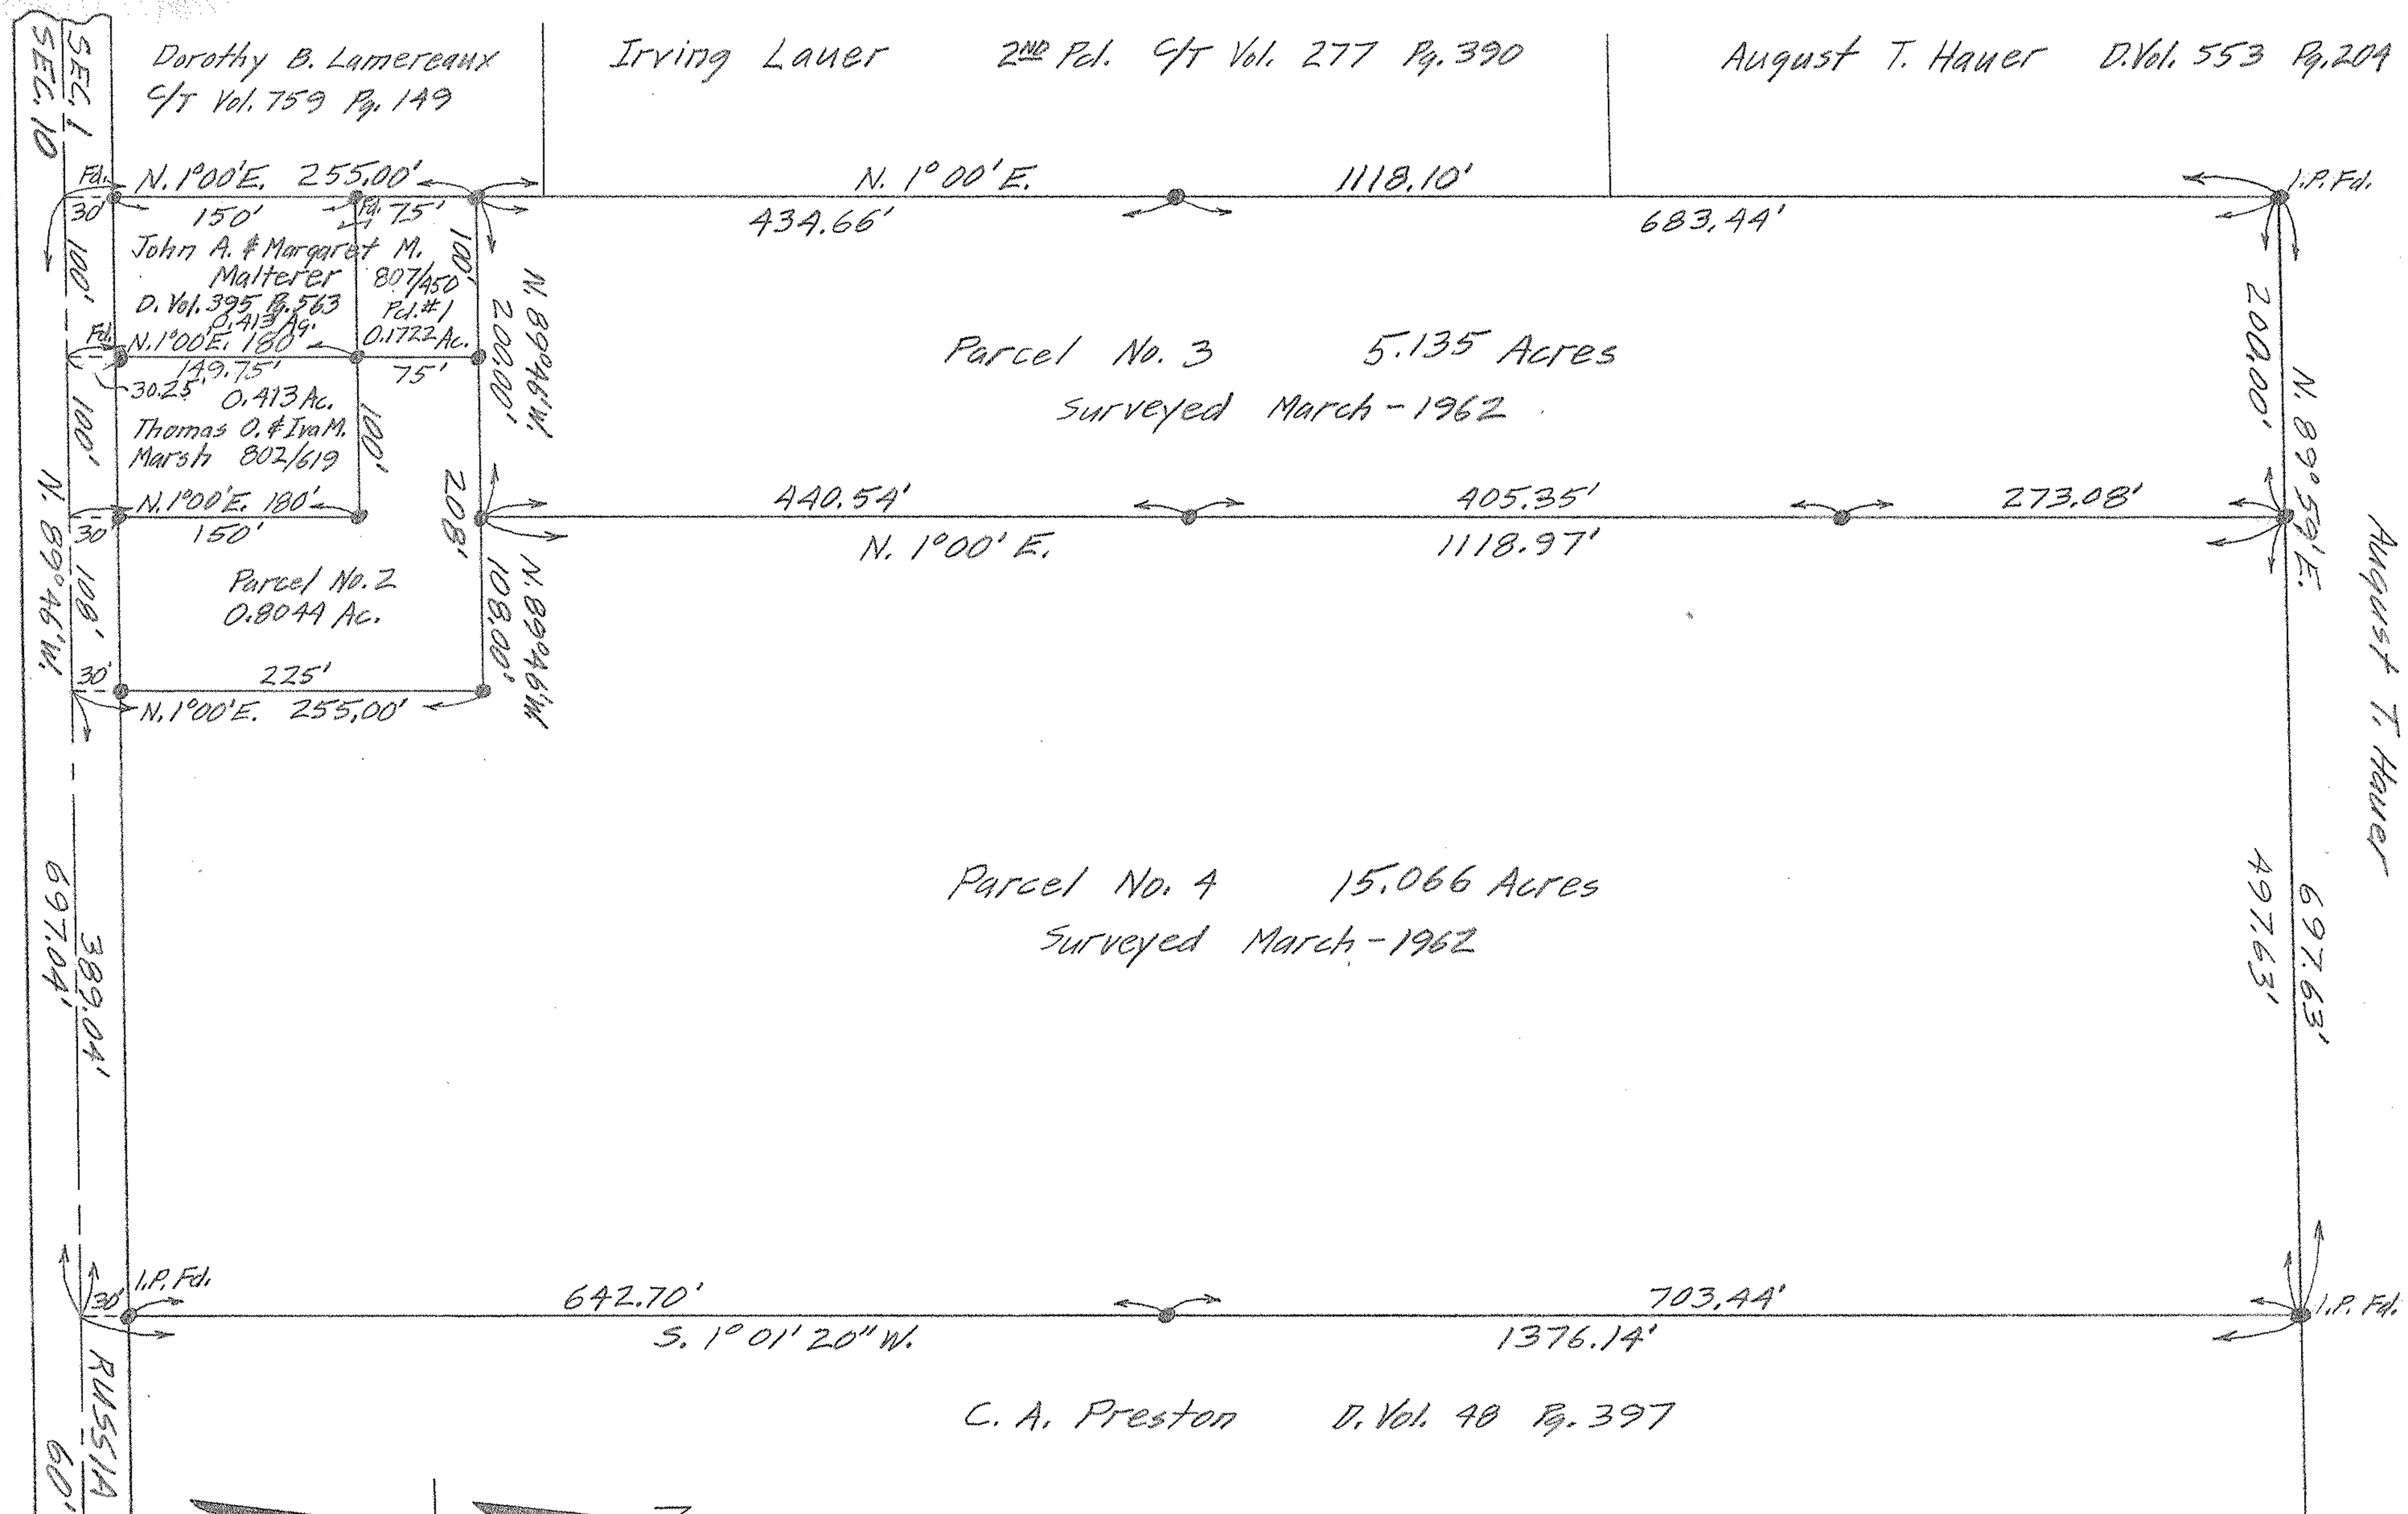

NOTE: ● indicates iron pin set unless otherwise designated.

PLAT OF SURVEYS FOR THOMAS O. & IVA M. MARSH
PARTS OF ORIGINAL SECTION 1 CARLISLE TOWNSHIP
LORAIN COUNTY OHIO
SCALE: 1" = 100'

PARCELS 1 & 2 SURVEYED BY C.E. PENFOUND - REG. SURVEYOR NO. 3200
PARCELS 3 & 4 SURVEYED BY GARY E. PENFOUND - REG. SURVEYOR NO. 4457

10-00-001-??? 10-00-001-F 10-00-001