MAP OF SURVEY
FOR
EDWARD A. YOUNG, II

SITUATED IN THE TOWNSHIP OF AMHERST, COUNTY OF LORAIN AND STATE OF OHIO AND KNOWN AS BEING PART OF ORIGINAL AMHERST TOWNSHIP LOT NO. 94.

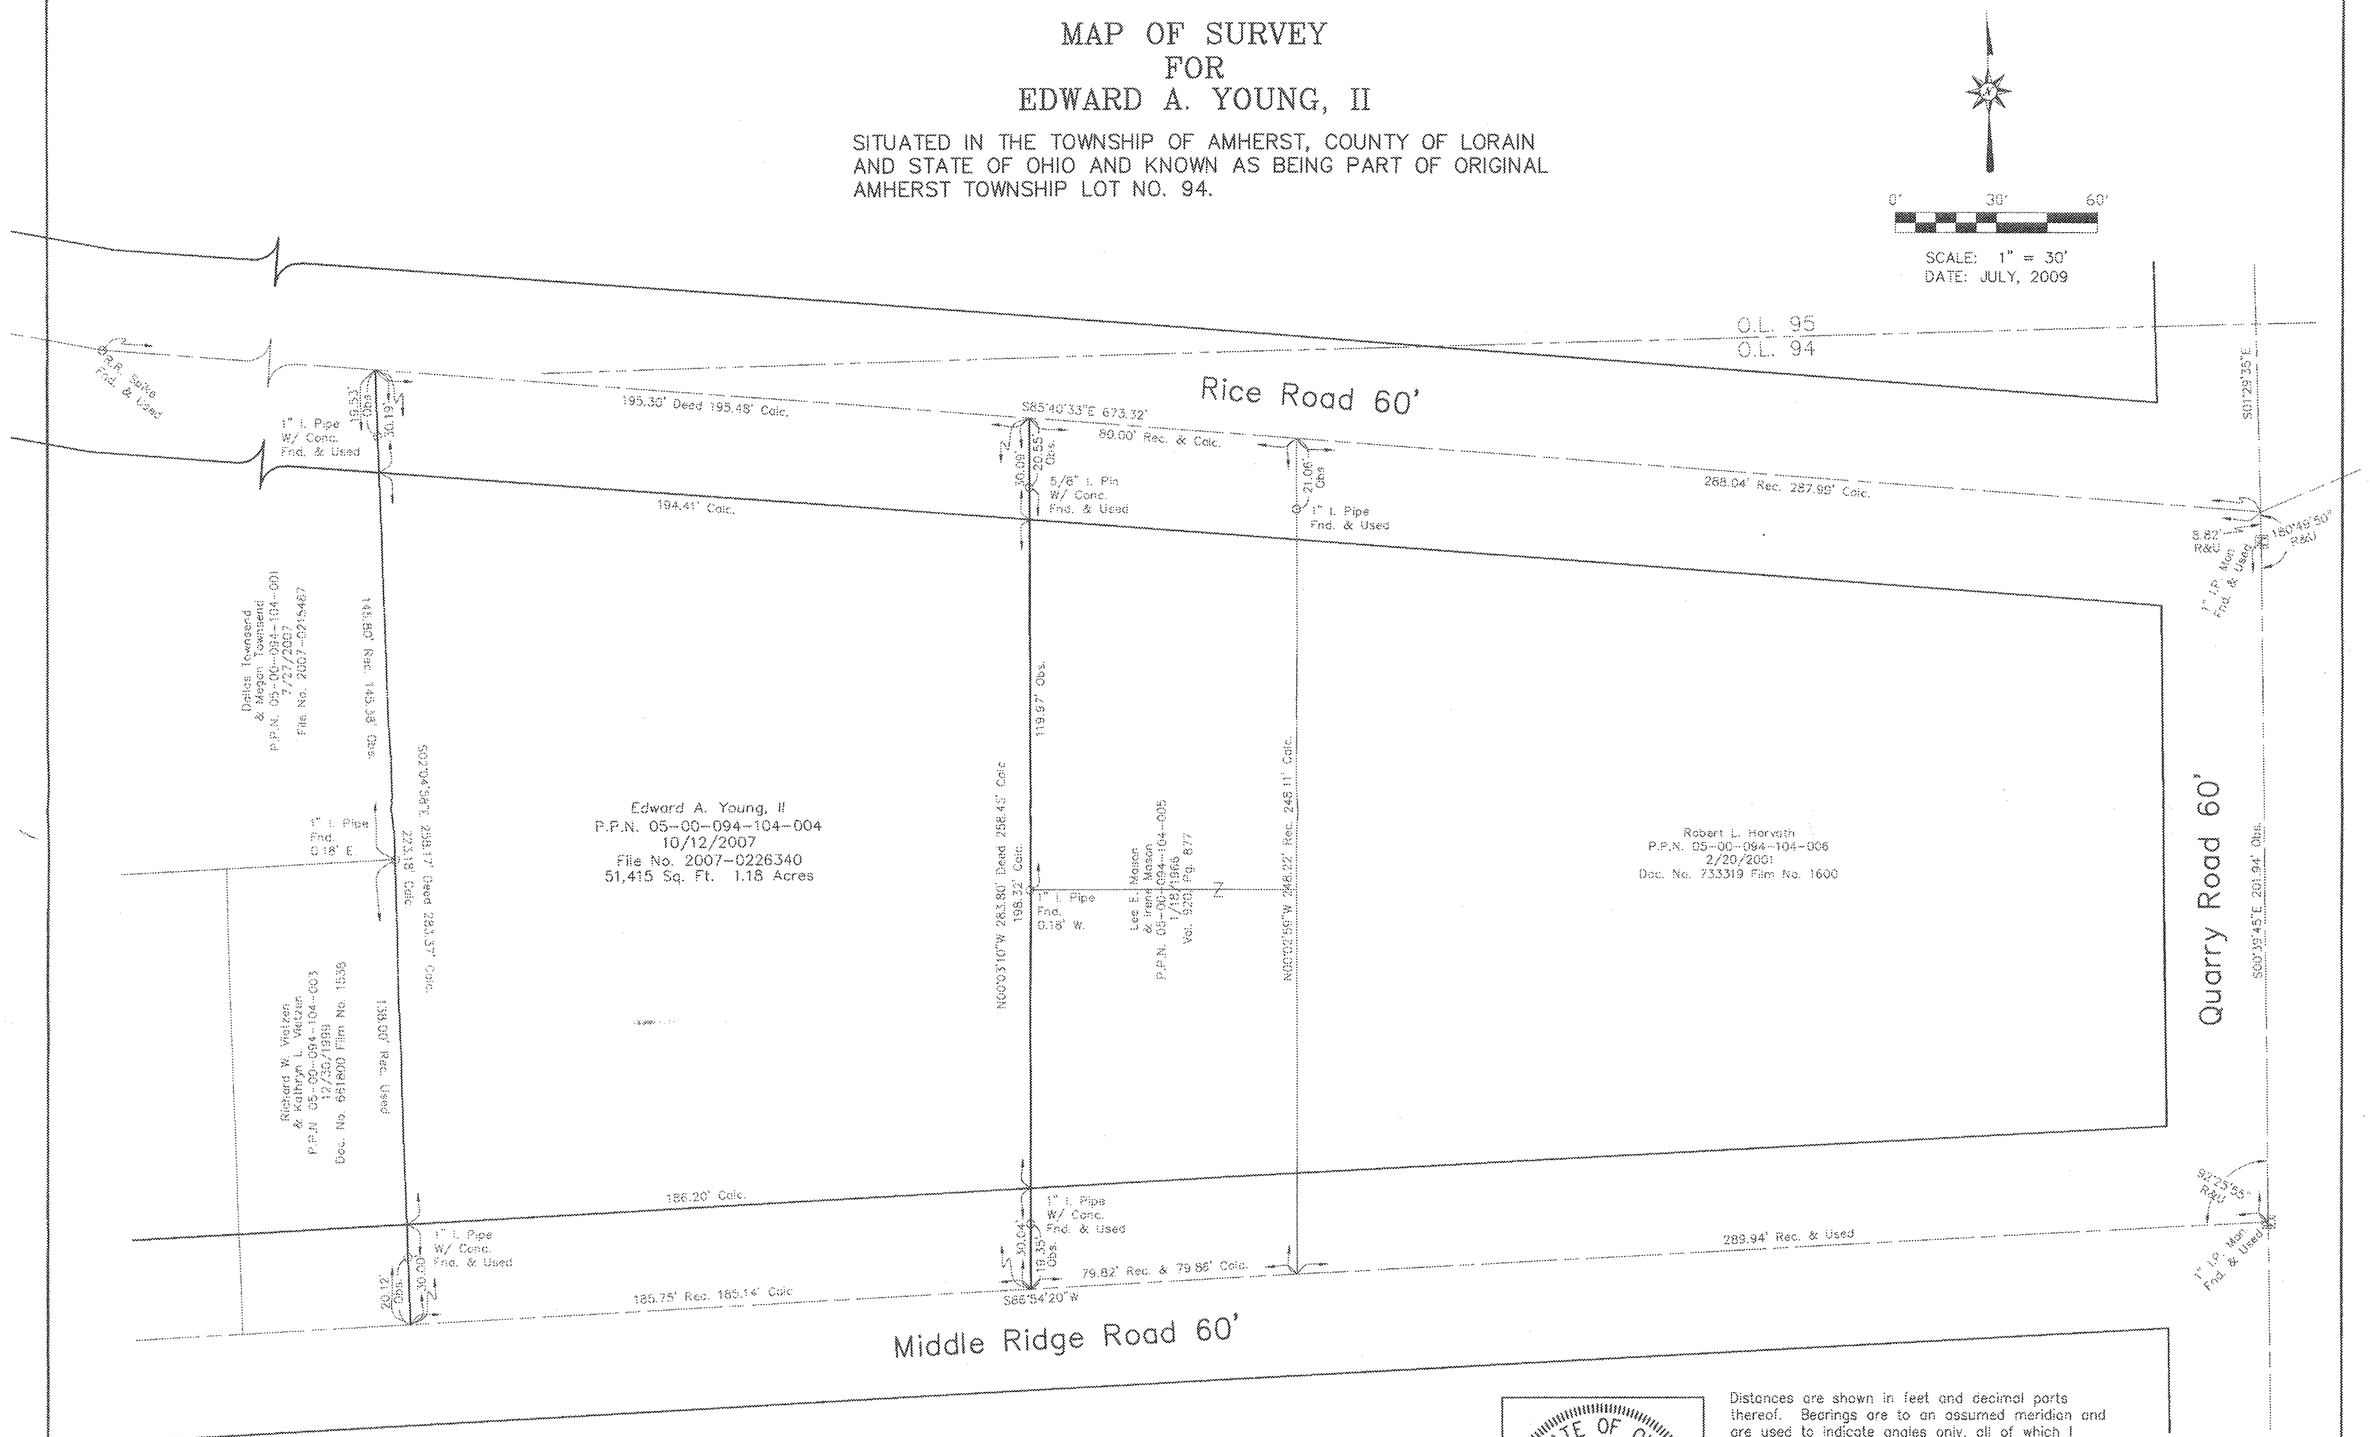

STATE OF OHIO
SEAN A. BOLAND
S-7699
REGISTERED
PROFESSIONAL SURVEYOR

Distances are shown in feet and decimal parts thereof. Bearings are to an assumed meridian and are used to indicate angles only, all of which I believe to be correct.

Sean A. Boland, P.S. #7699
Boland & O'Donnell Surveys L.L.C.

MEMBER PLSO

Professional Land Surveyors
28360 Lansing Dr.
Westlake, Ohio 44145

Sean A. Boland, P.S. (440) 785-2943
Joseph F. O'Donnell, Jr. P.S. (440) 655-8602

#09-01875-D

APPROVED
LORAIN CO.
MAP DEPT

DATE 8/22/09
PAGE 5-00-094
BY D Holland