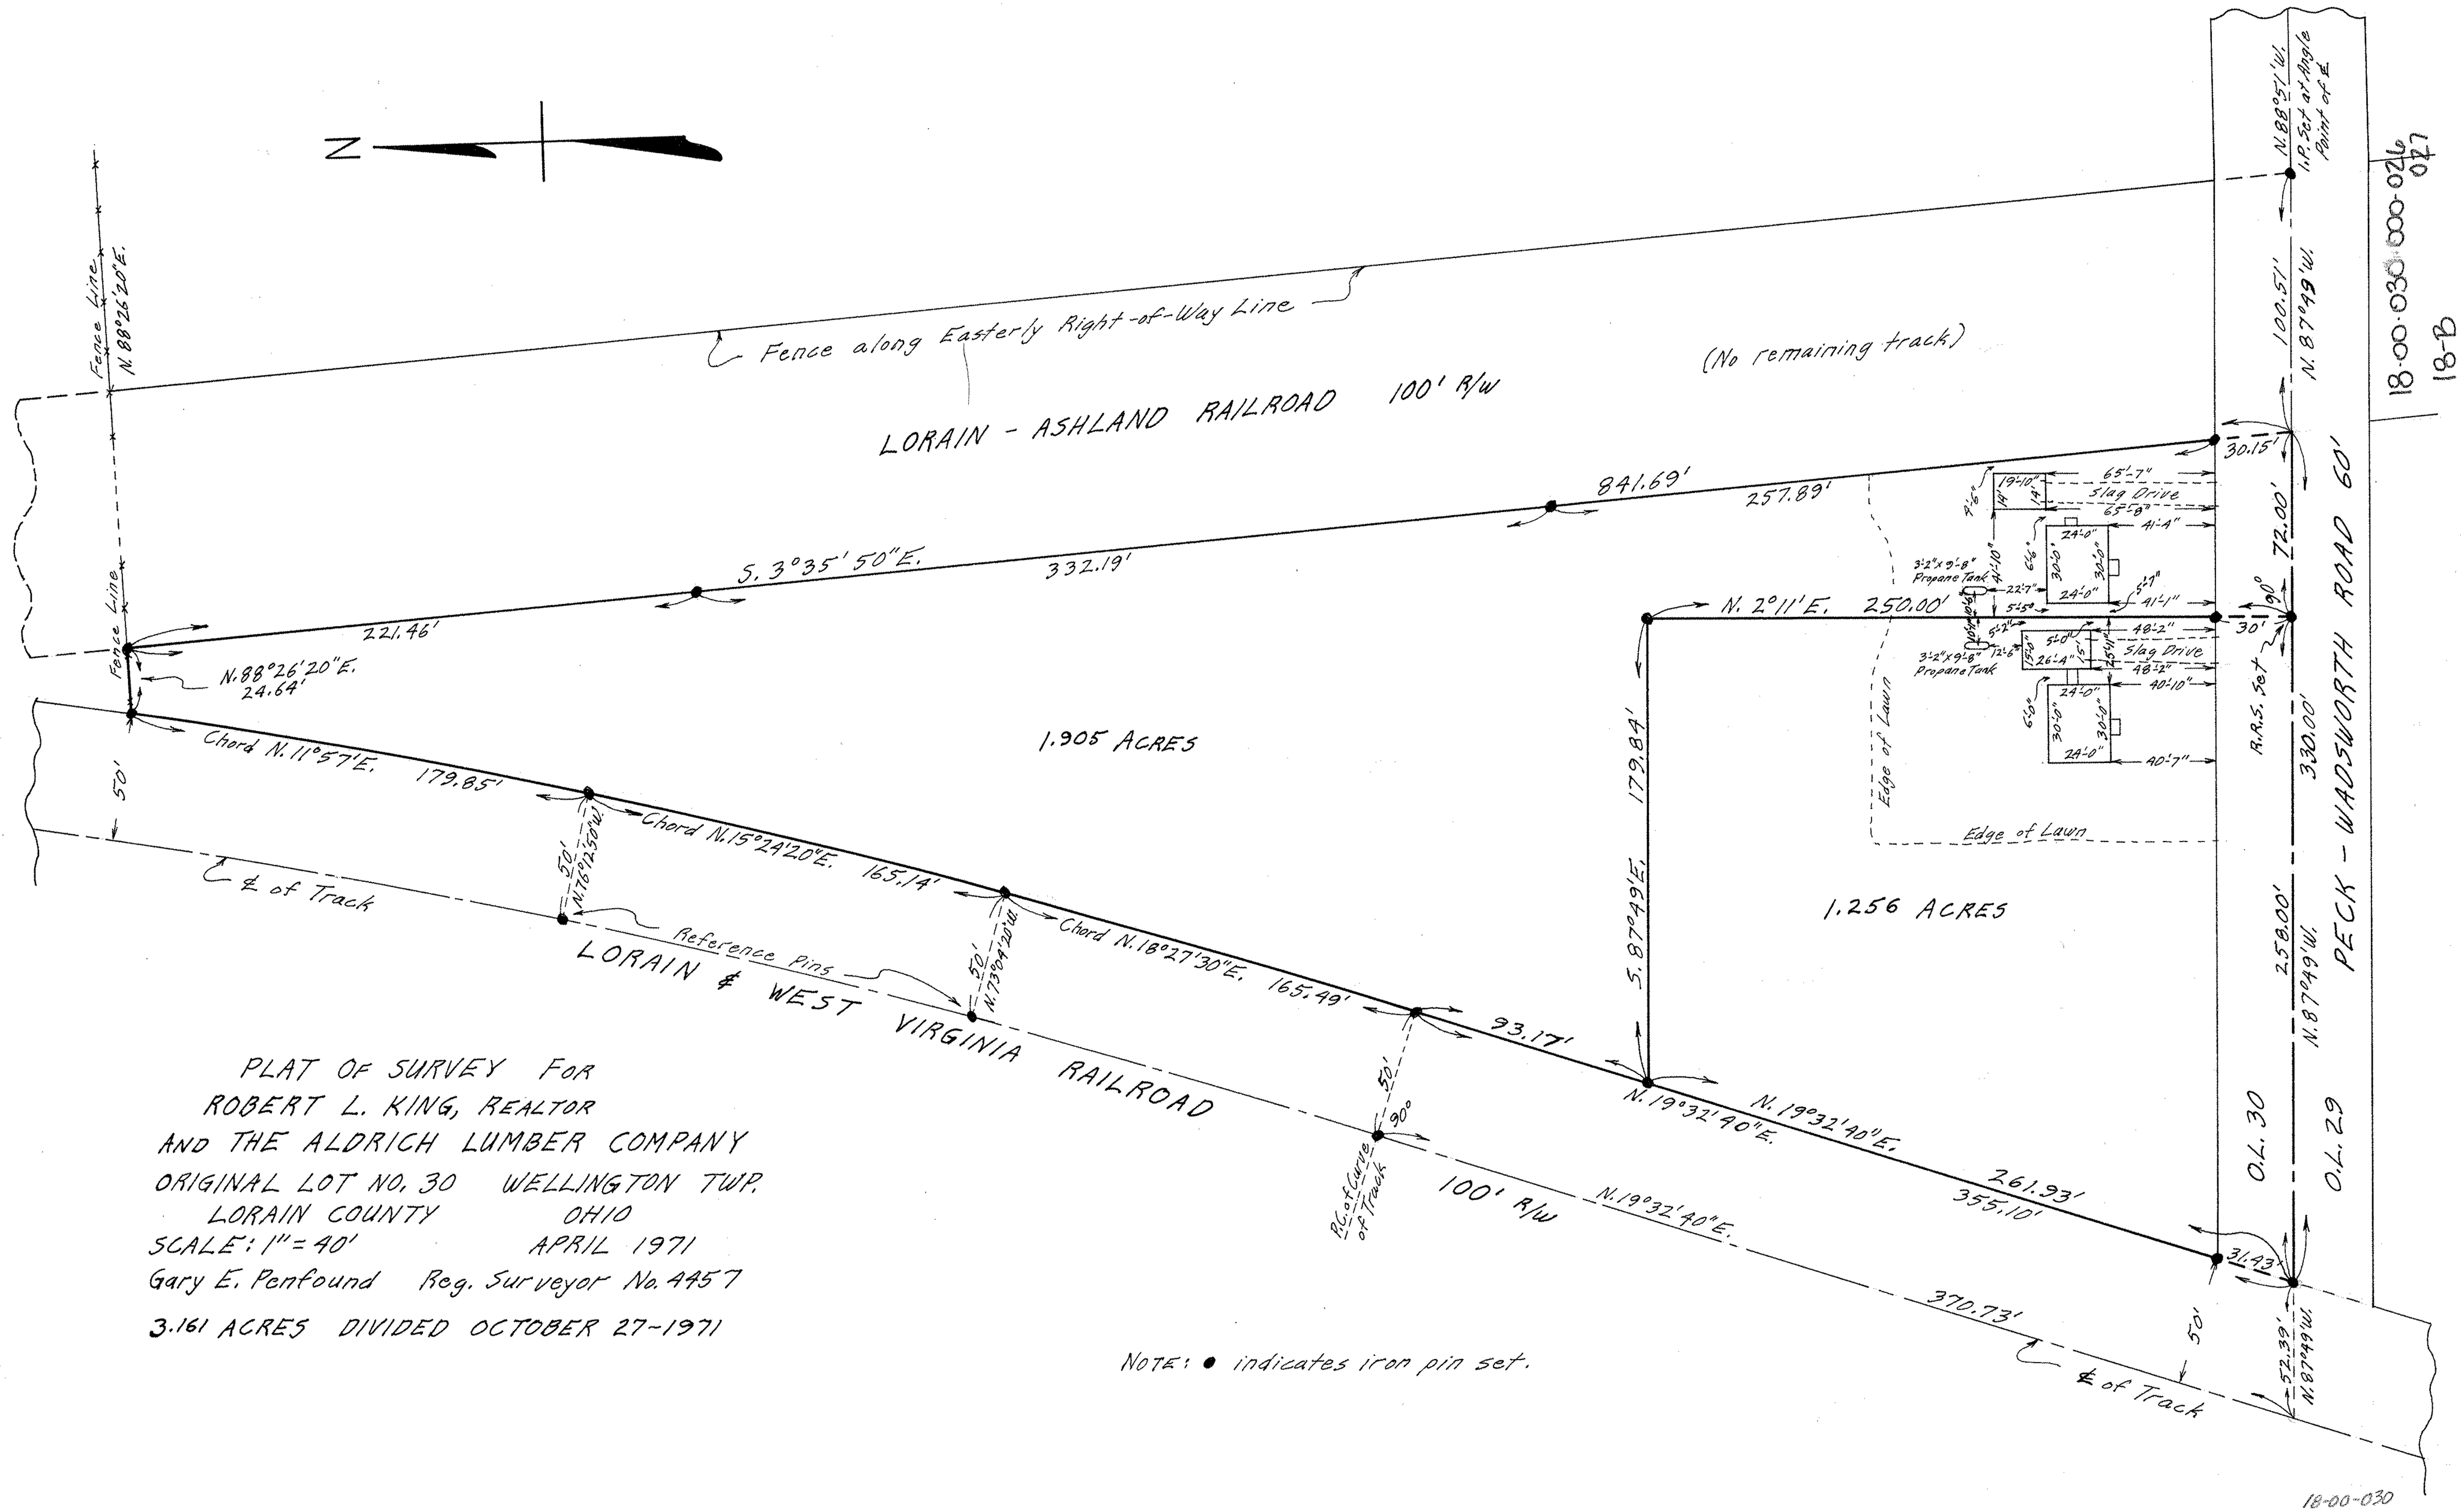

PLAT OF SURVEY FOR
ROBERT L. KING, REALTOR
AND THE ALDRICH LUMBER COMPANY
ORIGINAL LOT NO. 30 WELLINGTON TWP.
LORAIN COUNTY OHIO
SCALE: 1" = 40' APRIL 1971
Gary E. Penfound Reg. Surveyor No. 4457
3.161 ACRES DIVIDED OCTOBER 27-1971

NOTE: ● indicates iron pin set.

18-00-030-000-026
027
18-B

18-00-030