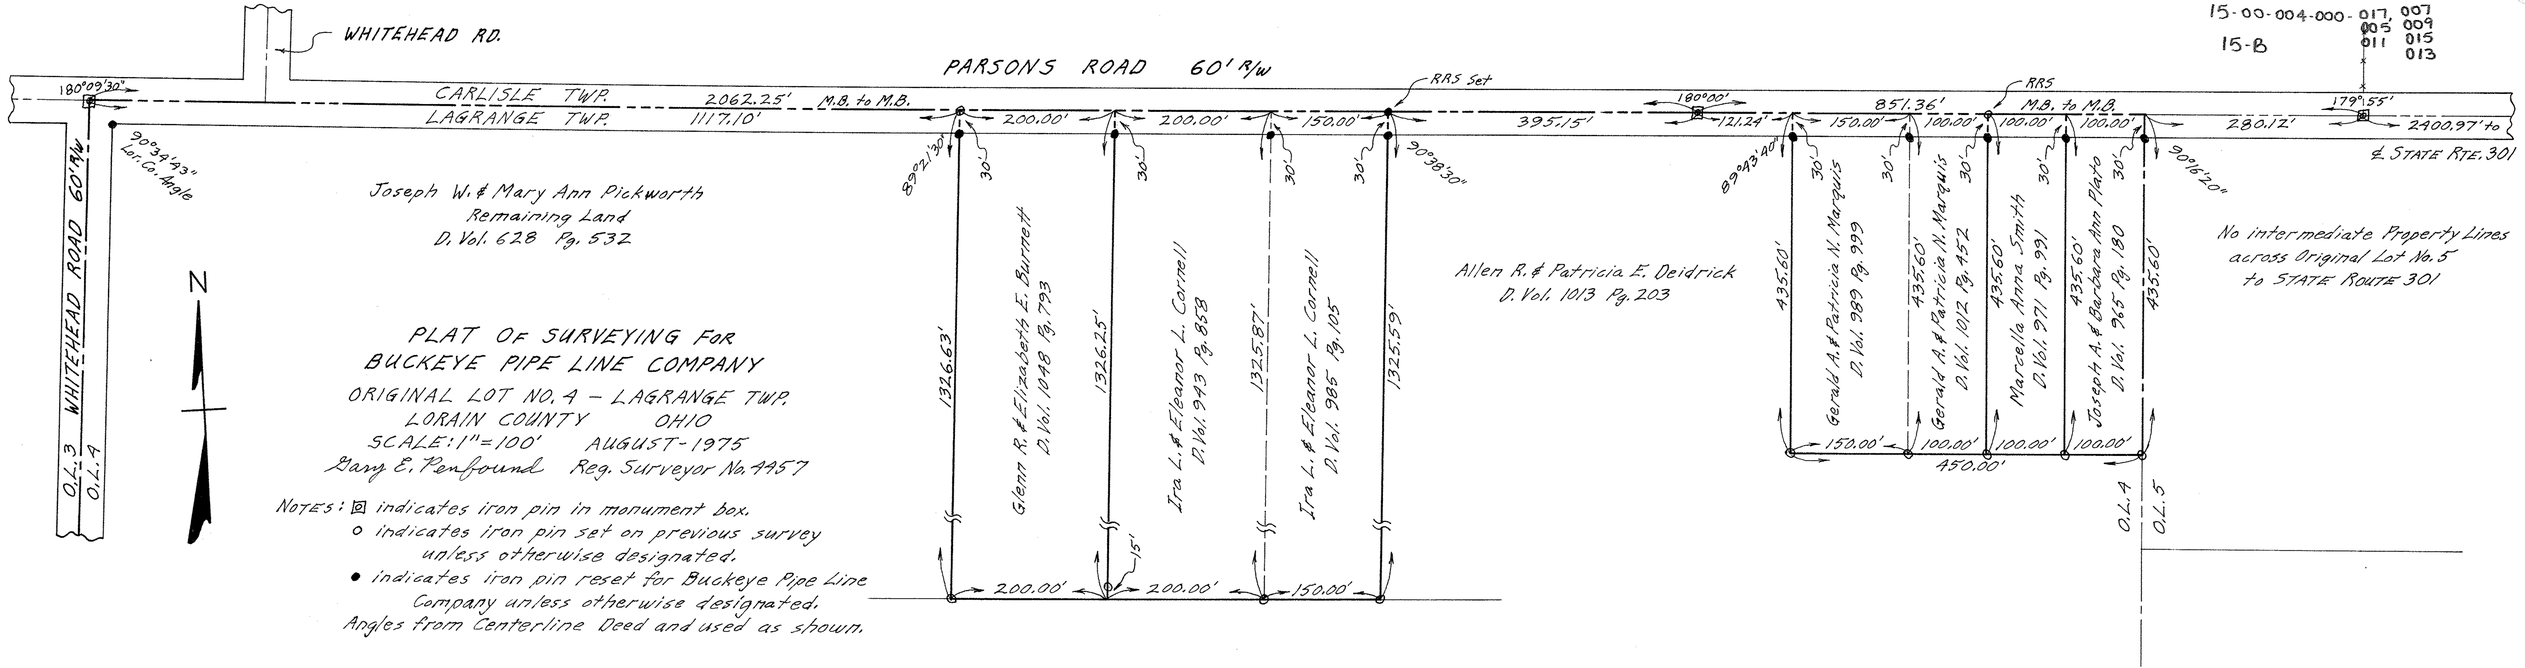
WHITEHEAD RD.
PARSON'S ROAD 60' R/W
15-00-004-000-017, 007, 005, 009, 011, 015, 013
15-B
180°09'30"
CARLISLE TWP.
LAGRANGE TWP.
2062.25'
1117.10'
M.B. to M.B.
RR5 Set
200.00'
200.00'
150.00'
395.15'
180°00'
121.24'
851.36'
RR5
M.B. to M.B.
179°55'
150.00'
100.00'
100.00'
100.00'
280.12'
2400.97' to
℄ STATE RTE. 301
90°39'43" Lot. Co. Angle
WHITEHEAD ROAD 60' R/W
O.L. 3
O.L. 4
N
Joseph W. & Mary Ann Pickworth
Remaining Land
D. Vol. 628 Pg. 532
89°21'30"
30'
90°38'30"
89°43'40"
90°16'20"
Glenn R. & Elizabeth E. Burnett
D. Vol. 1048 Pg. 793
Ira L. & Eleanor L. Cornell
D. Vol. 943 Pg. 858
Ira L. & Eleanor L. Cornell
D. Vol. 985 Pg. 105
Allen R. & Patricia E. Deidrick
D. Vol. 1013 Pg. 203
Gerald A. & Patricia N. Marquis
D. Vol. 989 Pg. 999
Gerald A. & Patricia N. Marquis
D. Vol. 1012 Pg. 452
Marcella Anna Smith
D. Vol. 971 Pg. 991
Joseph A. & Barbara Ann Plato
D. Vol. 965 Pg. 180
435.60'
1326.63'
1326.25'
1325.87'
1325.59'
15'
200.00'
200.00'
150.00'
150.00'
100.00'
100.00'
100.00'
450.00'
O.L. 4
O.L. 5
No intermediate Property Lines
across Original Lot No. 5
to STATE ROUTE 301
PLAT OF SURVEYING FOR
BUCKEYE PIPE LINE COMPANY
ORIGINAL LOT NO. 4 – LAGRANGE TWP.
LORAIN COUNTY OHIO
SCALE: 1" = 100' AUGUST - 1975
Gary E. Penfound Reg. Surveyor No. 4957
NOTES: ⊡ indicates iron pin in monument box.
o indicates iron pin set on previous survey unless otherwise designated.
• indicates iron pin reset for Buckeye Pipe Line Company unless otherwise designated.
Angles from Centerline Deed and used as shown.