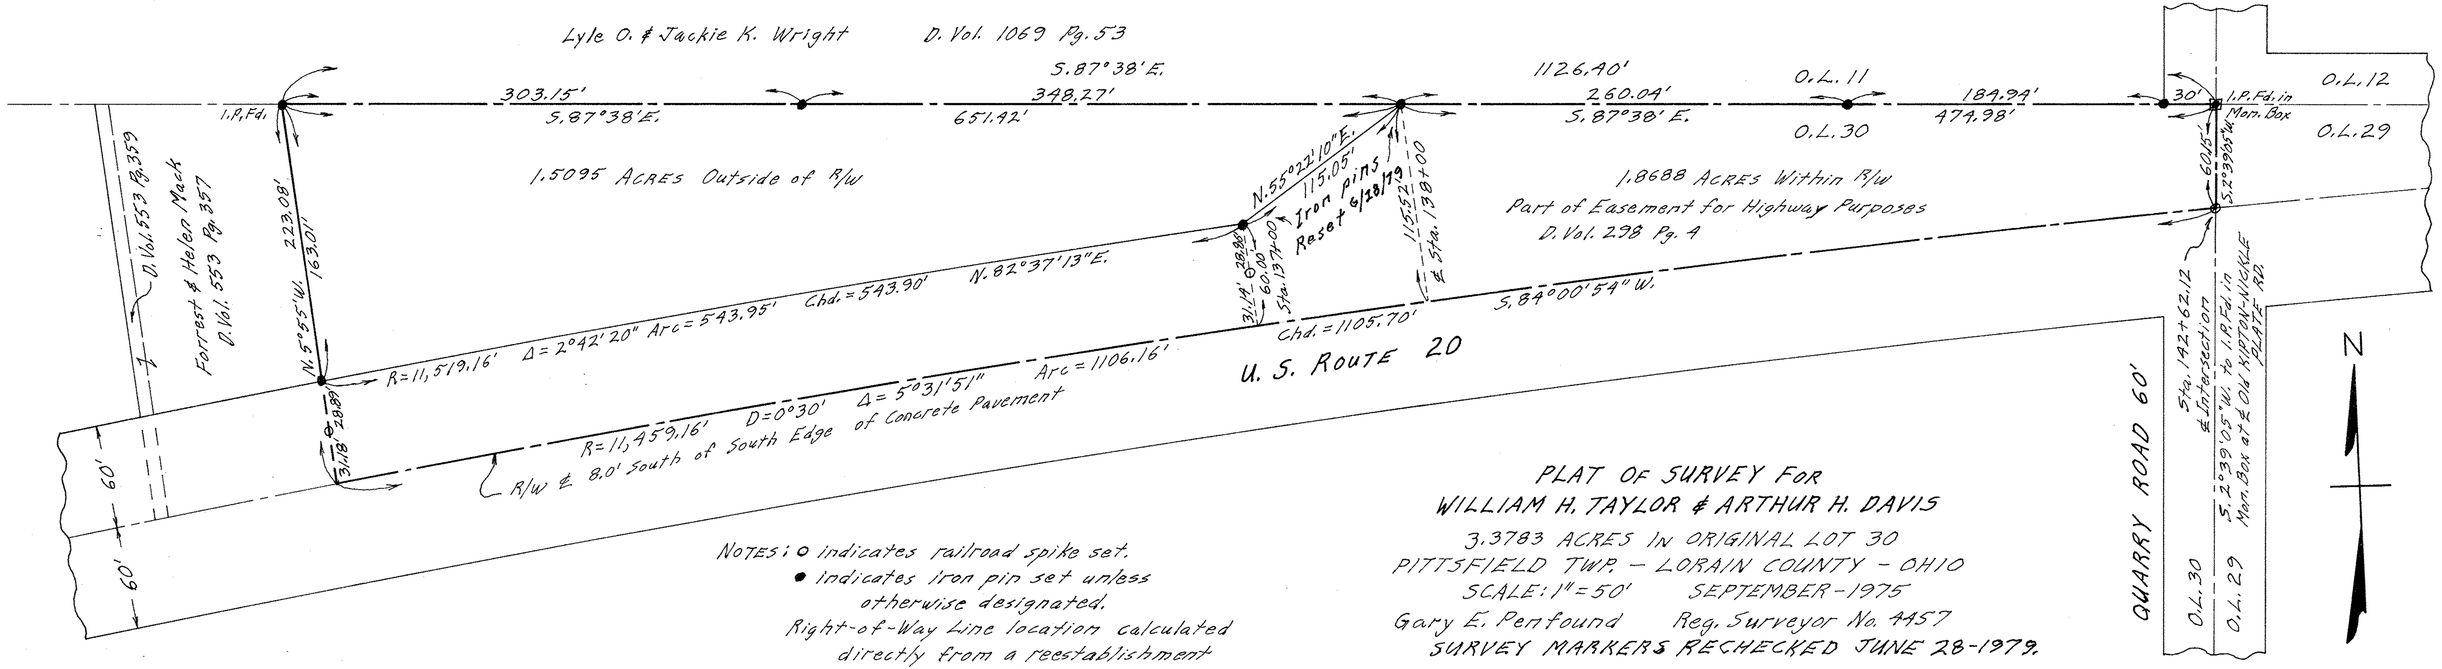

PLAT OF SURVEY FOR
WILLIAM H. TAYLOR & ARTHUR H. DAVIS
3.3783 ACRES IN ORIGINAL LOT 30
PITTSFIELD TWP. – LORAIN COUNTY – OHIO
SCALE: 1" = 50' SEPTEMBER – 1975
Gary E. Penfound Reg. Surveyor No. 4457
SURVEY MARKERS RECHECKED JUNE 28-1979.

NOTES: ○ indicates railroad spike set.
● indicates iron pin set unless otherwise designated.
Right-of-Way Line location calculated directly from a reestablishment of centerline stationing. (Measurements found in Vol. 298 Pg. 4 are incorrect.)

14-00-030-000-044
007
029
030
005

14-A

14-00-030