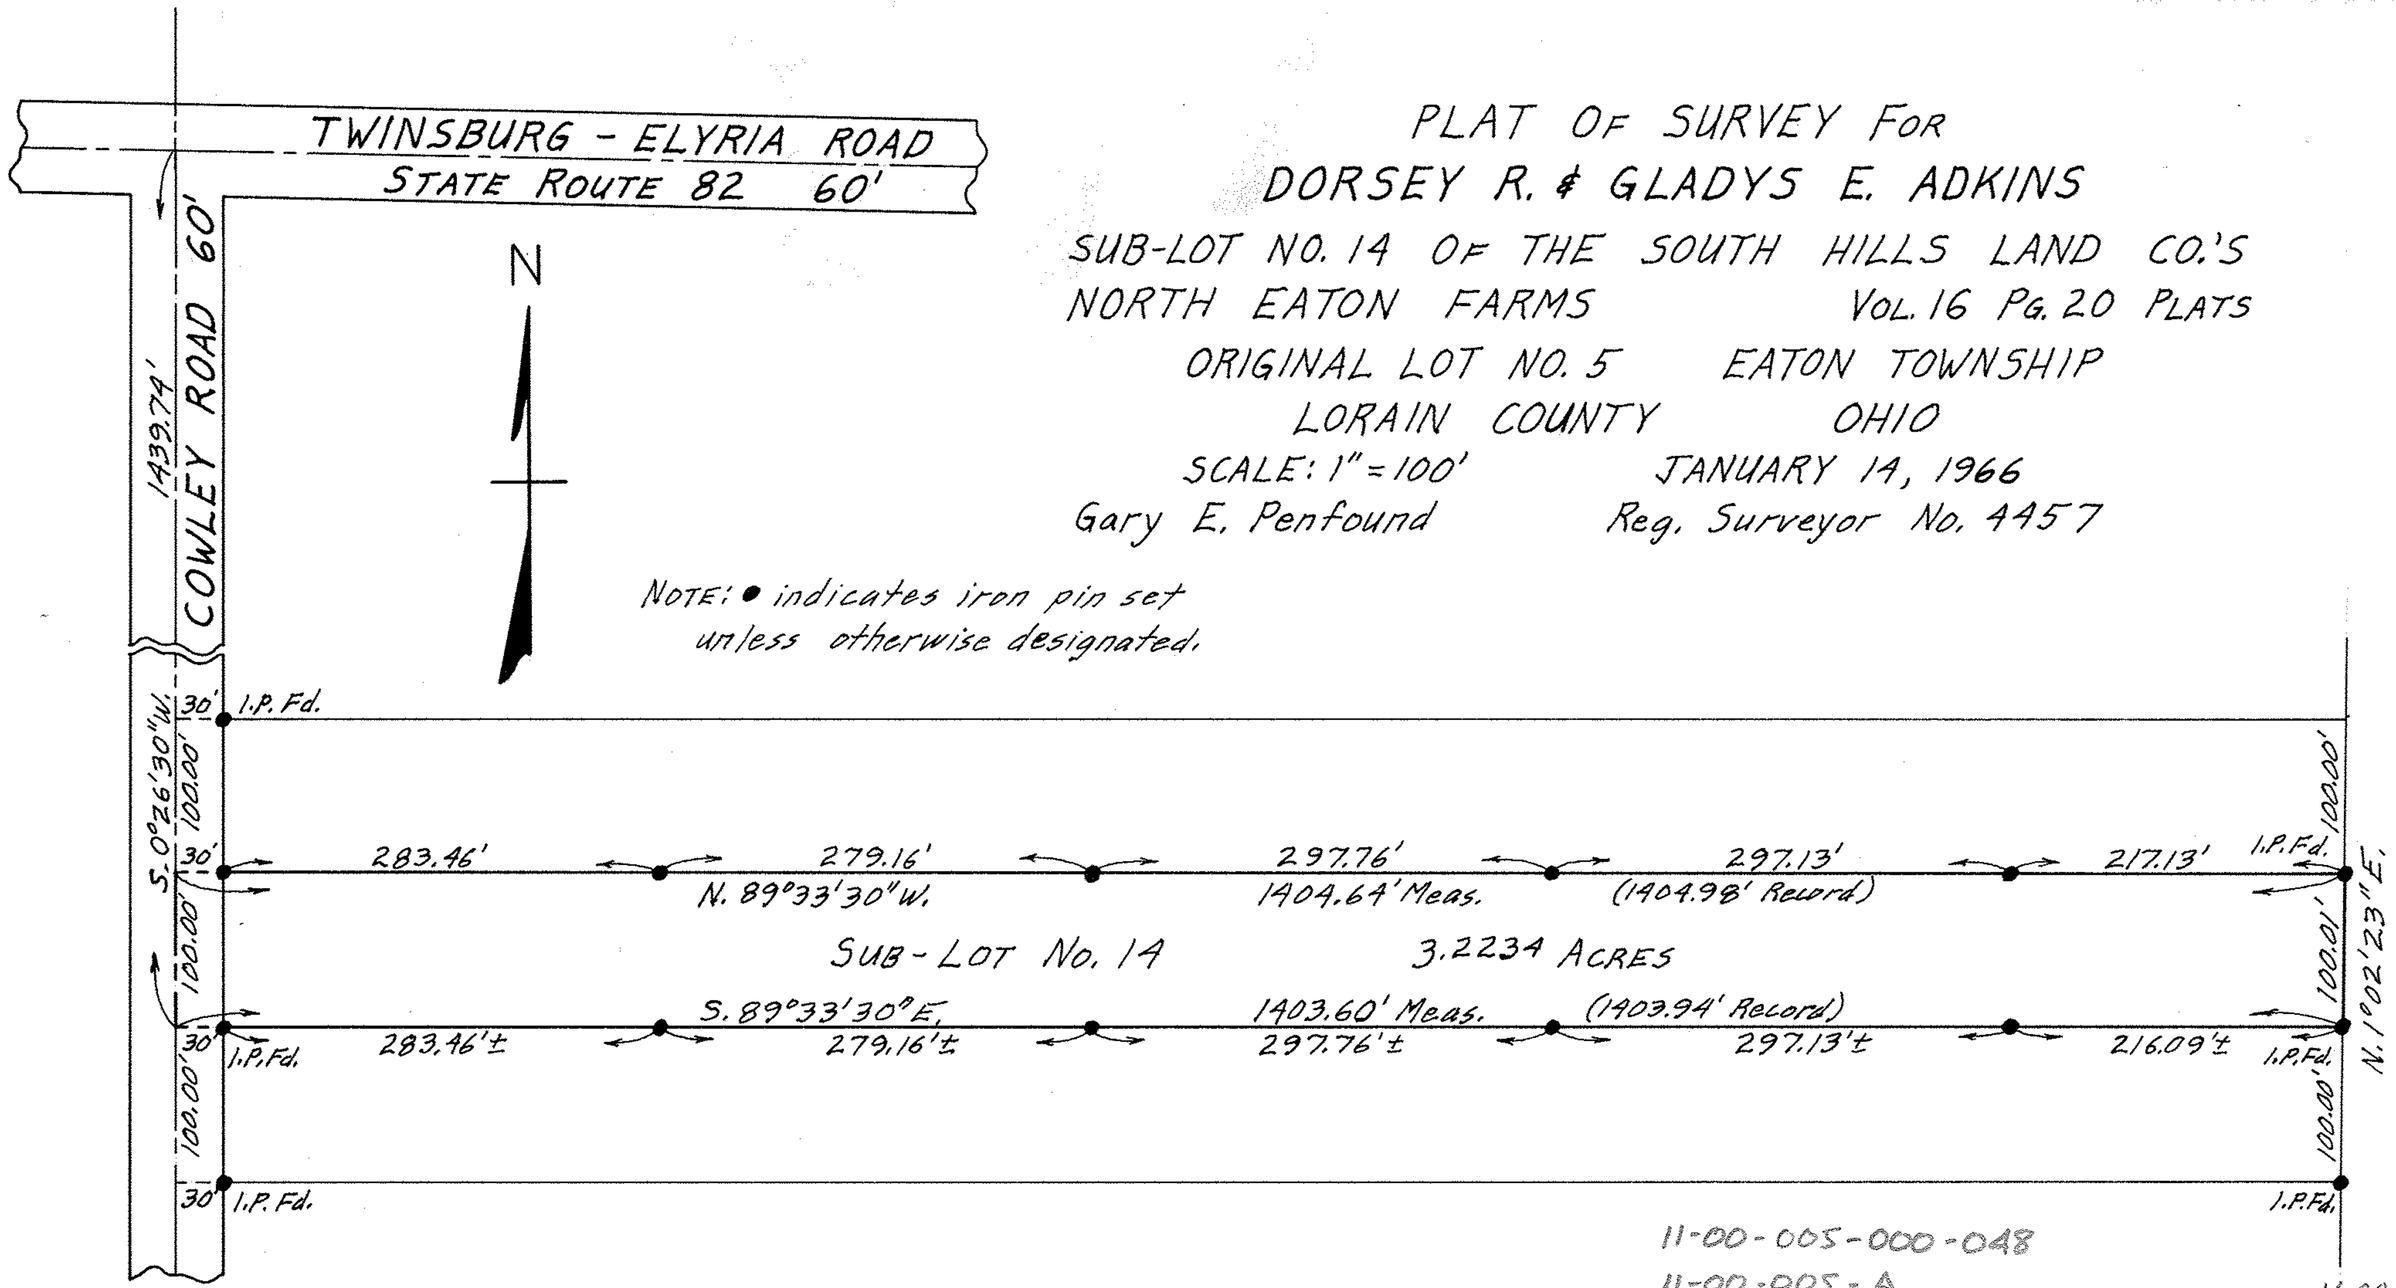

PLAT OF SURVEY FOR
DORSEY R. & GLADYS E. ADKINS

SUB-LOT NO. 14 OF THE SOUTH HILLS LAND CO.'S
NORTH EATON FARMS VOL. 16 PG. 20 PLATS
ORIGINAL LOT NO. 5 EATON TOWNSHIP
LORAIN COUNTY OHIO
SCALE: 1" = 100' JANUARY 14, 1966
Gary E. Penfound Reg. Surveyor No. 4457

NOTE: ● indicates iron pin set
unless otherwise designated.

11-00-005-000-048
11-00-005-A

11-00-005