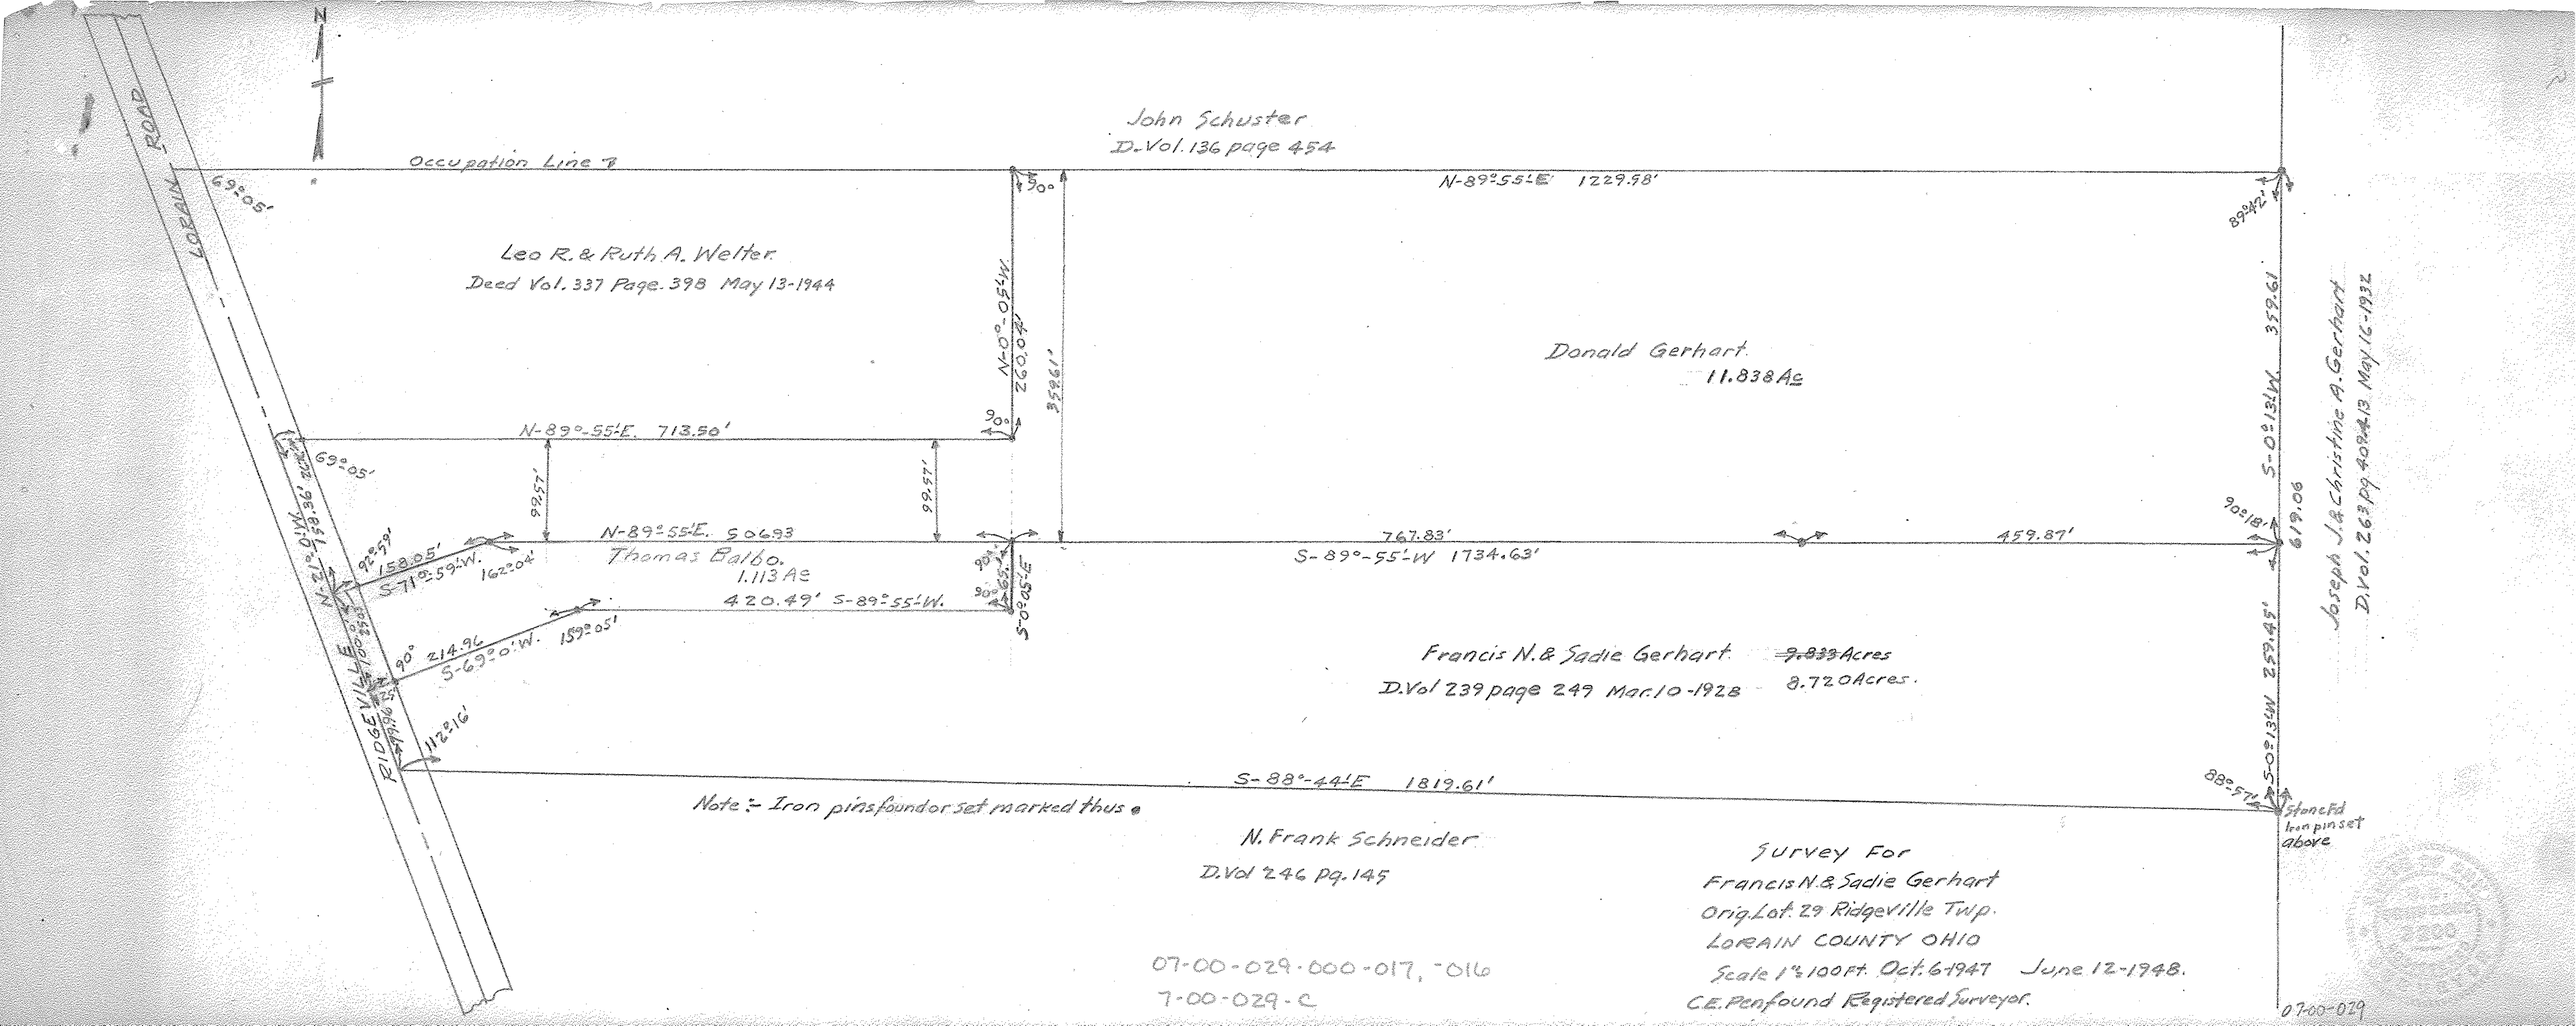
N
LORAIN ROAD
RIDGE VILLE
John Schuster
D. Vol. 136 page 454
Occupation Line
N-89°-55'-E 1229.98'
89°-42'
69°-05'
Leo R. & Ruth A. Welter
Deed Vol. 337 Page. 398 May 13-1944
90°
N-0°-05'W.
260.04'
359.61'
Donald Gerhart
11.838 Ac
N-89°-55'E. 713.50'
69°-05'
99.57'
99.57'
N-89°-55'E. 506.93
767.83'
459.87'
S-89°-55'-W 1734.63'
90°-18'
S-0°-13'W. 359.61
619.06
92°-59'
158.05'
S-71°-59'-W.
162°-04'
Thomas Balbo.
1.113 Ac
420.49' S-89°-55'-W.
90°
S-0°-05'-E
214.96
S-69°-0'-W. 159°-05'
90° 214.96
112.16'
Francis N. & Sadie Gerhart
~~9.833 Acres~~
8.720 Acres.
D.Vol 239 page 249 Mar. 10-1928
S-88°-44'E 1819.61'
88°-57'
S-0°-13'W 259.45'
Joseph J. & Christine A. Gerhart
D.Vol. 263 pg 408 4.13 May 16-1932
Stone Fd
Iron pin set
above
Note :- Iron pins found or set marked thus •
N. Frank Schneider
D.Vol 246 pg. 145
Survey For
Francis N. & Sadie Gerhart
Orig. Lot. 29 Ridgeville Twp.
LORAIN COUNTY OHIO
Scale 1" = 100 Ft. Oct. 6-1947 June 12-1948.
C.E. Penfound Registered Surveyor.
07-00-029-000-017, -016
7-00-029-C
07-00-029