



05-00-014-B
 05-00-014-000-037
 05-00-015-B
 05-00-015-000-020 THRU 028
 05-00-026-A
 05-00-026-102-031

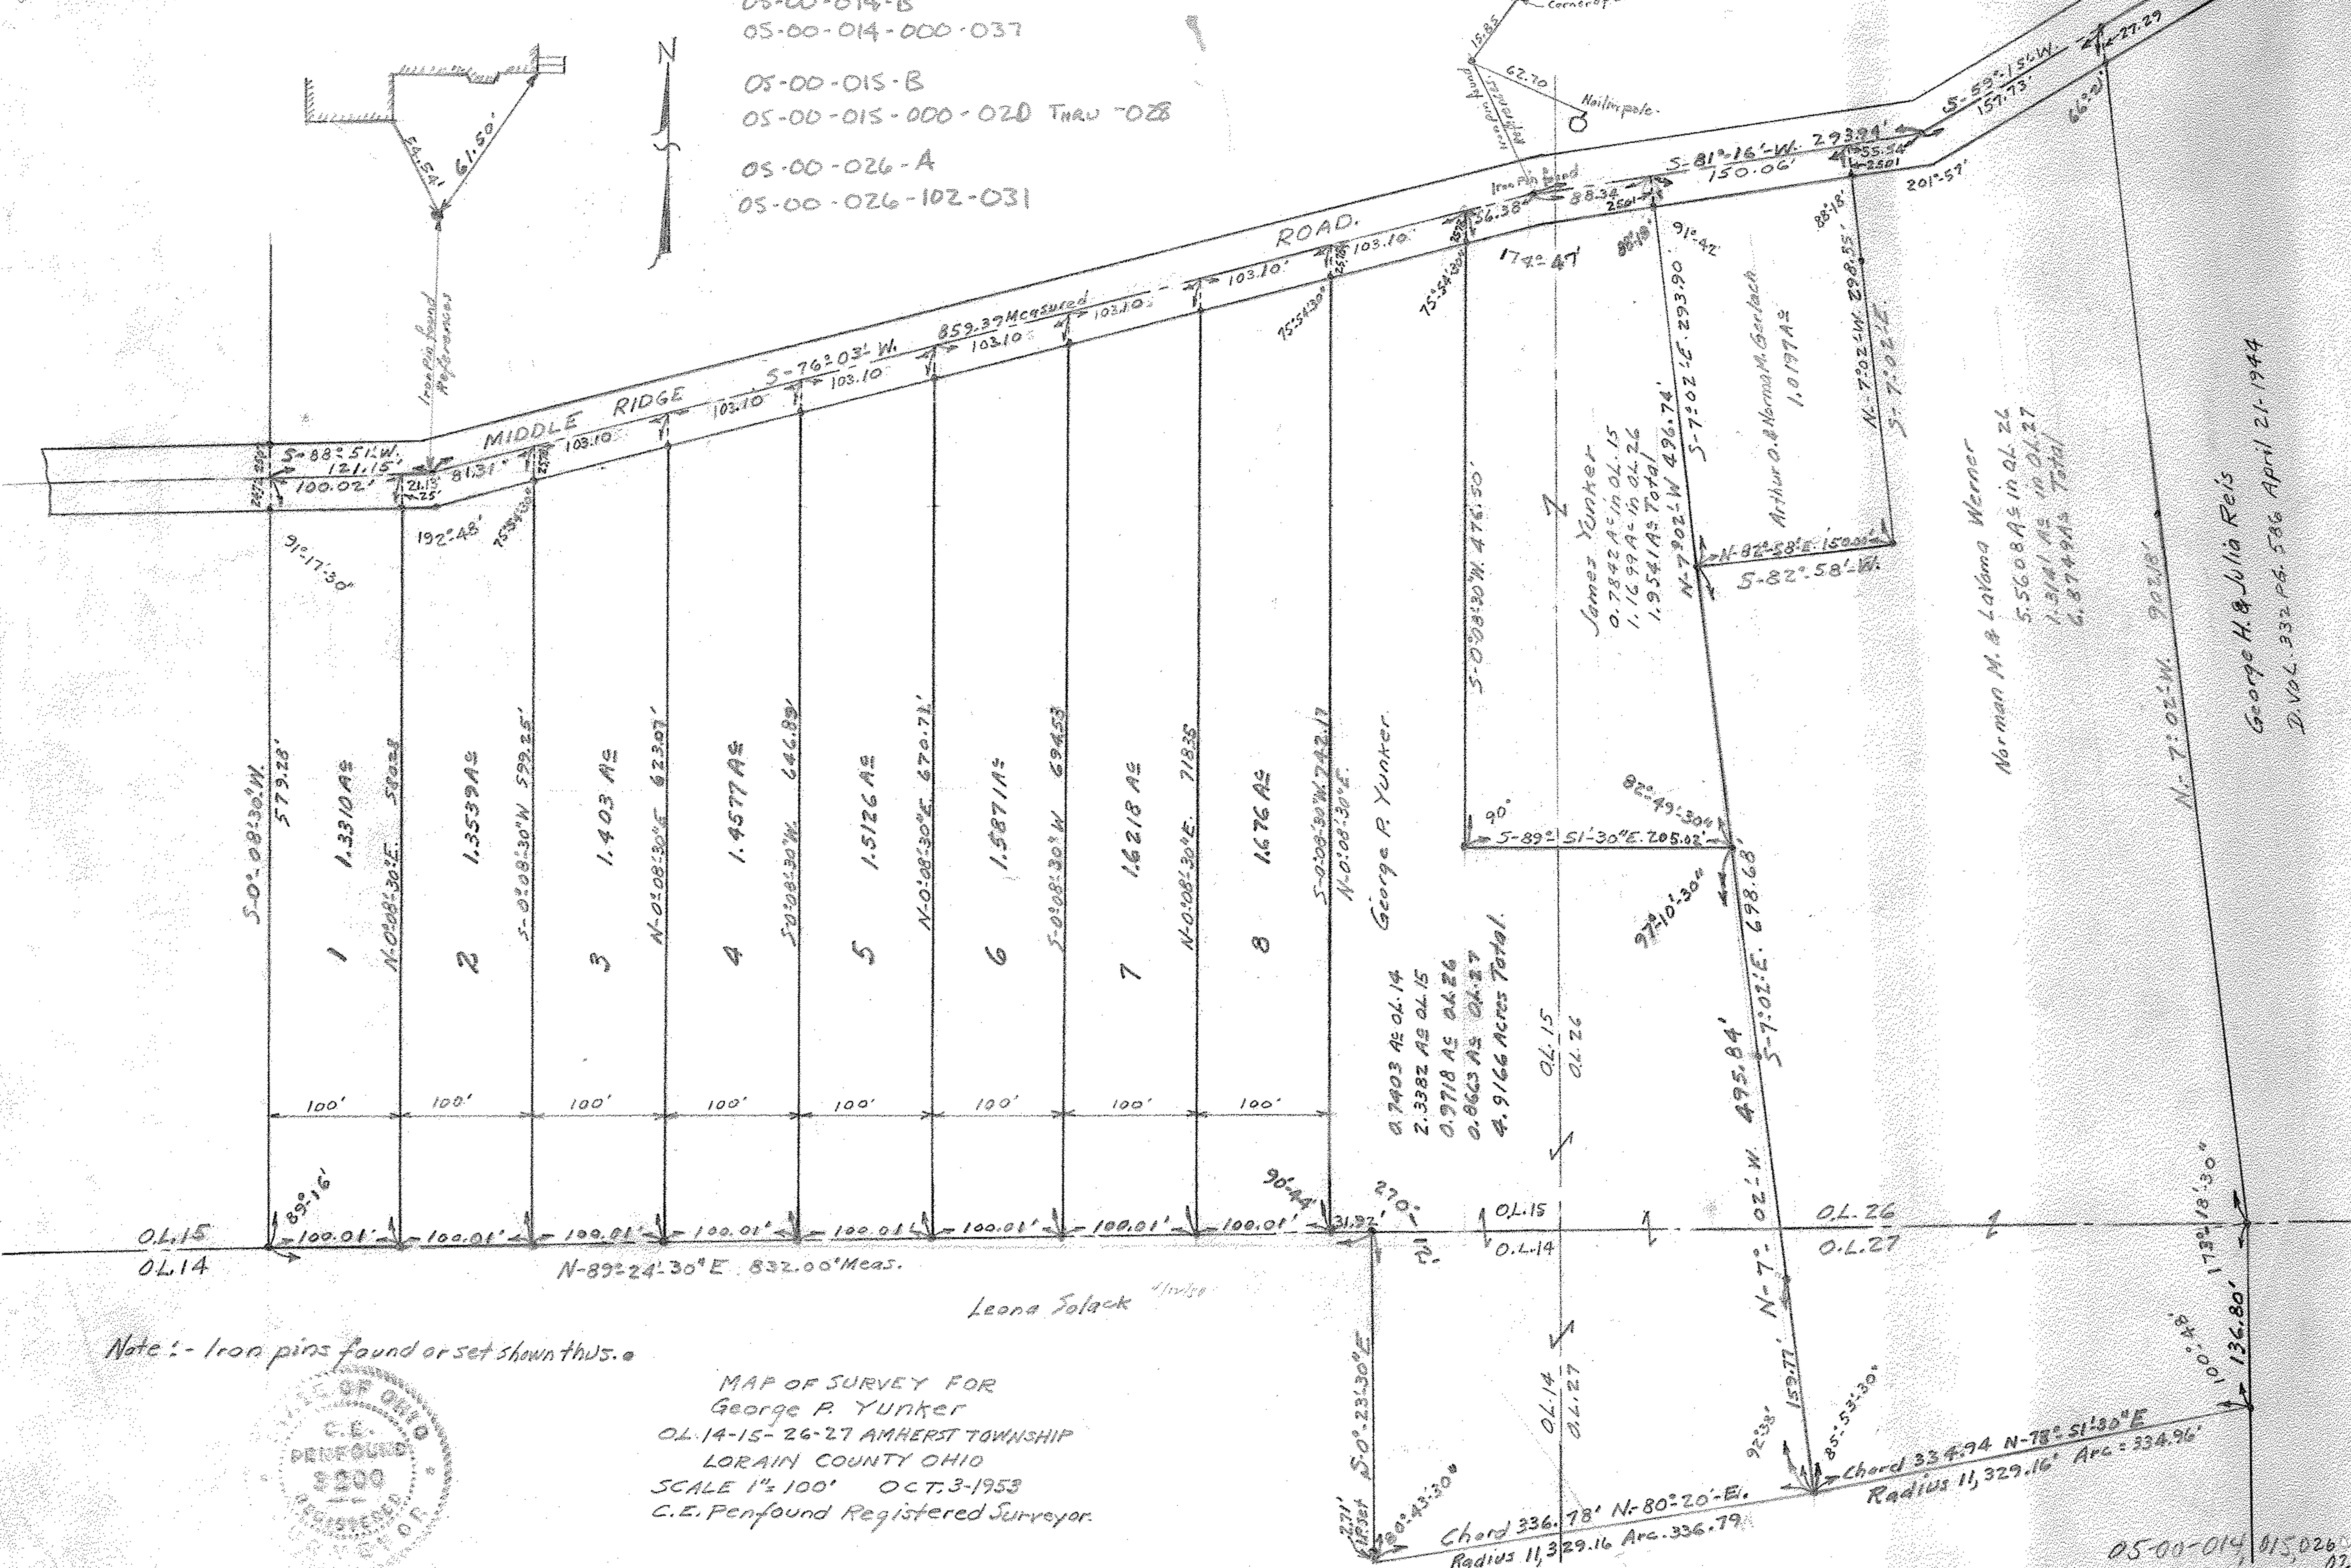

Note :- Iron pins found or set shown thus. ●

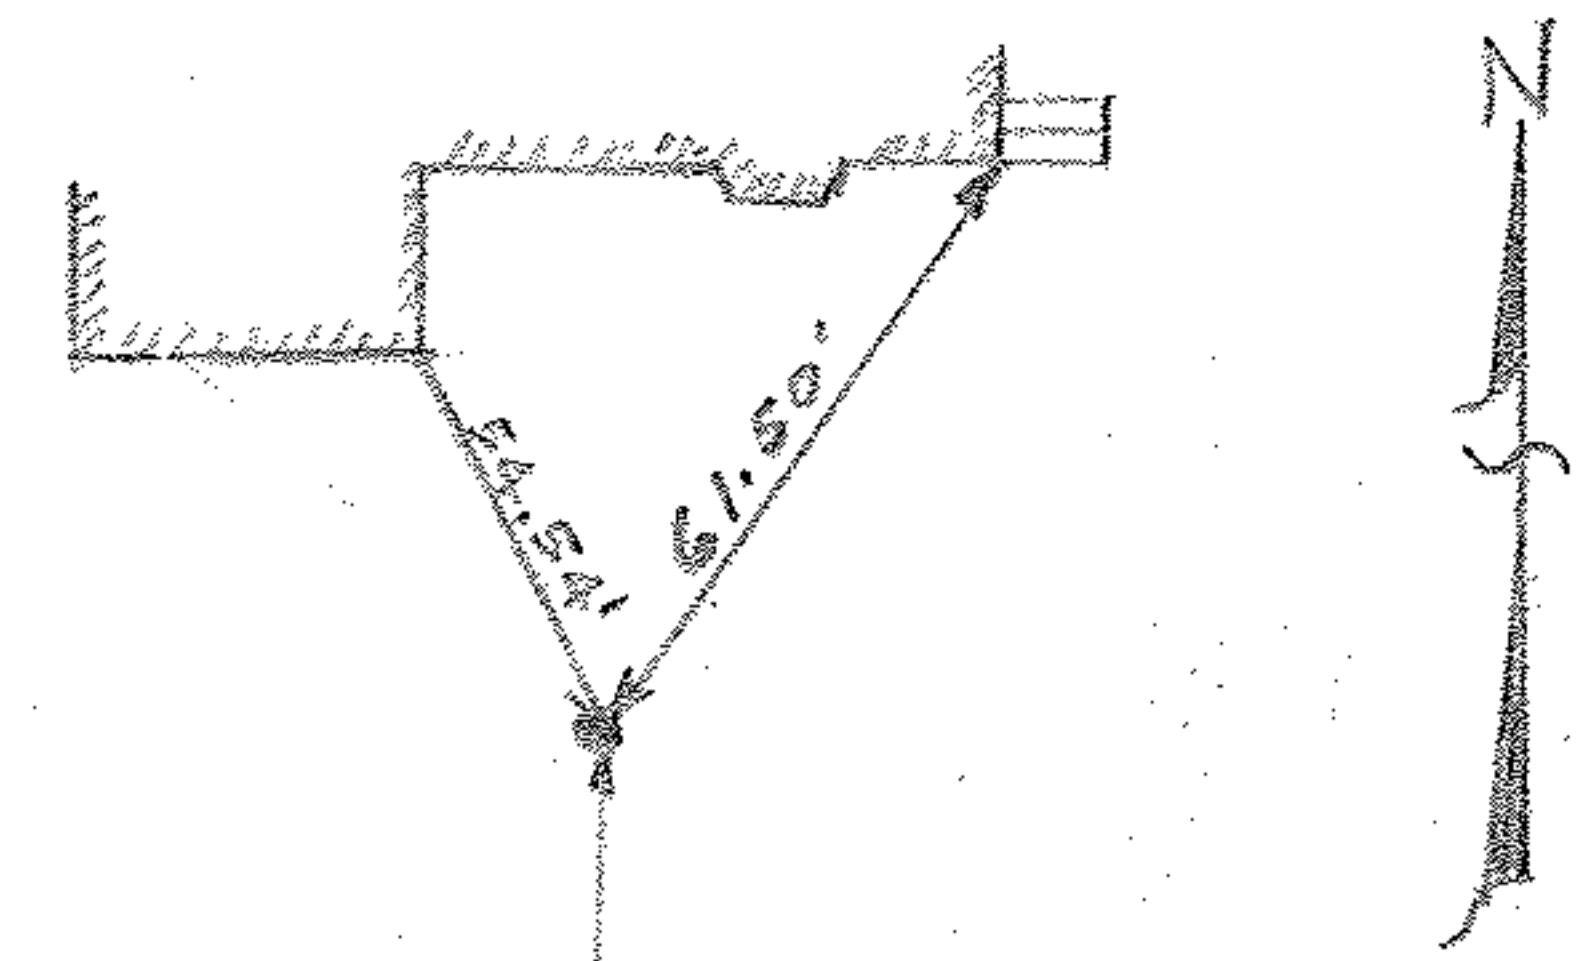

MAP OF SURVEY FOR
 George R. Yunker
 OL. 14-15-26-27 AMHERST TOWNSHIP
 LORAIN COUNTY OHIO
 SCALE 1" = 100' OCT. 3-1953
 C.E. Penfound Registered Surveyor.

Leona Solack

George H. & Julia Reis
 D. Vol. 332 Pg. 586 April 21-1944

05-00-014, 015, 026, 027