PLAT OF SURVEY FOR
JAMES F. HINES

ORIGINAL LOT NO. 78 – EATON TOWNSHIP
LORAIN COUNTY OHIO
SCALE: 1" = 100' FEBRUARY 1969
Gary E. Pentound Reg. Surveyor No. 4457

NOTE: ● indicates iron pin set unless otherwise designated.

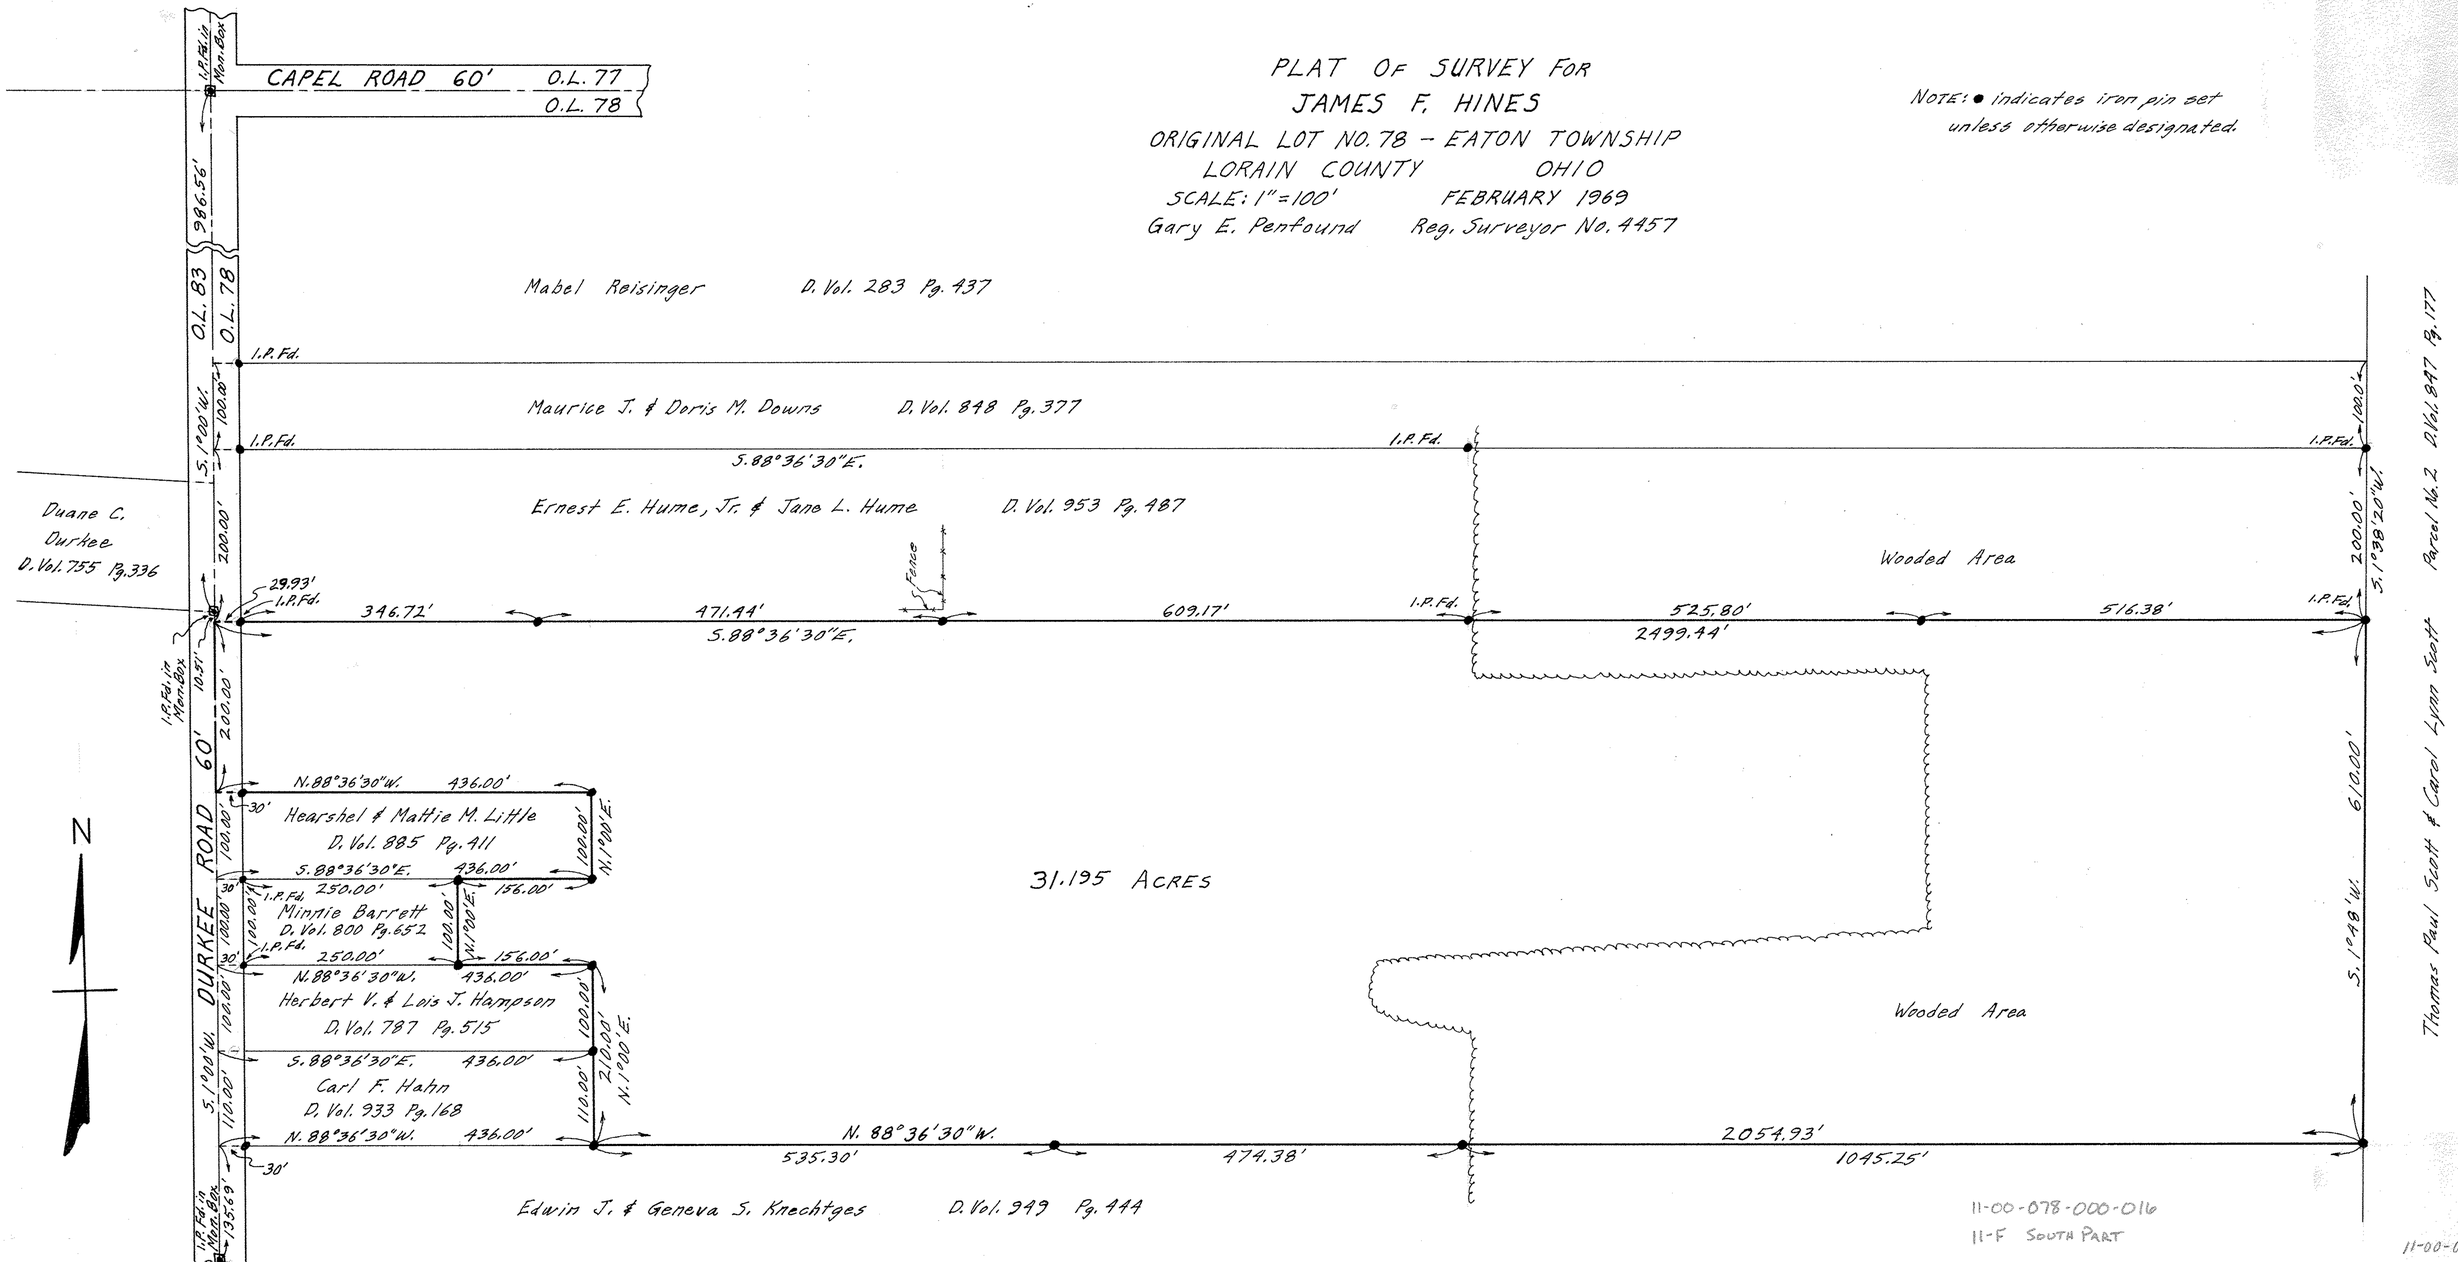

11-00-078-000-016
11-F SOUTH PART

11-00-078