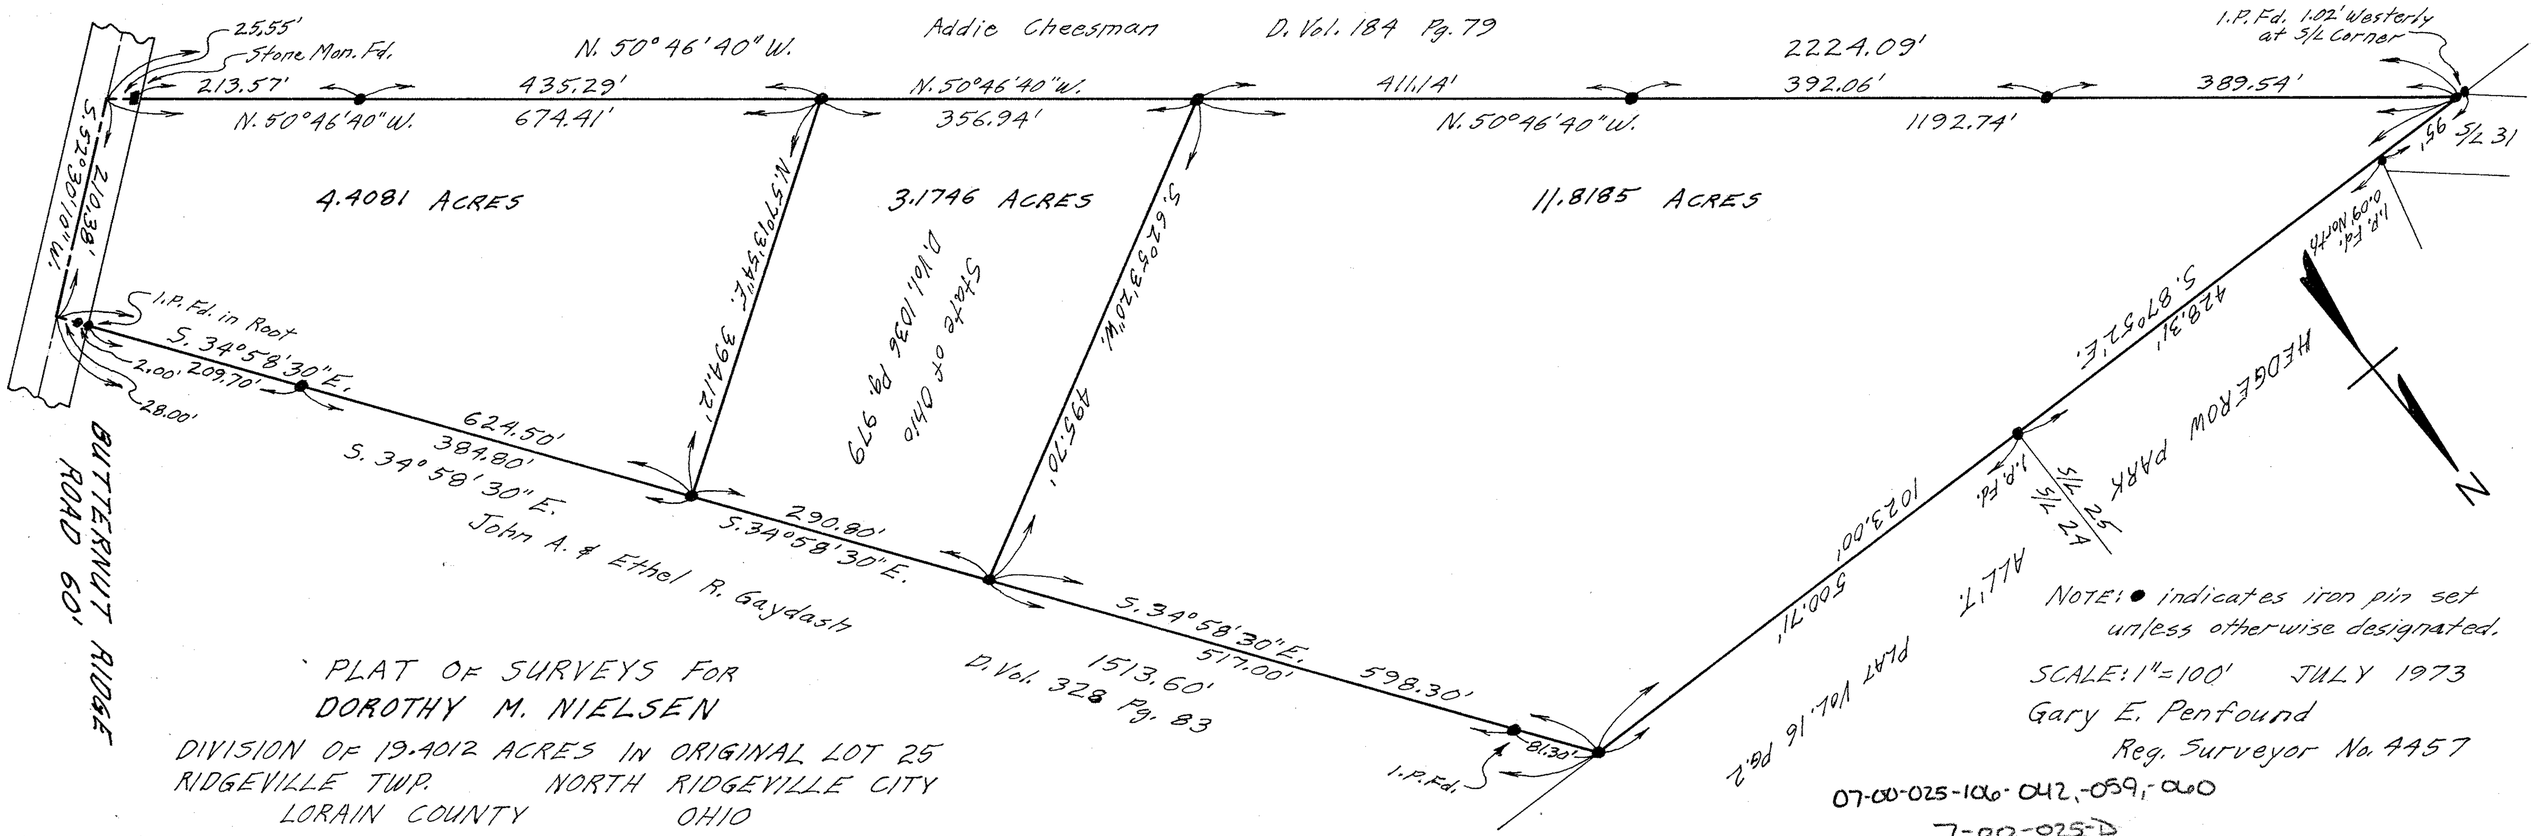

PLAT OF SURVEYS FOR
DOROTHY M. NIELSEN

DIVISION OF 19.4012 ACRES IN ORIGINAL LOT 25
RIDGEVILLE TWP. NORTH RIDGEVILLE CITY
LORAIN COUNTY OHIO

NOTE: ● indicates iron pin set unless otherwise designated.

SCALE: 1" = 100' JULY 1973

Gary E. Penfound
Reg. Surveyor No. 4457

07-00-025-100-042,-059,-060
7-00-025-D

07-00-025