04-00-007-104-026, 045, 044 (7)

024

4-00-007-C

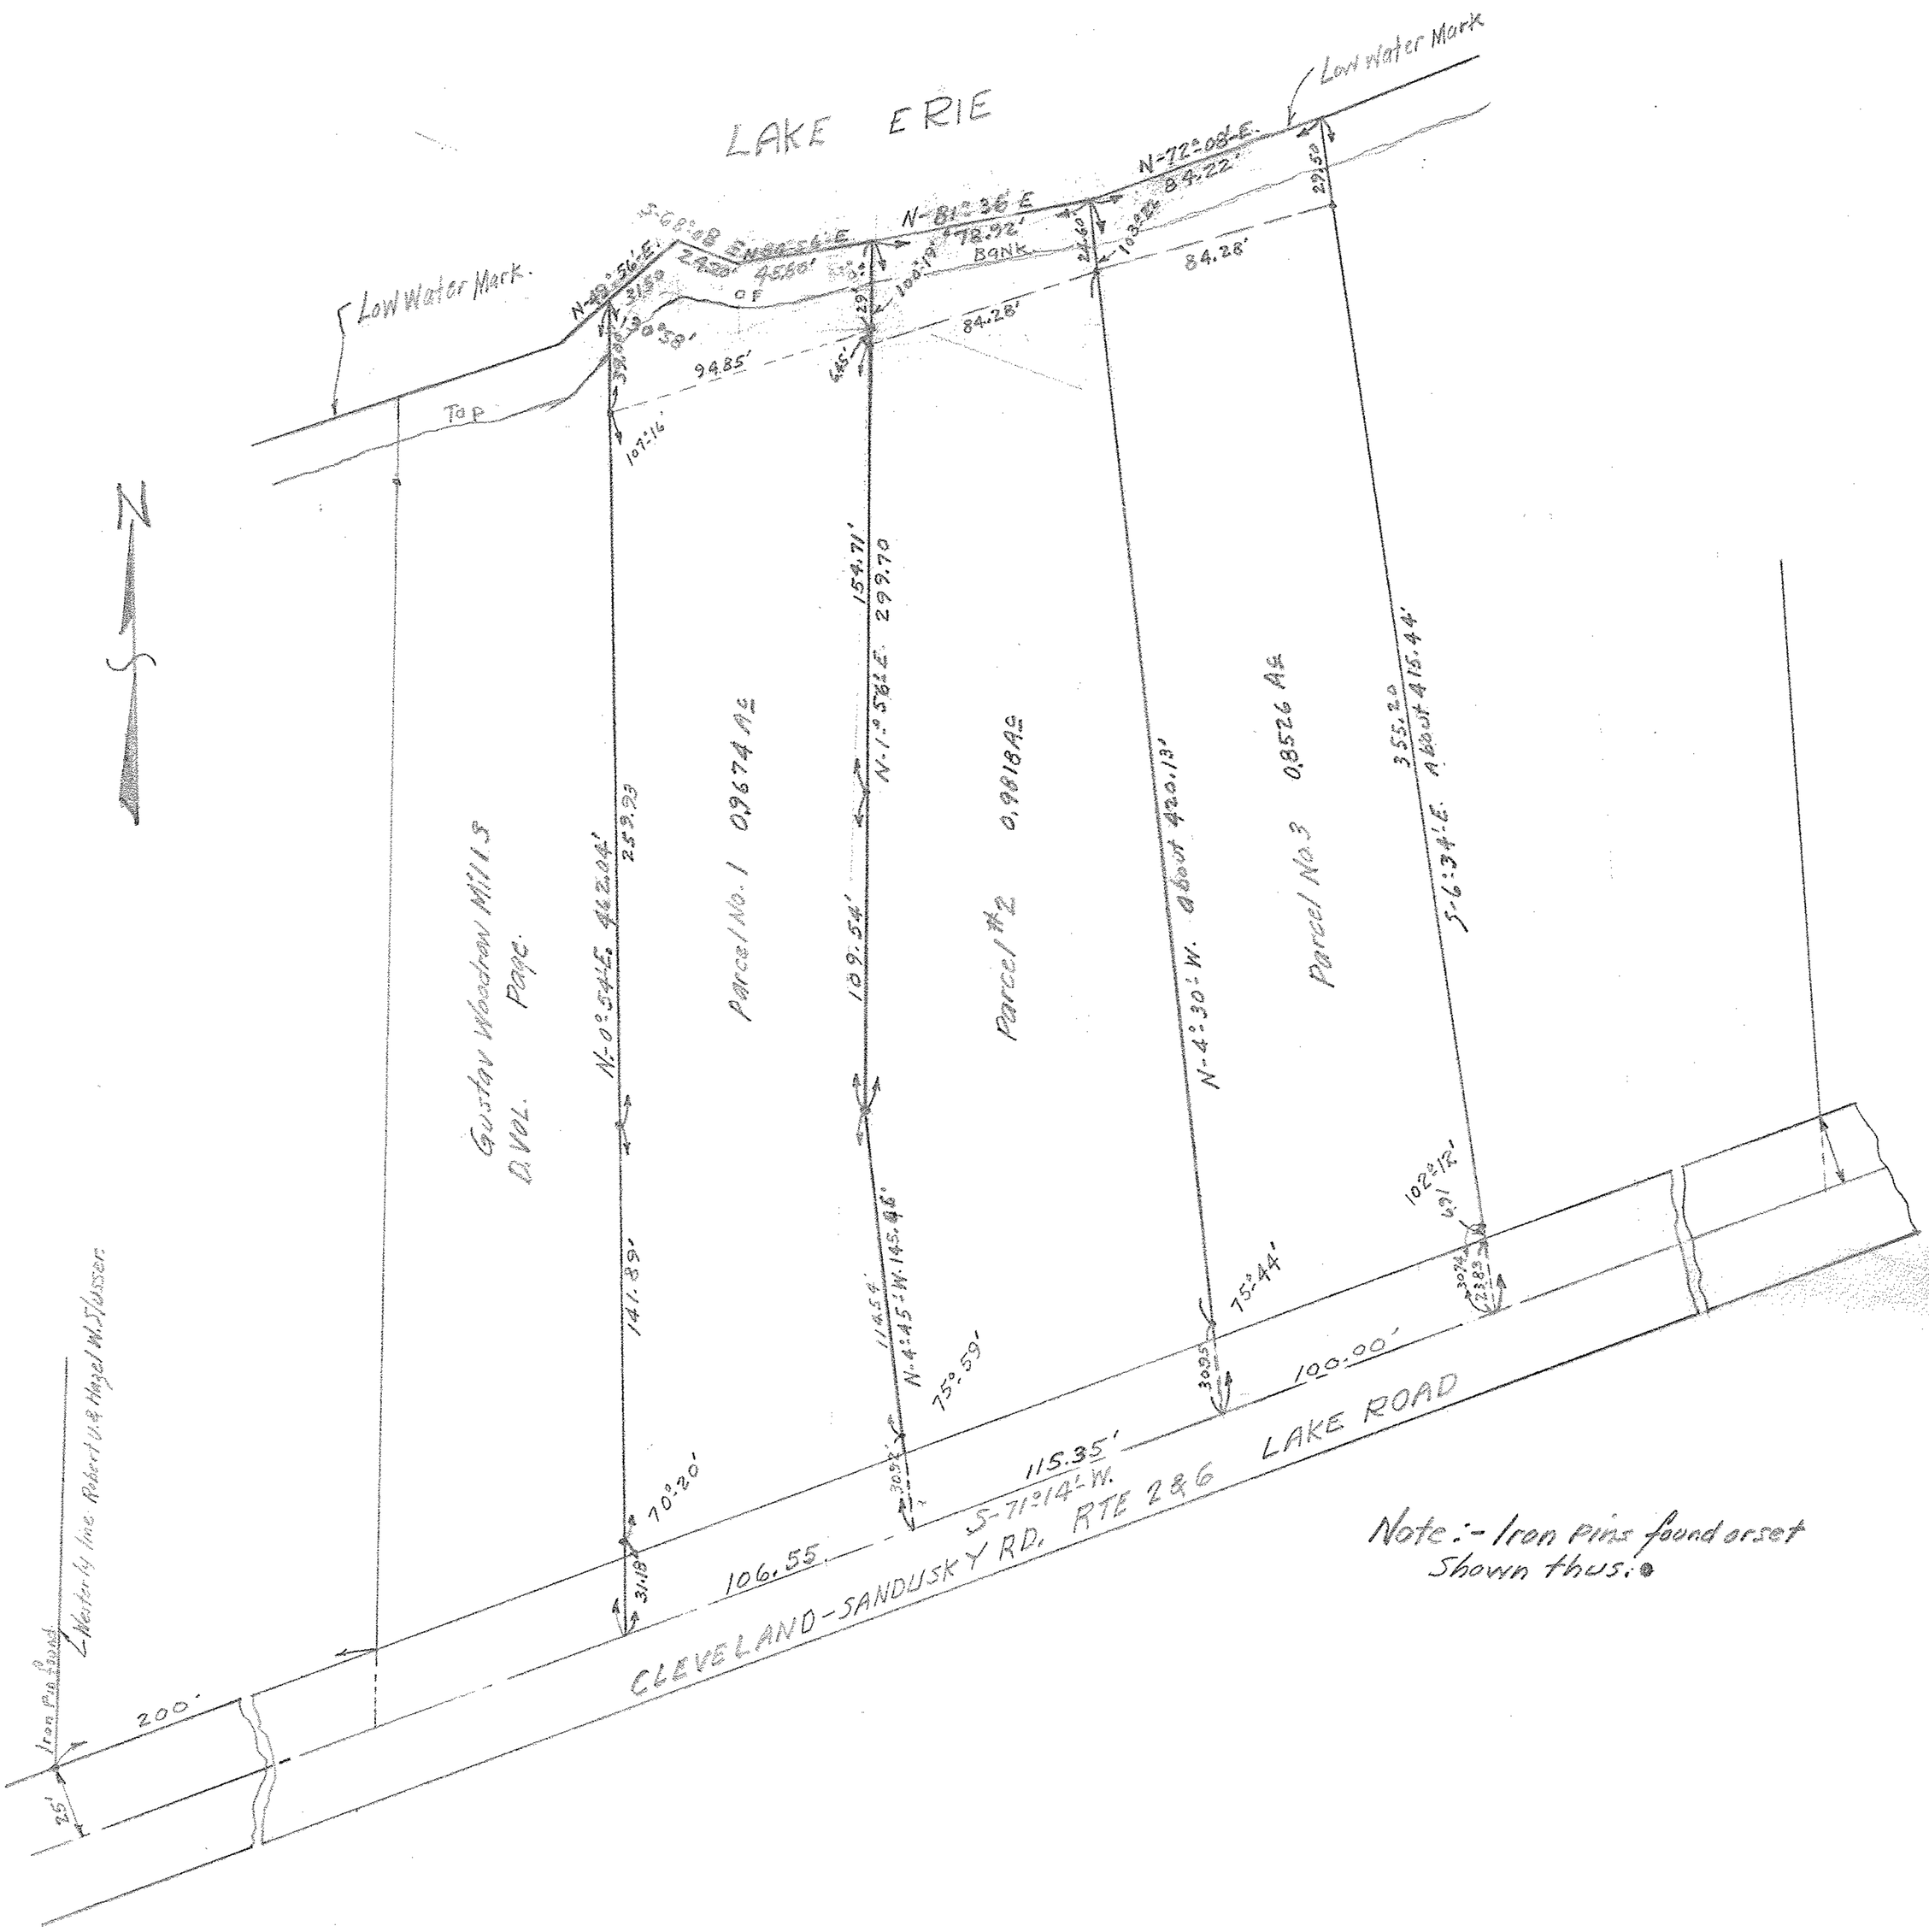

Note:- Iron pins found or set
Shown thus: ●

MAP OF SURVEY FOR
DUDLEY A. HAIN
ORIGINAL AVON TOWNSHIP SECTION NO. 7
AVON LAKE VILLAGE
LORAIN COUNTY OHIO
SCALE 1"=50' MARCH 2-1957
C.E. Penfound Registered Surveyor.

04-00-007