

NOTES: • indicates iron pin set Mar. 13-1979

o indicates iron pin set on previous surveys unless otherwise designated.

Surveys unless otherwise designated.



Virgil J. Muntean D. Vol. 1152 Pg. 257

Virgil J. Muntean D. Vol. 1152 Pg. 253

PLAT OF SURVEYS AND AERATION DRAIN EASEMENTS 5-A

FOR VIRGIL J. MUNTEAN

ORIGINAL LOT NO. 71

LORAIN COUNTY

SCALE: 1"=60'

GARY E. PENTFOUND

AMHERST TWP.

OHIO

MARCH 13-1979

Reg. Surveyor No. 4457

05-00-071-000-034

-033

-030


-029

-028

-027

-026

-013

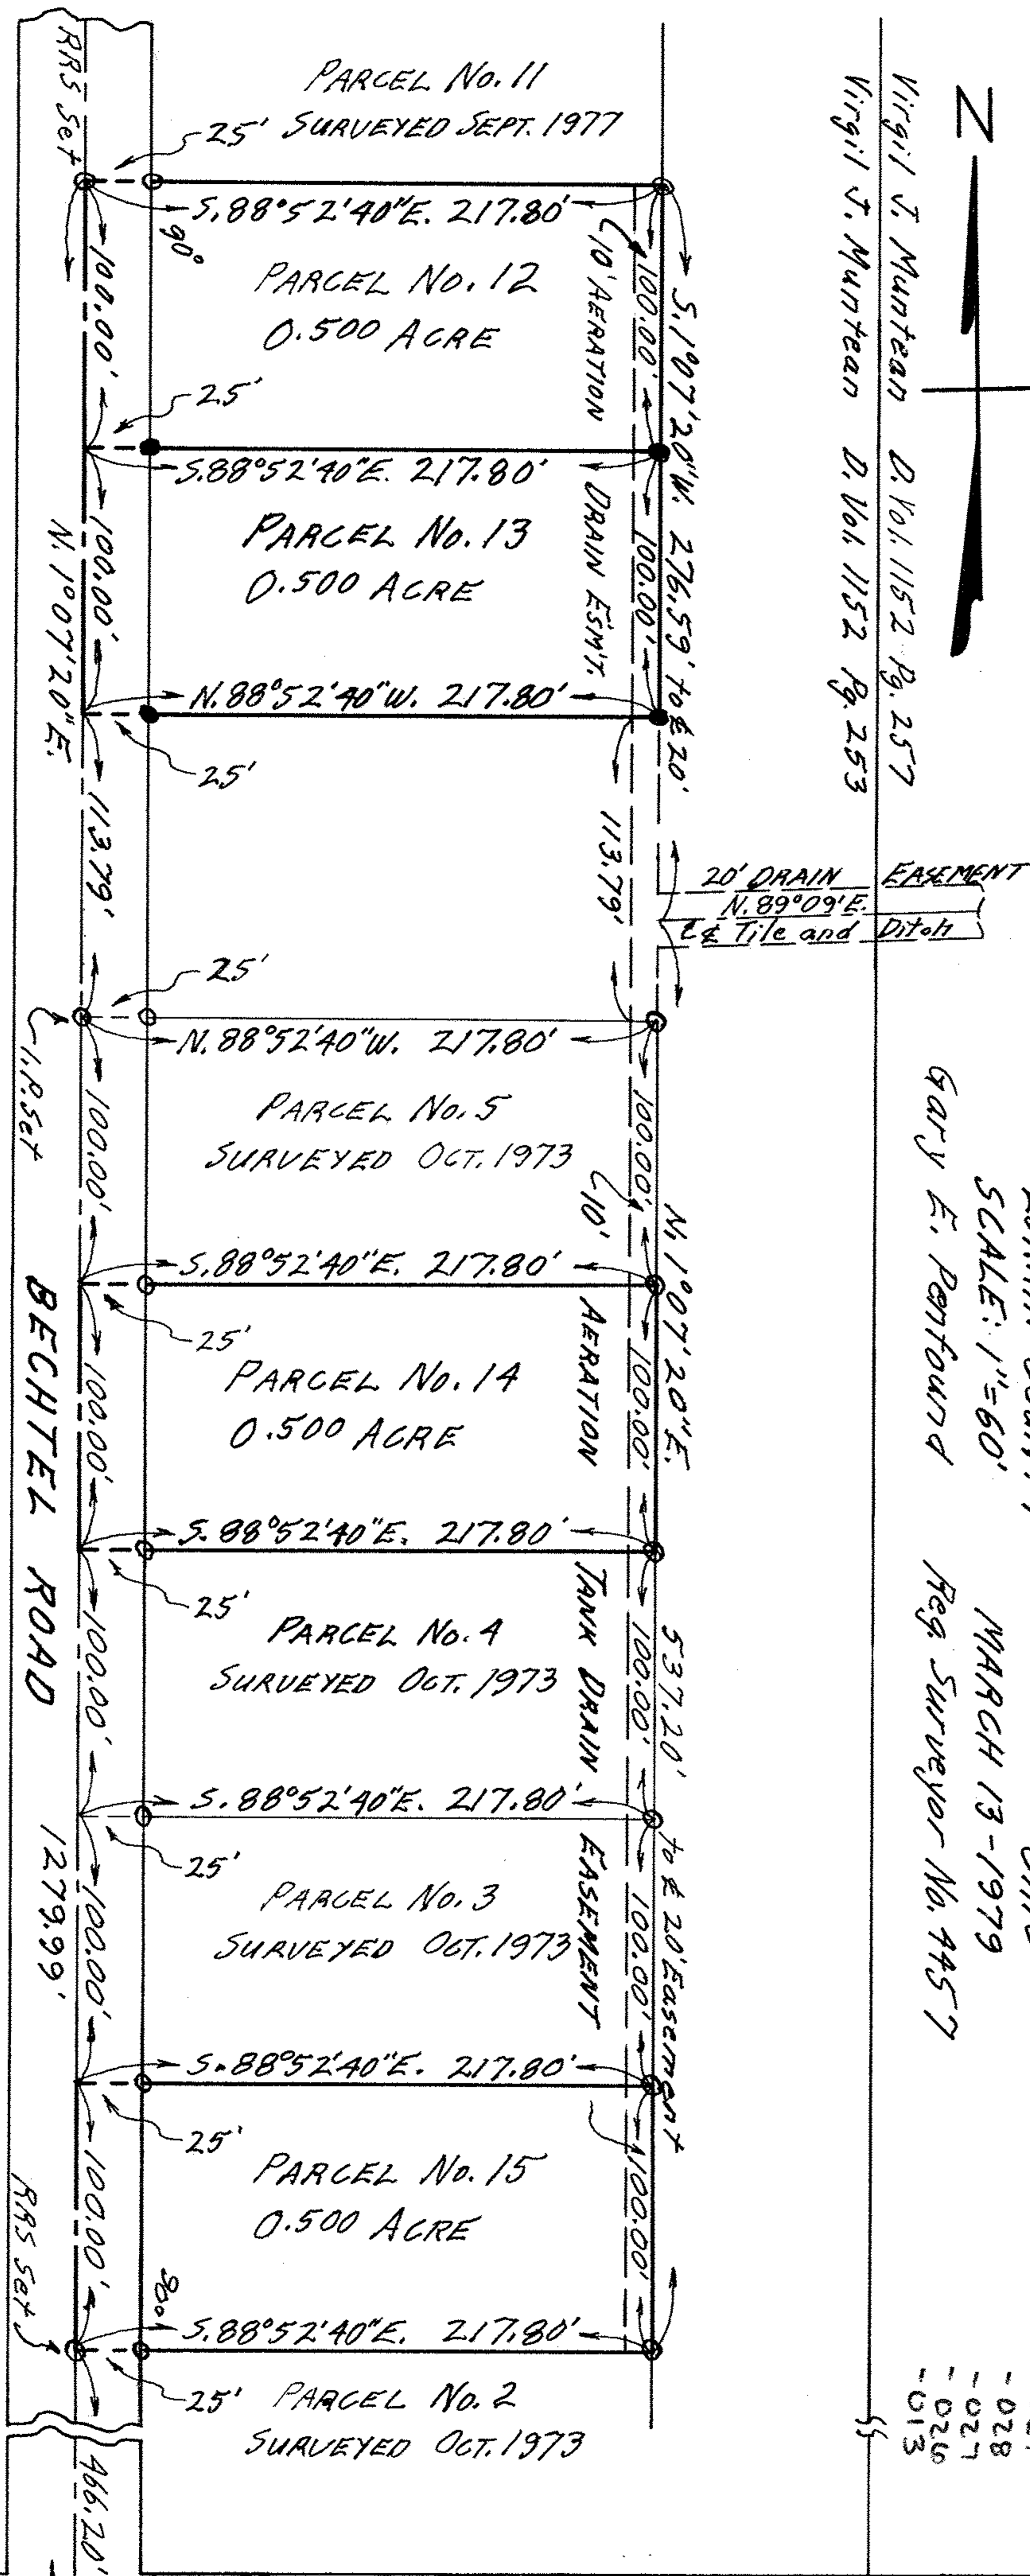

ALBRECHT ROAD	AMHERST	TOWNSHIP
	RUSSIA	TOWNSHIP

05-00-071