


EAST LORAIN ST. (ST. RTE. 10)

I.P. Fd. in Mon. Box.

PLAT OF SURVEY FOR A.H. CLARK  
O.L. 87 RUSSIA TOWNSHIP  
OBERLIN VILLAGE LORAIN COUNTY - OHIO  
SCALE 1"=100' MARCH 1957  
C.E. Penfound Registered Surveyor

Note: Iron pins found or set shown thus: ●

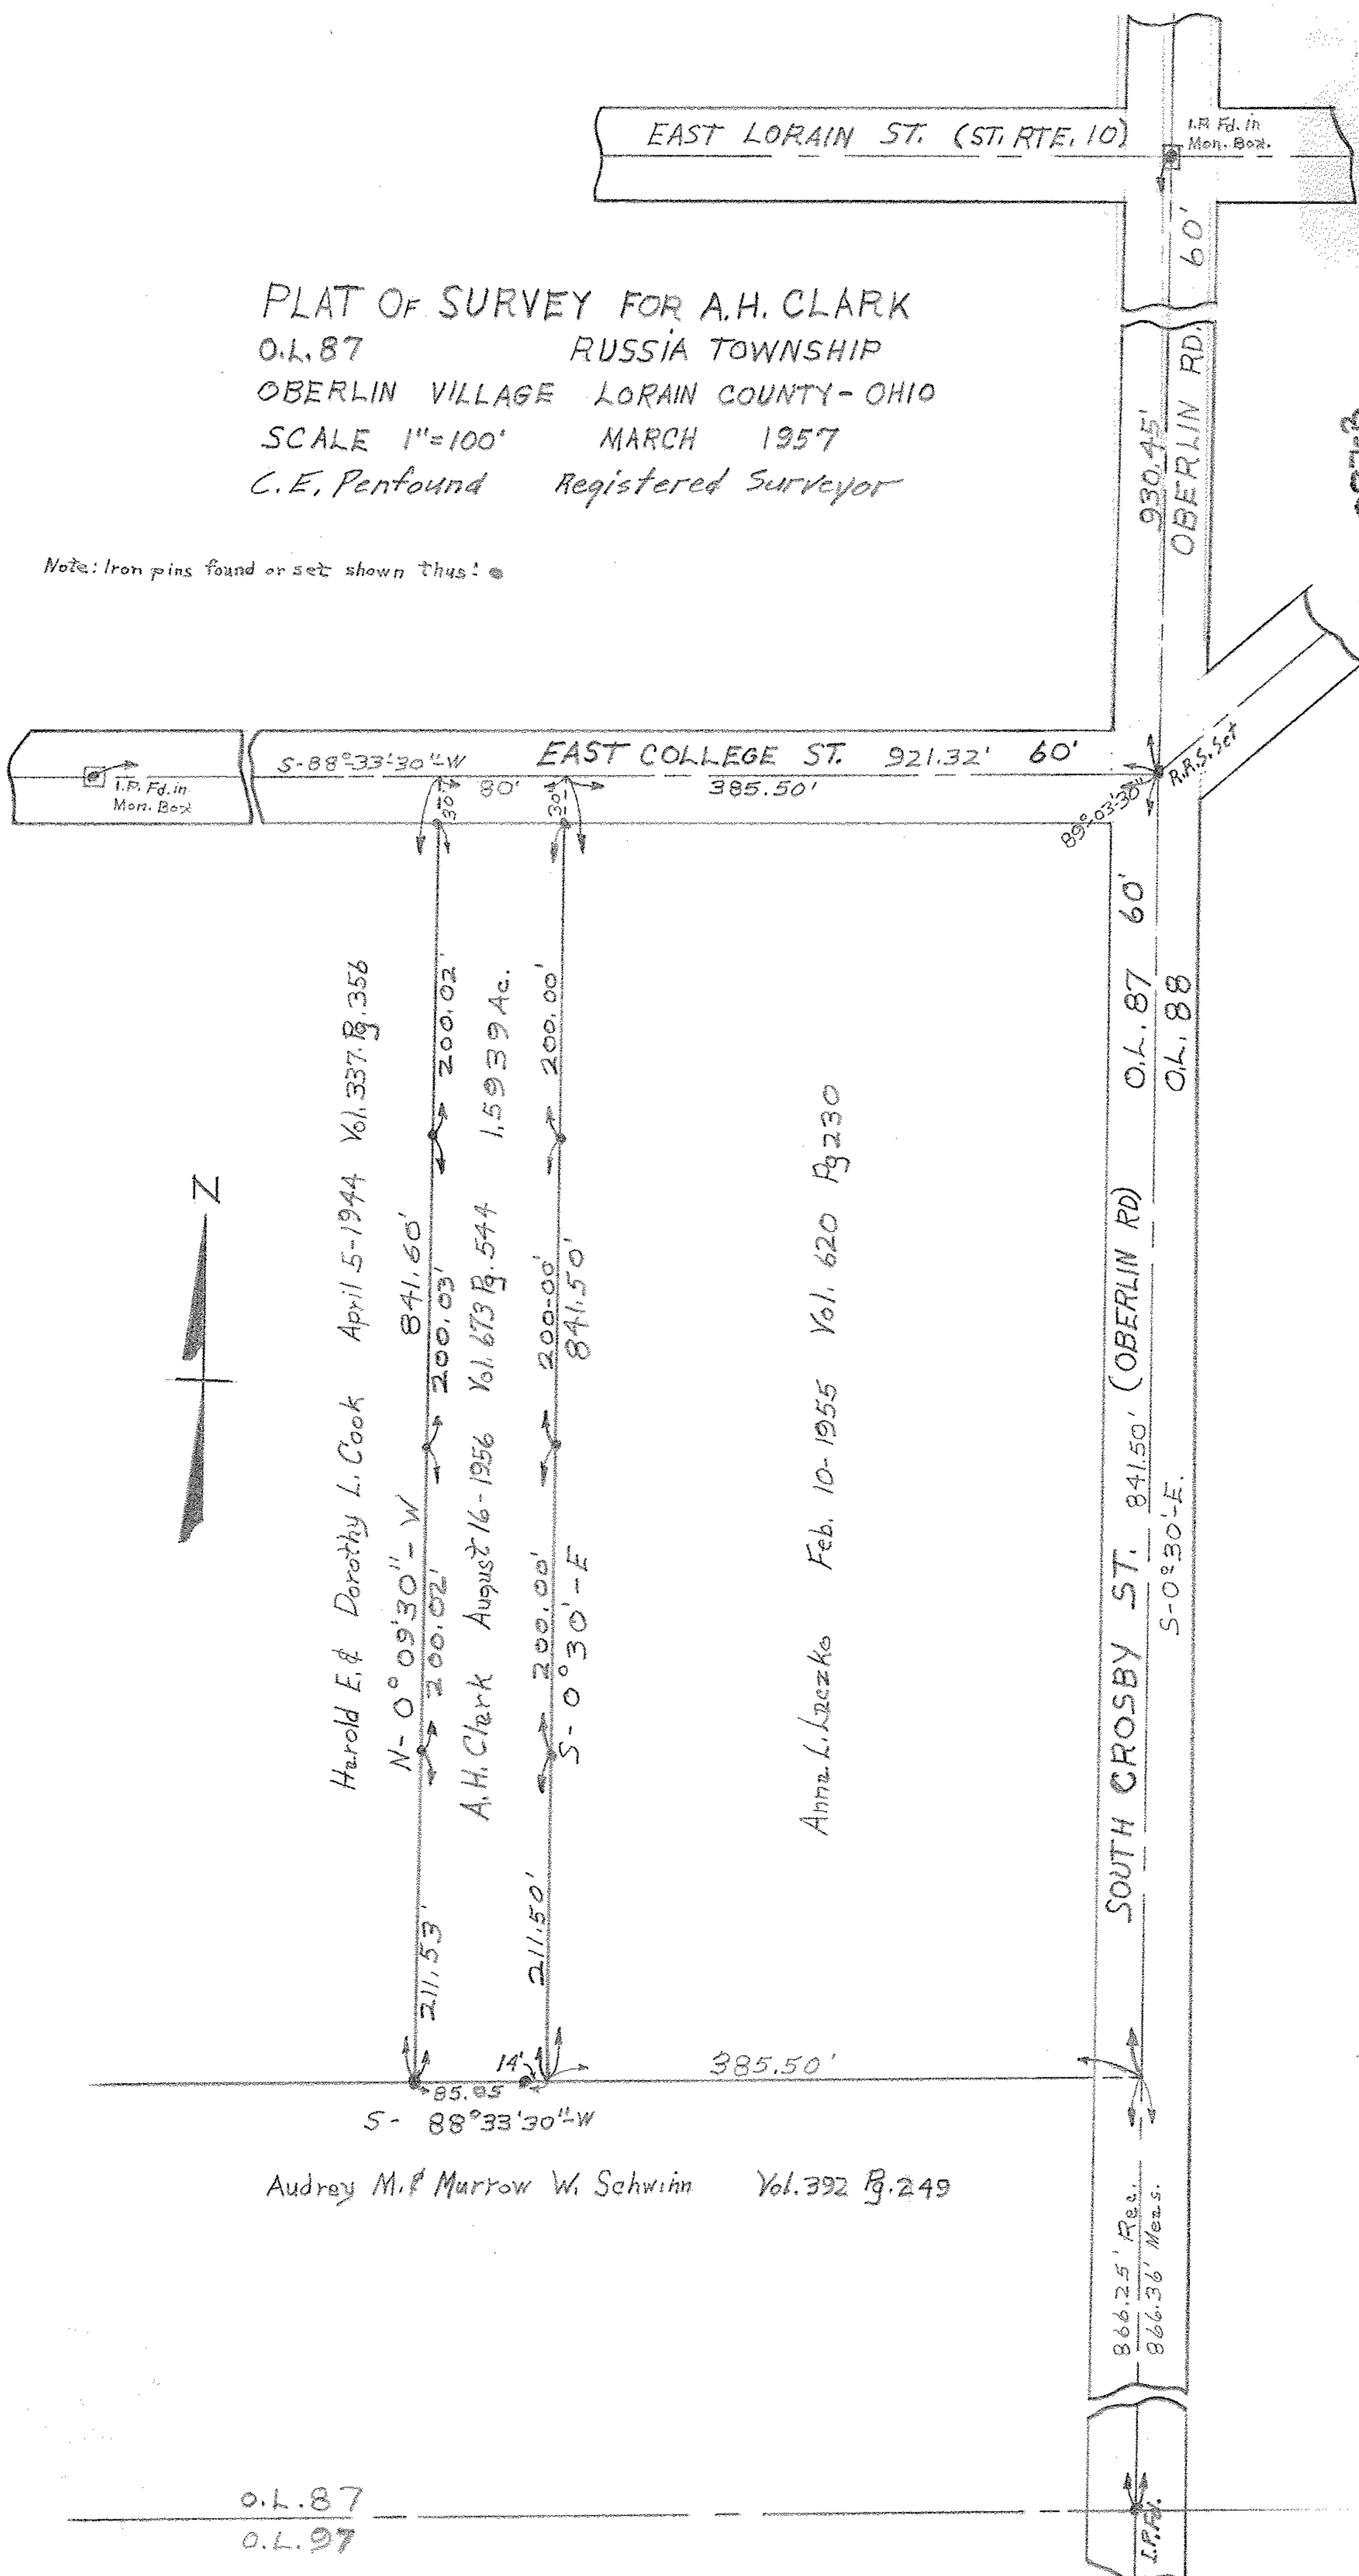

69-00-087-B

09-00-087-107-028

09-00-087

O.L. 87  
O.L. 97