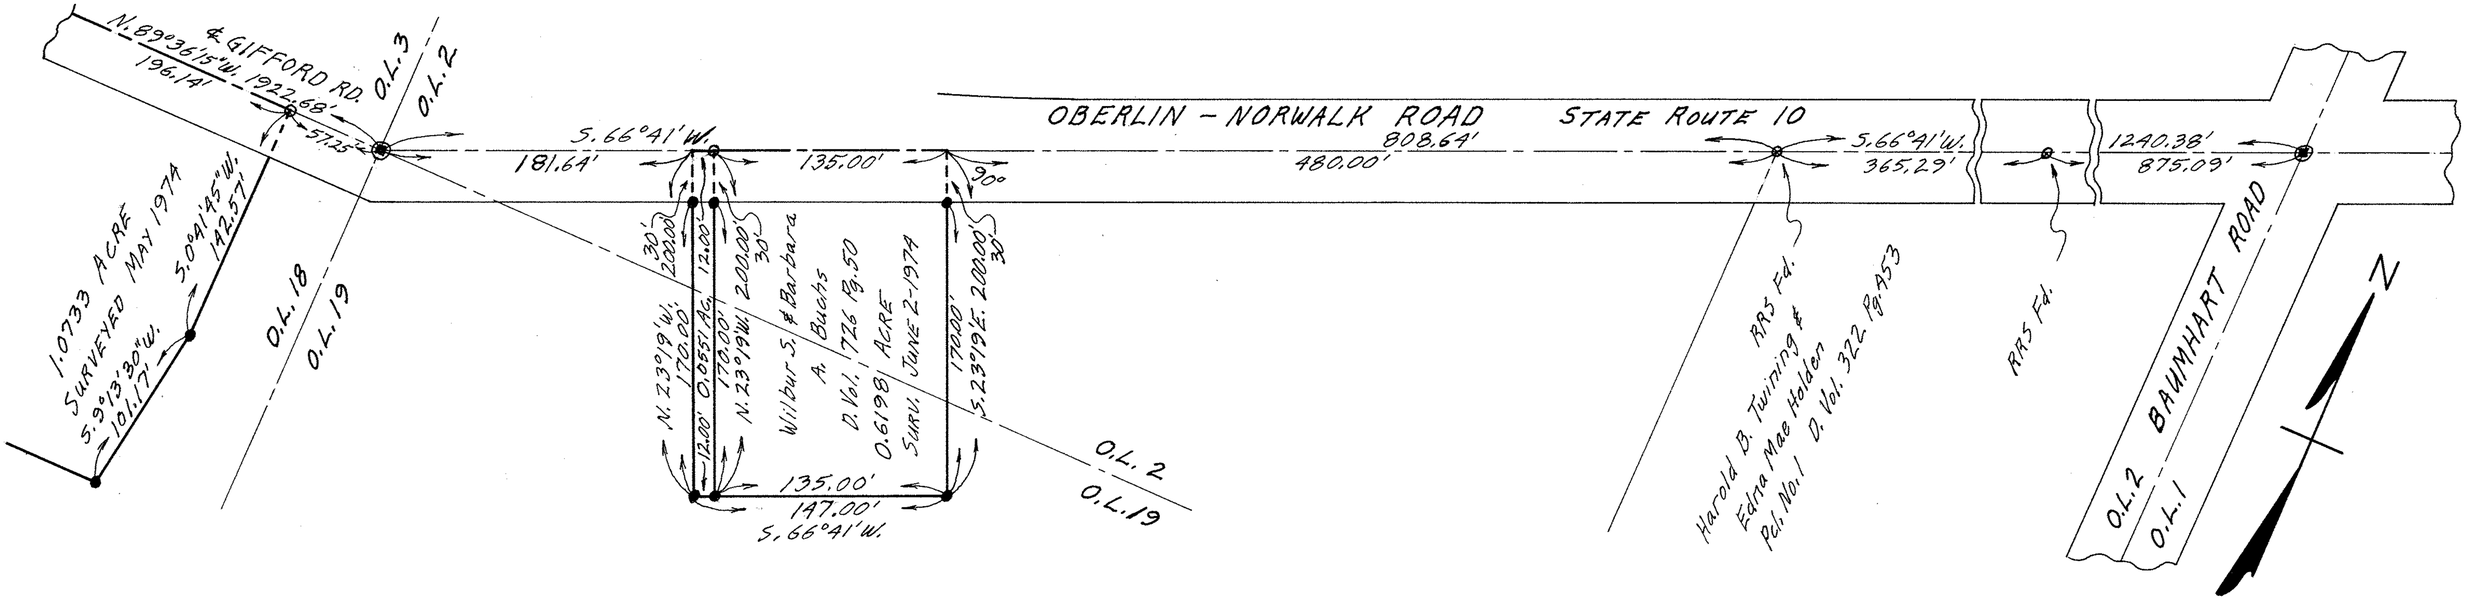

PLAT OF SURVEYS FOR
ALLEN C. BUCHS

ORIGINAL LOTS 2 & 19 TRACT NO. 12
HENRIETTA TOWNSHIP
LORAIN COUNTY OHIO
SCALE: 1" = 60'

Gary E. Penfound Reg. Surveyor No. 4457

NOTES: ⊗ indicates Stone Monument found in Monument Box.
● indicates Iron Pin set.
○ indicates Railroad Spike in pavement, set unless otherwise designated.

0.0551 ACRE SURVEYED JULY 17-1977 FOR
WILBUR S. BUCHS

ACREAGE SPLIT BY ORIGINAL LOTS

	O.L. 2	O.L. 19
0.6198 Acre Parcel	0.3555 Ac.	0.2643 Ac.
0.0551 Acre Parcel	0.0227 Ac.	0.0324 Ac.
0.6749 Acre Combined	0.3782 Ac.	0.2967 Ac.

8-H

08-12-019-000-026
08-12-002-000-044

08-12-002,019