PLAT OF SURVEY FOR
AUGUST & STELLA C. VIRAG

ORIG. LOTS 5, 6, 15, & 16 TRACT 12
HENRIETTA TWP. – LORAIN COUNTY – OHIO
SCALE: 1" = 100' MARCH 6, 1956
C.E. Penfound Registered Surveyor

NOTE: Iron pins found or set shown thus: ●

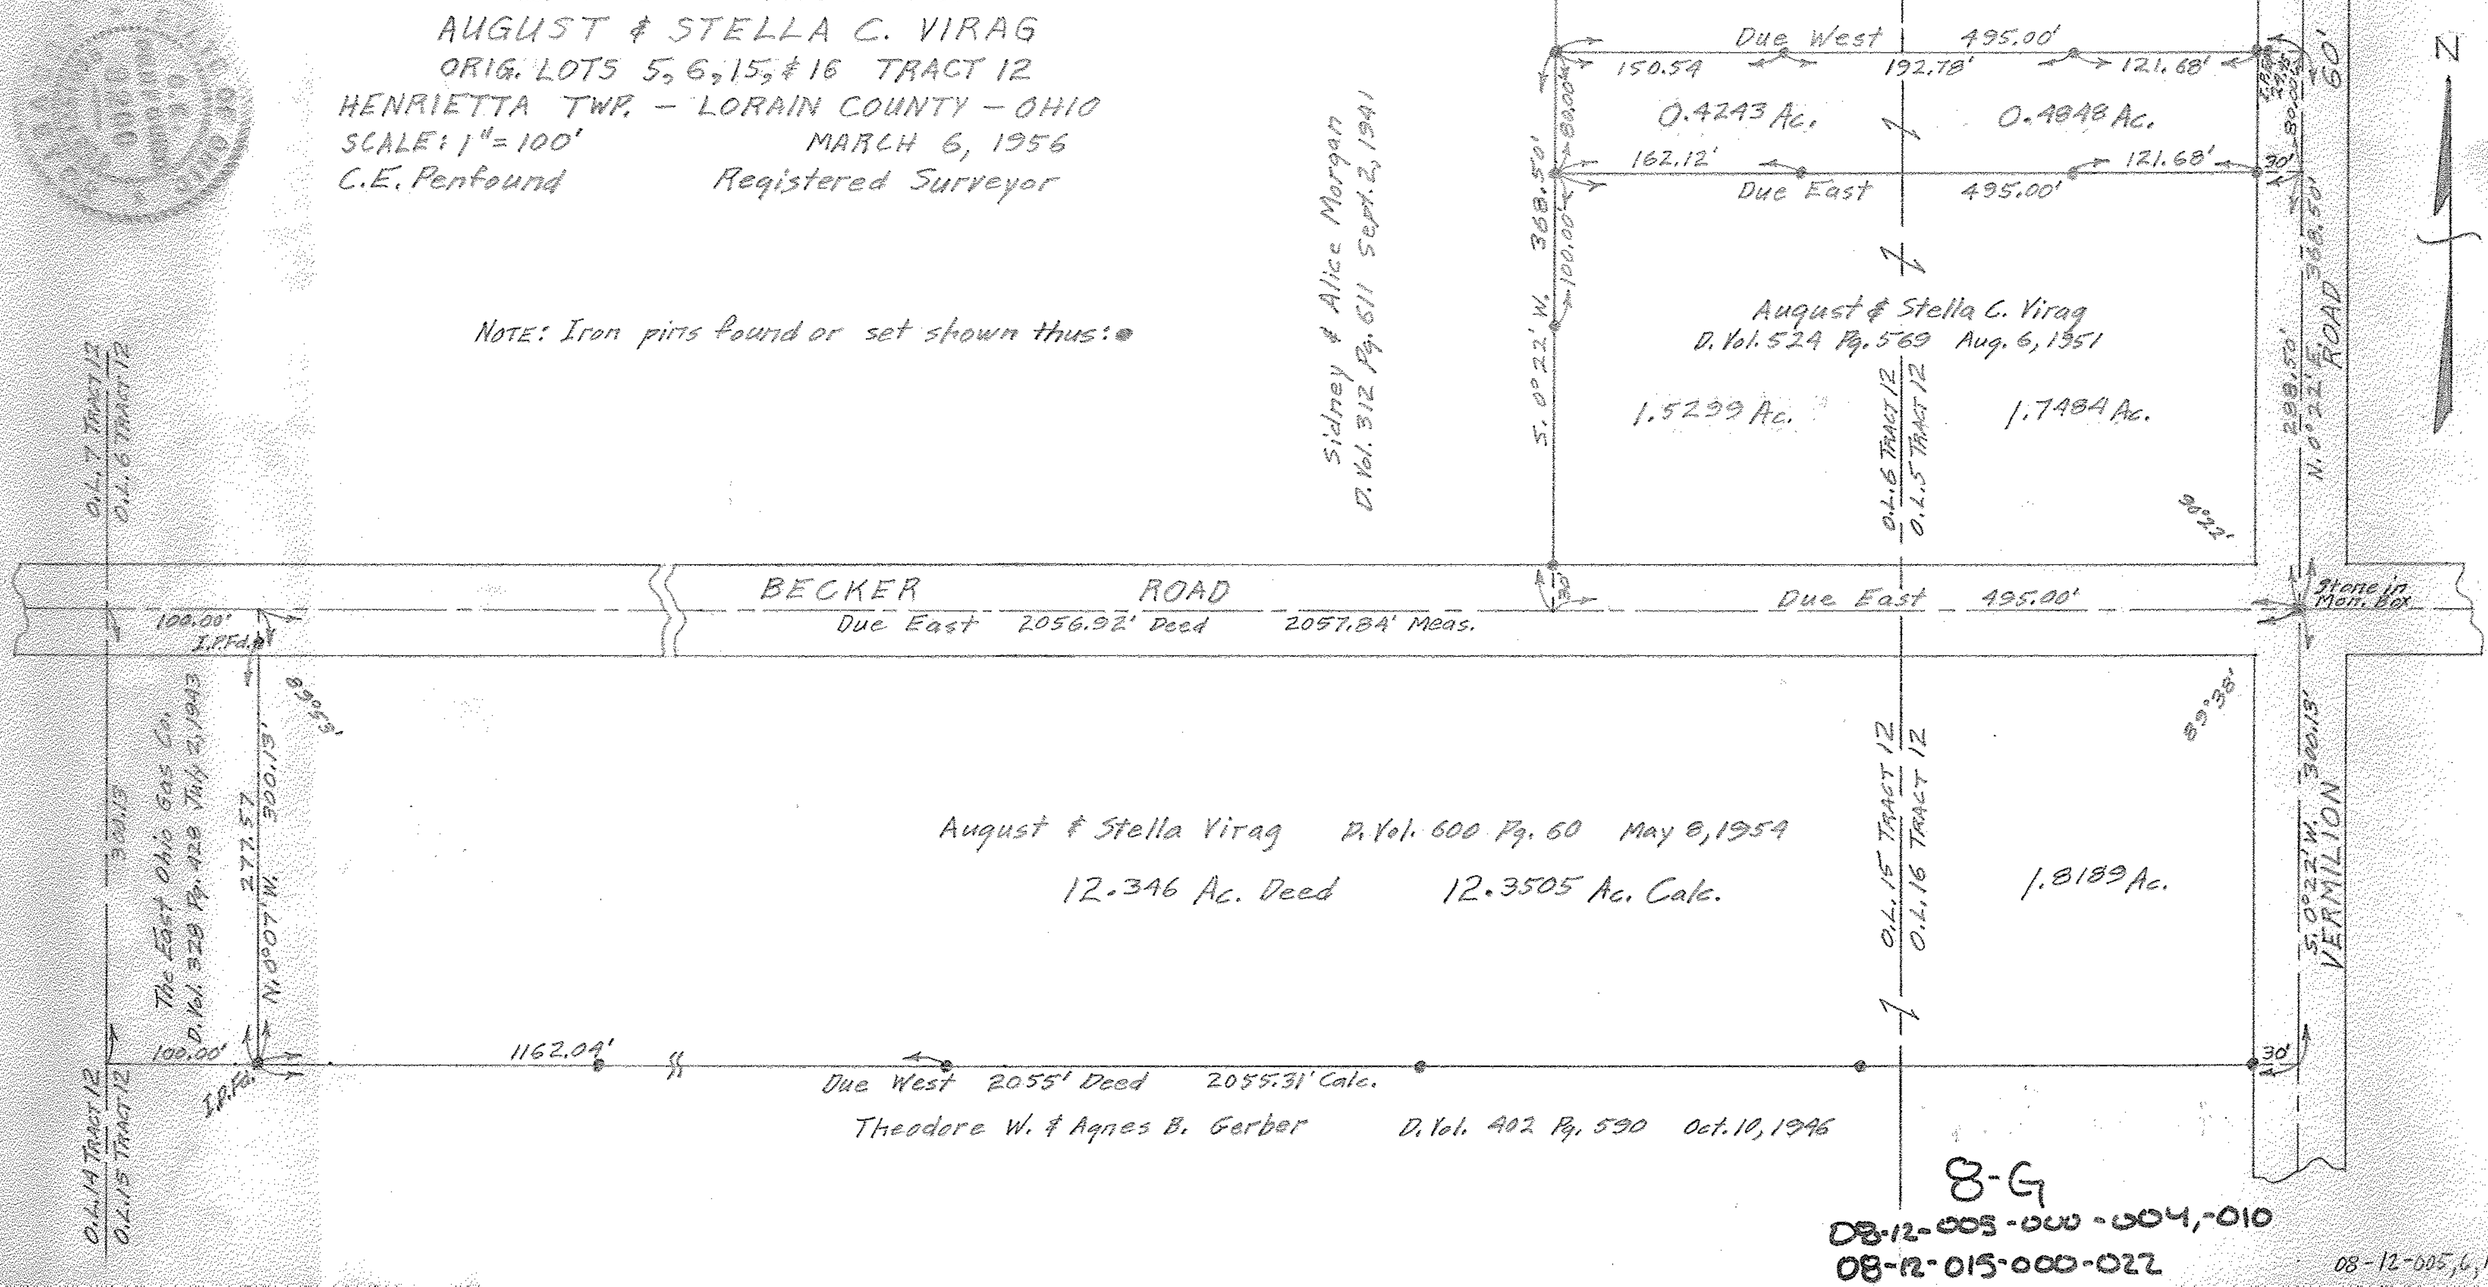

8-G
08-12-005-000-004,-010
08-12-015-000-022

08-12-005,6,15,16