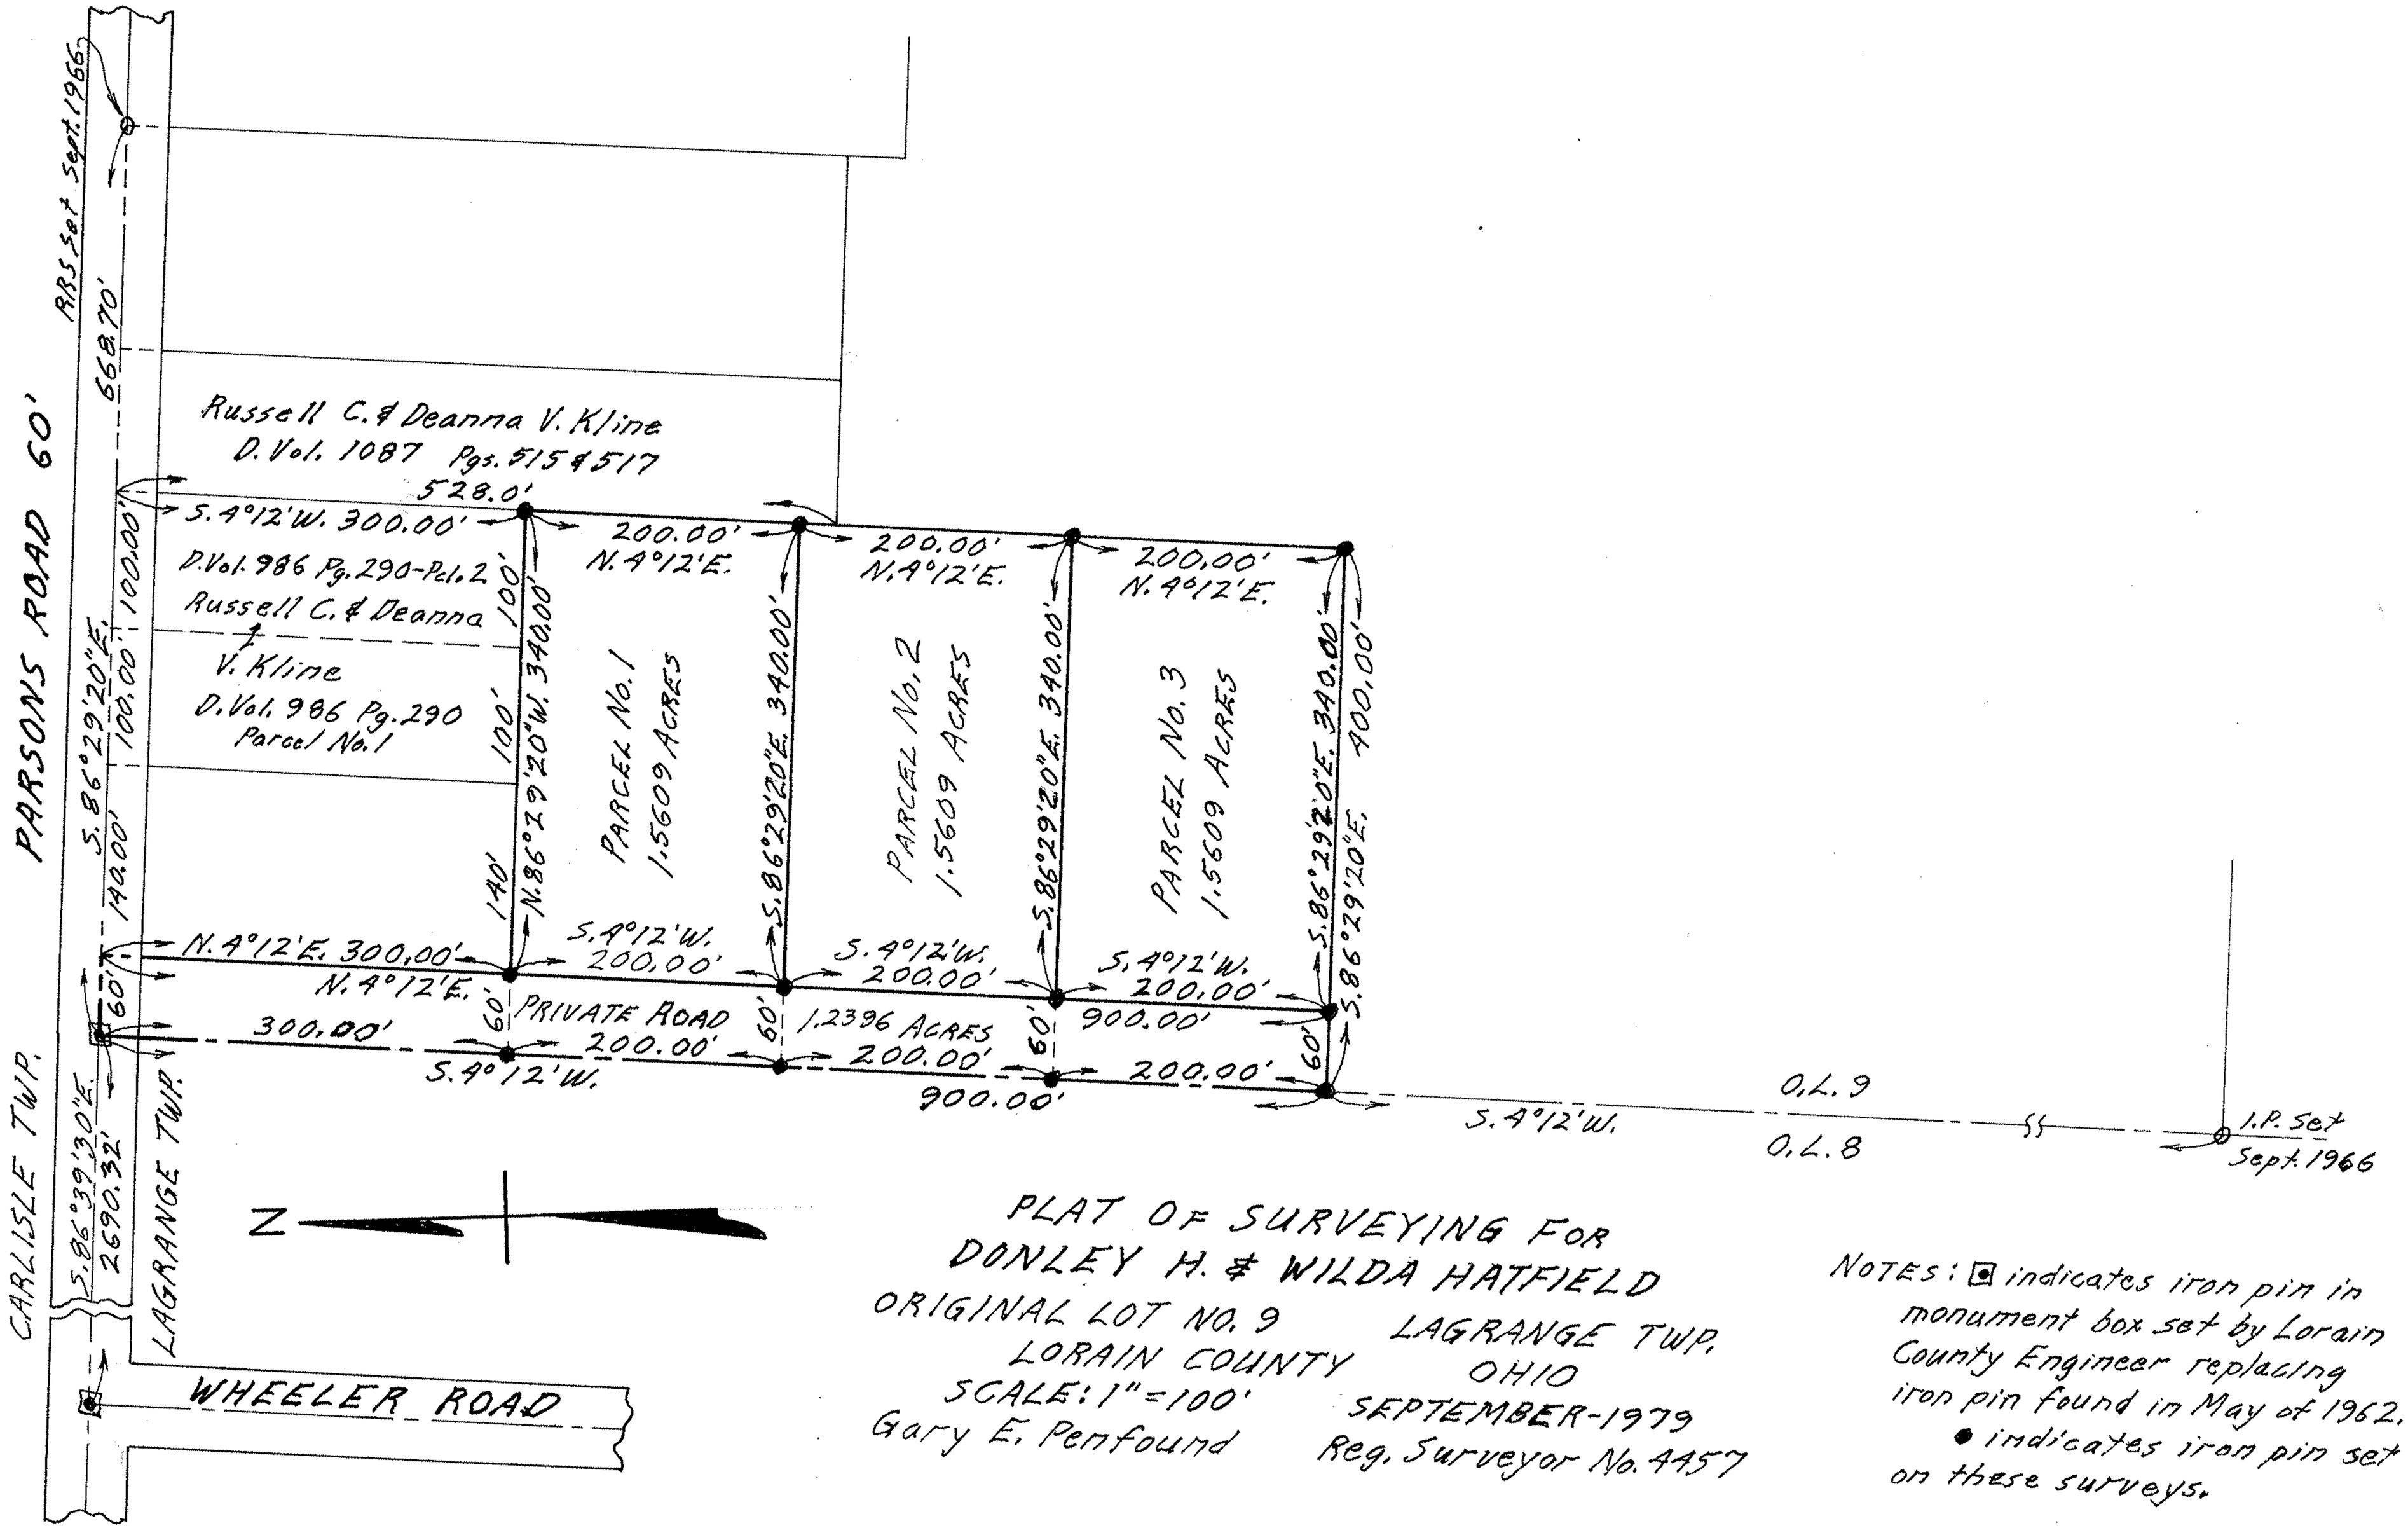

PLAT OF SURVEYING FOR
DONLEY H. & WILDA HATFIELD
ORIGINAL LOT NO. 9
LORAIN COUNTY
SCALE: 1" = 100'
Gary E. Penfound

LAGRANGE TWP.
OHIO
SEPTEMBER-1979
Reg. Surveyor No. 4457

NOTES: ⊡ indicates iron pin in monument box set by Lorain County Engineer replacing iron pin found in May of 1962.
● indicates iron pin set on these surveys.