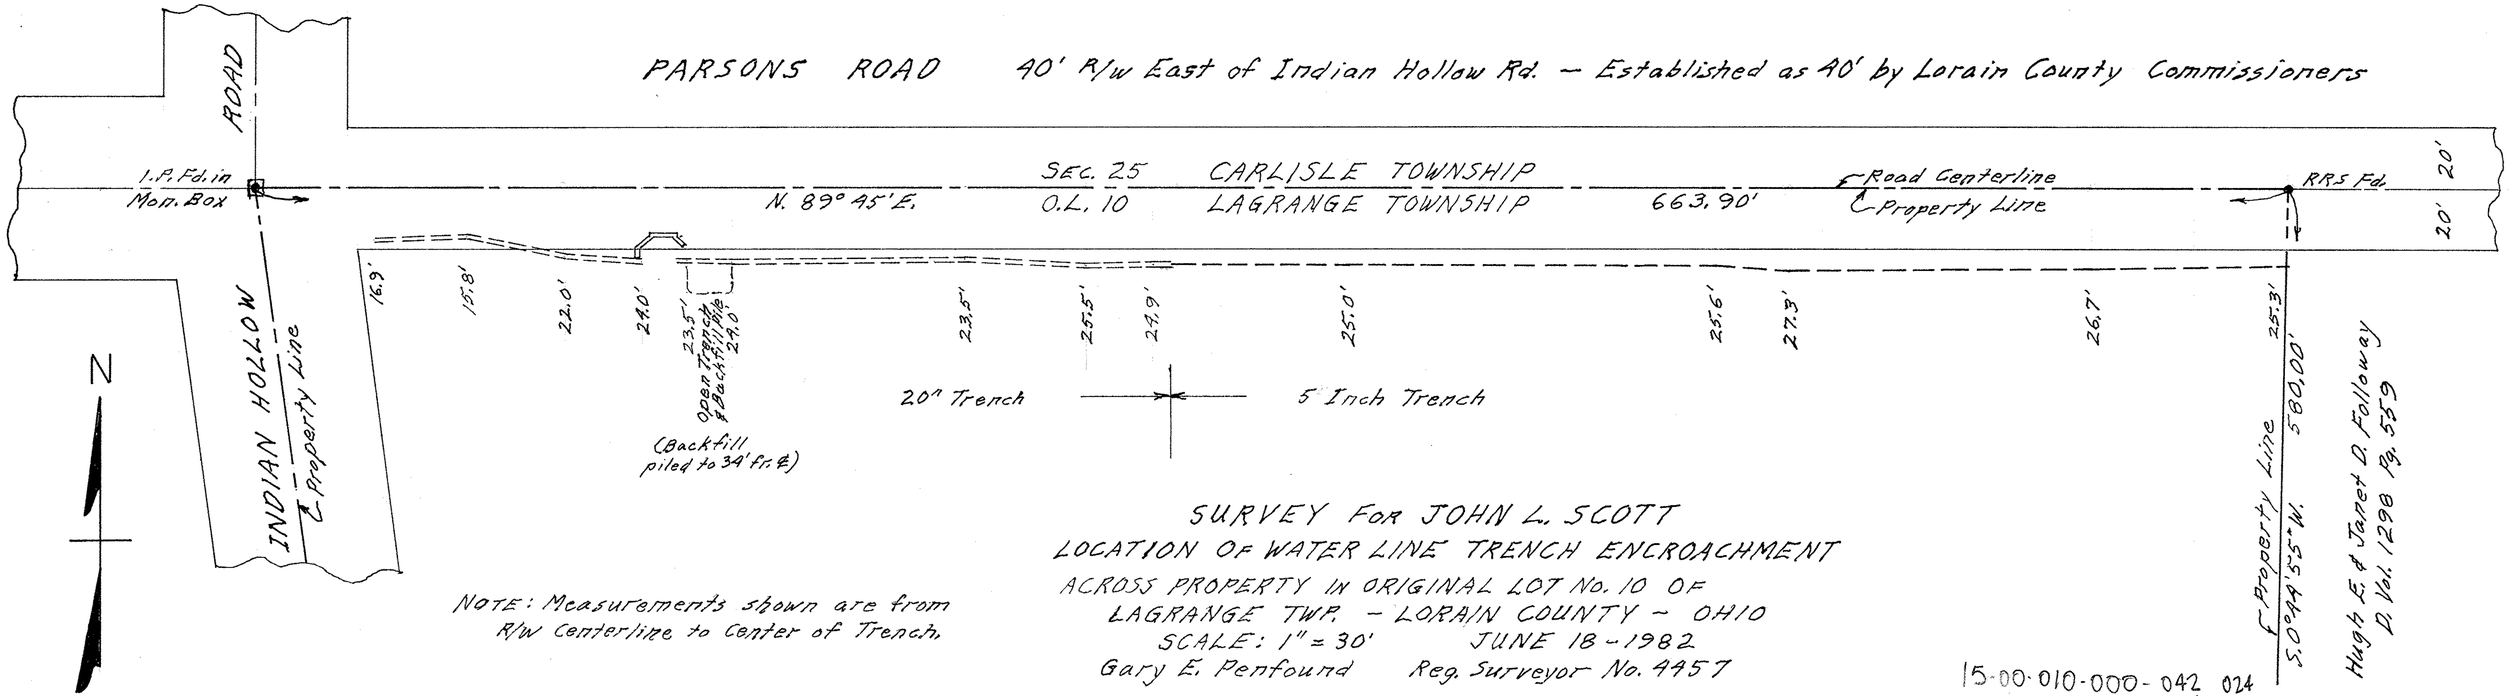
PARSONS ROAD 40' R/W East of Indian Hollow Rd. — Established as 40' by Lorain County Commissioners
ROAD
I.P. Fd. in Mon. Box
N. 89° 45' E.
SEC. 25 CARLISLE TOWNSHIP
O.L. 10 LAGRANGE TOWNSHIP
663.90'
℄ Road Centerline
℄ Property Line
RR.S Fd.
20'
20'
INDIAN HOLLOW
℄ Property Line
N
16.9'
15.8'
22.0'
24.0'
23.5'
Open Trench & Backfill
24.0'
23.5'
25.5'
24.9'
25.0'
25.6'
27.3'
26.7'
25.3'
20" Trench
5 Inch Trench
(Backfill piled to 34' fr. ℄)
℄ Property Line
S.0°44'55" W.
580.00'
Hugh E. & Janet D. Followay
D. Vol. 1290 Pg. 559
NOTE: Measurements shown are from R/W Centerline to Center of Trench.
SURVEY FOR JOHN L. SCOTT
LOCATION OF WATER LINE TRENCH ENCROACHMENT
ACROSS PROPERTY IN ORIGINAL LOT No. 10 OF
LAGRANGE TWP. - LORAIN COUNTY - OHIO
SCALE: 1" = 30' JUNE 18 - 1982
Gary E. Penfound Reg. Surveyor No. 4457
15-00-010-000- 042 024
026 028
030
022
032
15-D
15-00-010