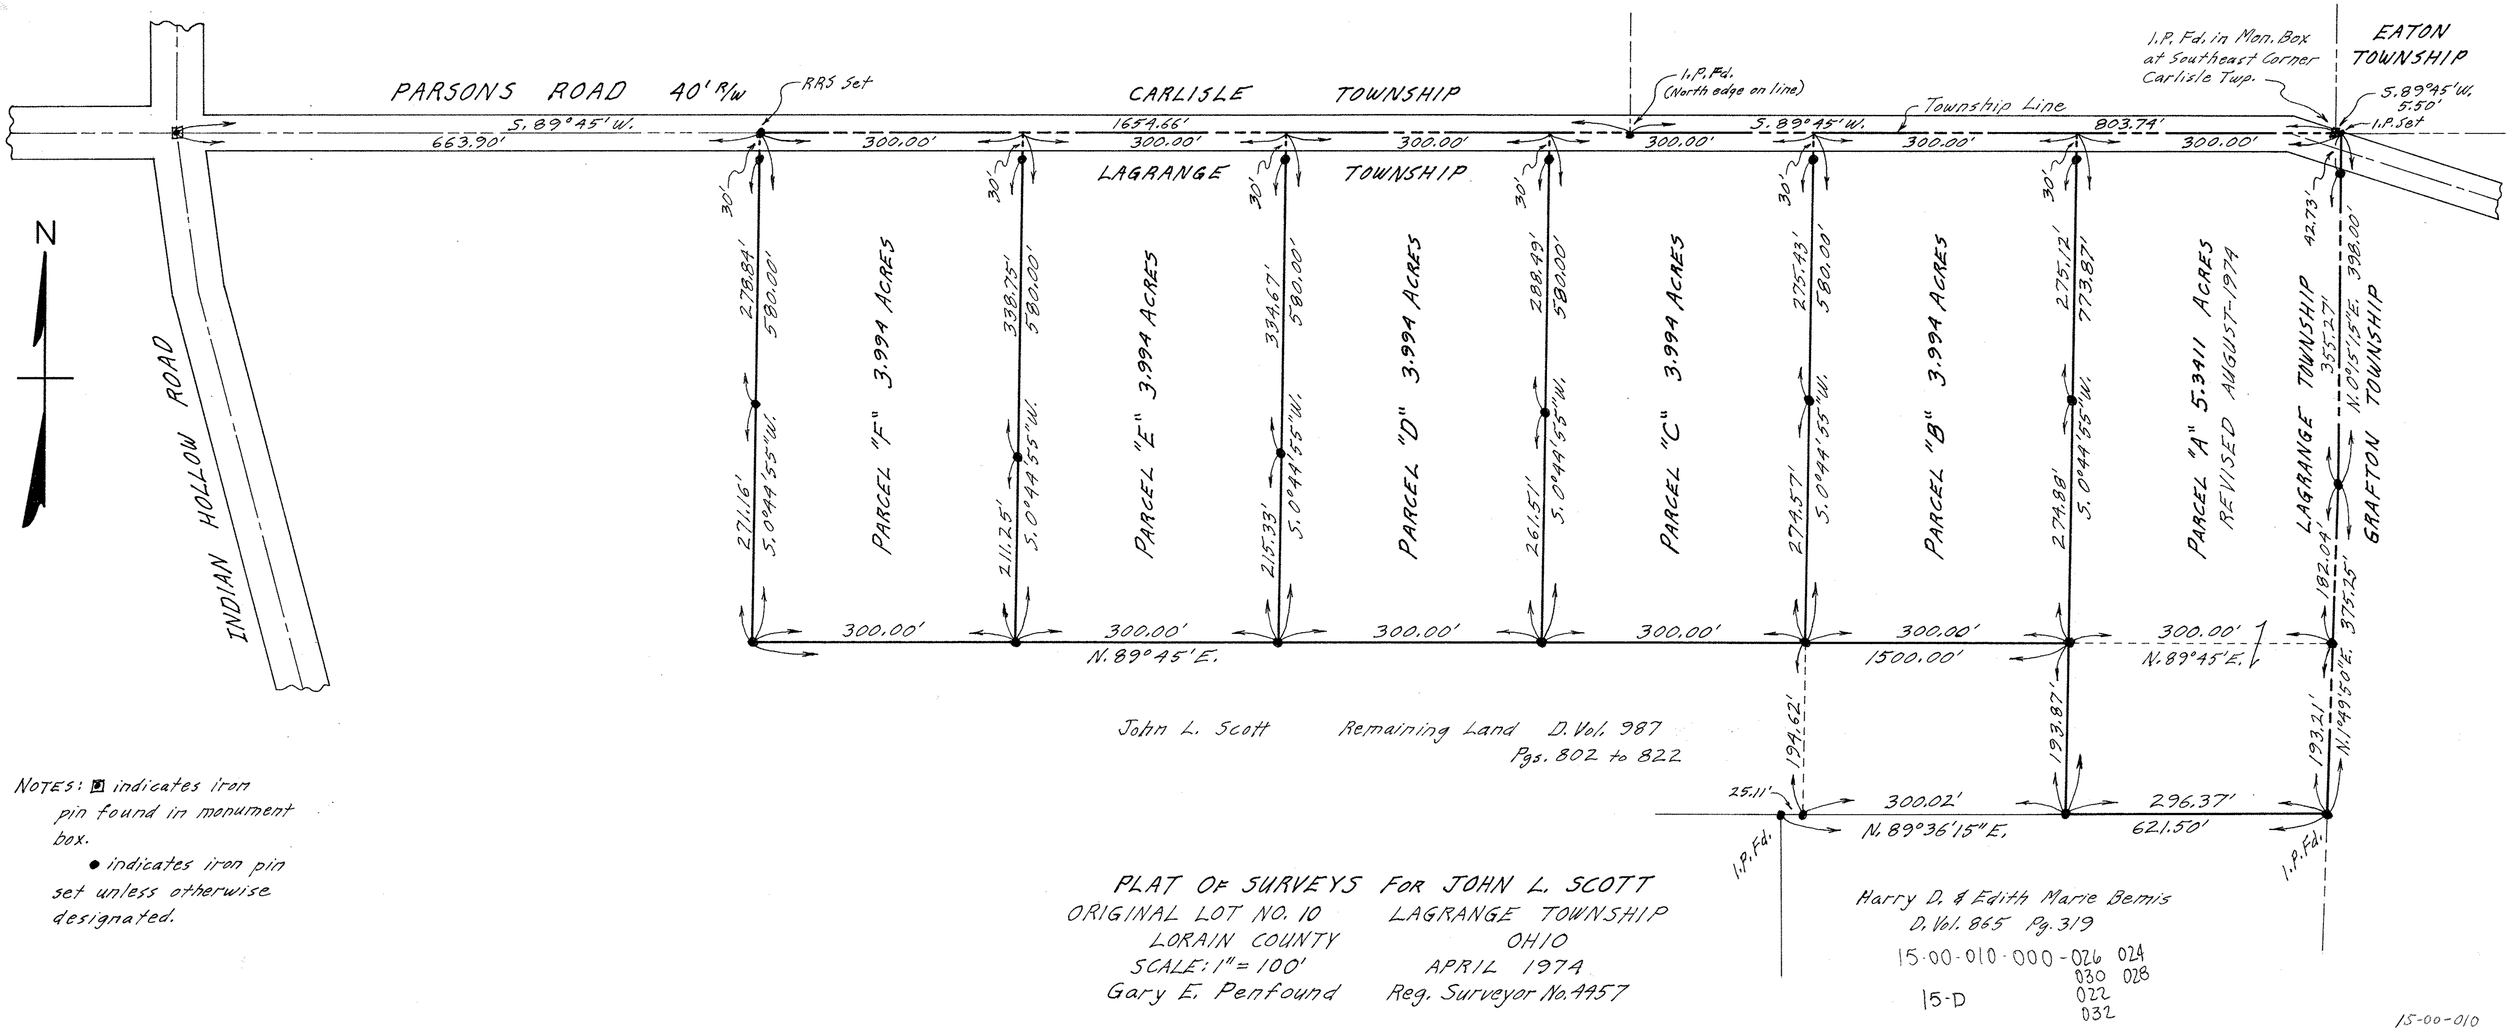

NOTES: ▣ indicates iron pin found in monument box.
● indicates iron pin set unless otherwise designated.

PLAT OF SURVEYS FOR JOHN L. SCOTT
ORIGINAL LOT NO. 10 LAGRANGE TOWNSHIP
LORAIN COUNTY OHIO
SCALE: 1" = 100' APRIL 1974
Gary E. Penfound Reg. Surveyor No. 4957