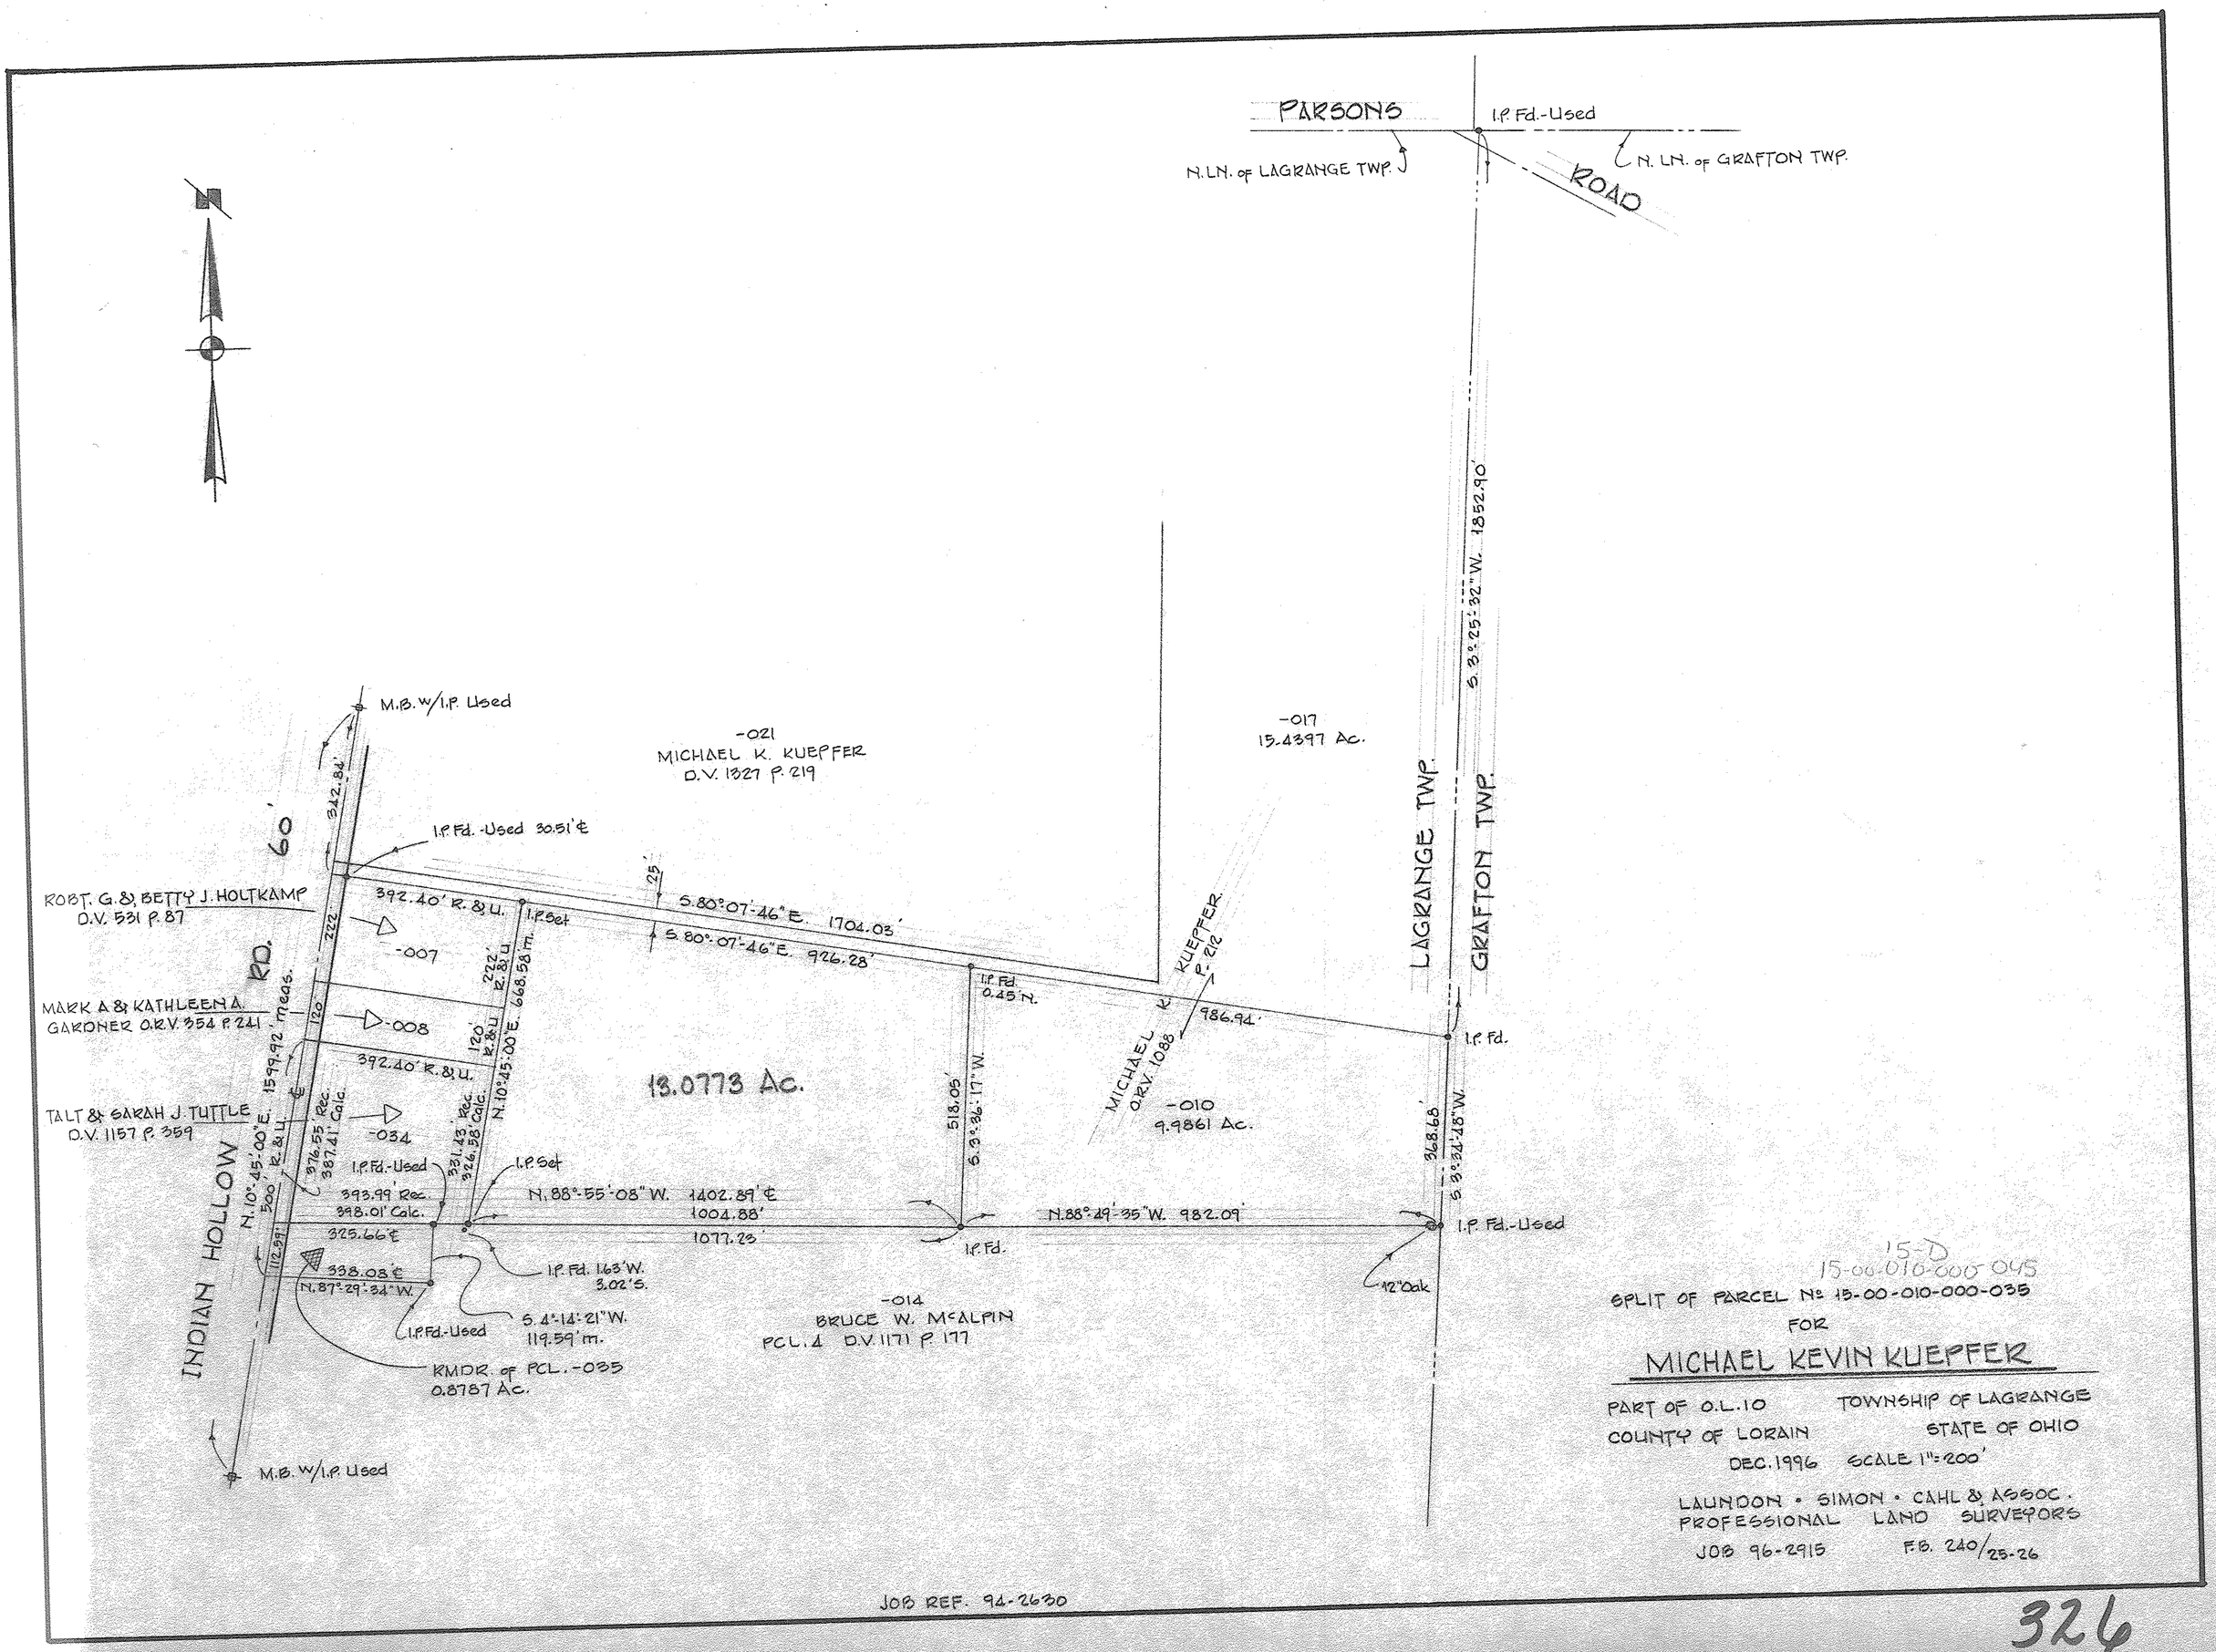
PARSONS
I.P. Fd.-Used
N. LN. of LAGRANGE TWP.
N. LN. of GRAFTON TWP.
ROAD
S. 3°25'32" W. 1852.90'
LAGRANGE TWP.
GRAFTON TWP.
-017
15.4397 Ac.
-021
MICHAEL K. KUEPFER
D.V. 1327 P. 219
M.B. w/I.P. Used
342.84'
I.P. Fd.-Used 30.51' ℄
60'
ROBT. G. & BETTY J. HOLTKAMP
D.V. 531 P. 87
392.40' R. & U.
I.P. Set
S. 80°07'46" E. 1704.03'
S. 80°07'46" E. 926.28'
-007
MARK A. & KATHLEEN A. GARDNER O.R.V. 354 P. 241
-008
392.40' R. & U.
1599.92' meas.
N. 10°45'00" E. 668.58' m.
13.0773 Ac.
I.P. Fd. 0.45' N.
MICHAEL K. KUEPFER P. 212
986.94'
MICHAEL K. O.R.V. 1088
-010
9.9861 Ac.
I.P. Fd.
TALT & SARAH J. TUTTLE
D.V. 1157 P. 359
-034
376.55' Rec.
387.41' Calc.
331.43' Rec.
326.58' Calc.
518.05'
S. 3°36'17" W.
368.68'
S. 3°34'48" W.
I.P. Fd.-Used
393.99' Rec.
398.01' Calc.
I.P. Set
N. 88°55'08" W. 1402.89' ℄
1004.88'
1077.23'
N. 88°49'35" W. 982.09'
I.P. Fd.-Used
325.66' ℄
338.08' ℄
N. 87°29'34" W.
I.P. Fd. 1.63' W. 3.02' S.
I.P. Fd.
12" Oak
INDIAN HOLLOW RD.
N. 10°45'00" E.
500' R. & U.
I.P. Fd.-Used
S. 4°14'21" W. 119.59' m.
-014
BRUCE W. McALPIN
PCL. 4 D.V. 1171 P. 177
RMDR. of PCL. -035
0.8787 Ac.
M.B. w/I.P. Used
15-D
15-00-010-000-045
SPLIT OF PARCEL No 15-00-010-000-035
FOR
MICHAEL KEVIN KUEPFER
PART OF O.L. 10
TOWNSHIP OF LAGRANGE
COUNTY OF LORAIN
STATE OF OHIO
DEC. 1996
SCALE 1"=200'
LAUNDON • SIMON • CAHL & ASSOC.
PROFESSIONAL LAND SURVEYORS
JOB 96-2915
F.B. 240/25-26
JOB REF. 94-2630