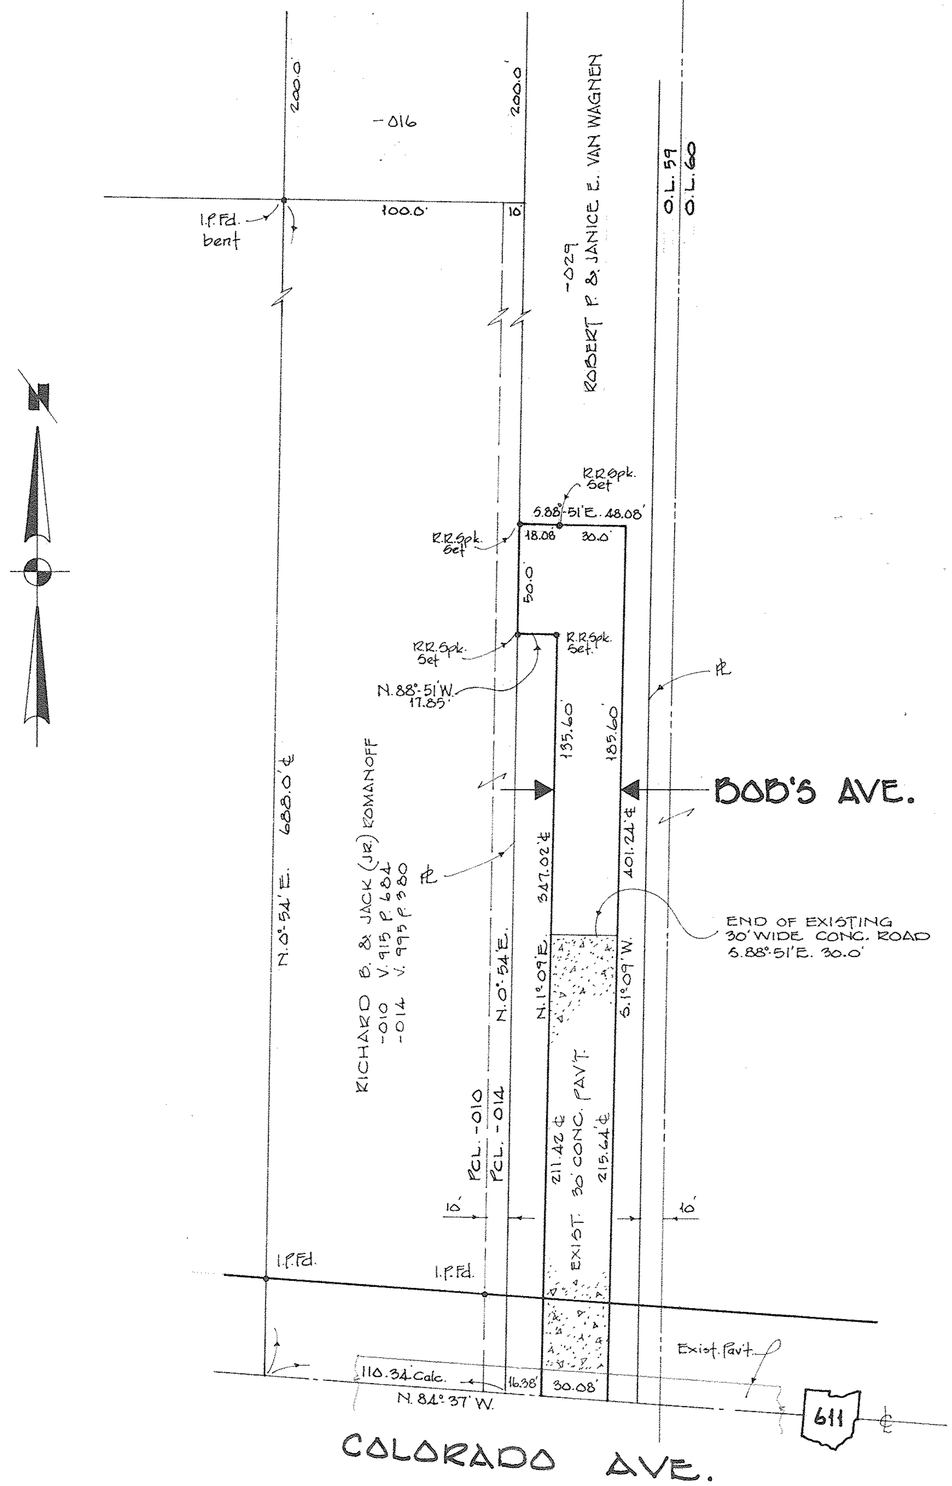

3-00-059-D
03-00-059-000-029

SURVEY OF EASEMENT FOR INGRESS AND EGRESS

VAN WAGNEN TO ROMANOFF

KNOWN AS

BOB'S AVENUE

PART OF O.L. 59 SHEFFIELD TWP. VILLAGE OF SHEFFIELD

COUNTY OF LORAIN STATE OF OHIO

SCALE 1"=50' JULY, 1989

LAUNDON • SIMON • CAHL & ASSOC.
ENGINEERS SURVEYORS

JOB Nº 89-1850