SURVEY FOR

LAWRENCE E. BROOME

PART of S/Ls 1, 3 & 4 BLOCK 6 of TOWN PLAT of WELLINGTON VILLAGE
AS APPEARS IN PLAT VOL. 1 PG. 6

PART of O.L. 28 TOWNSHIP OF WELLINGTON, LORAIN COUNTY, OHIO

LAUNDON • SIMON • CAHL & ASSOC.
PROFESSIONAL LAND SURVEYORS
JOB No: 96-2796 FD. 238 P. 9

REVISE Pcl. 1 & 2 6-7-96

N

SCALE 1" = 20'

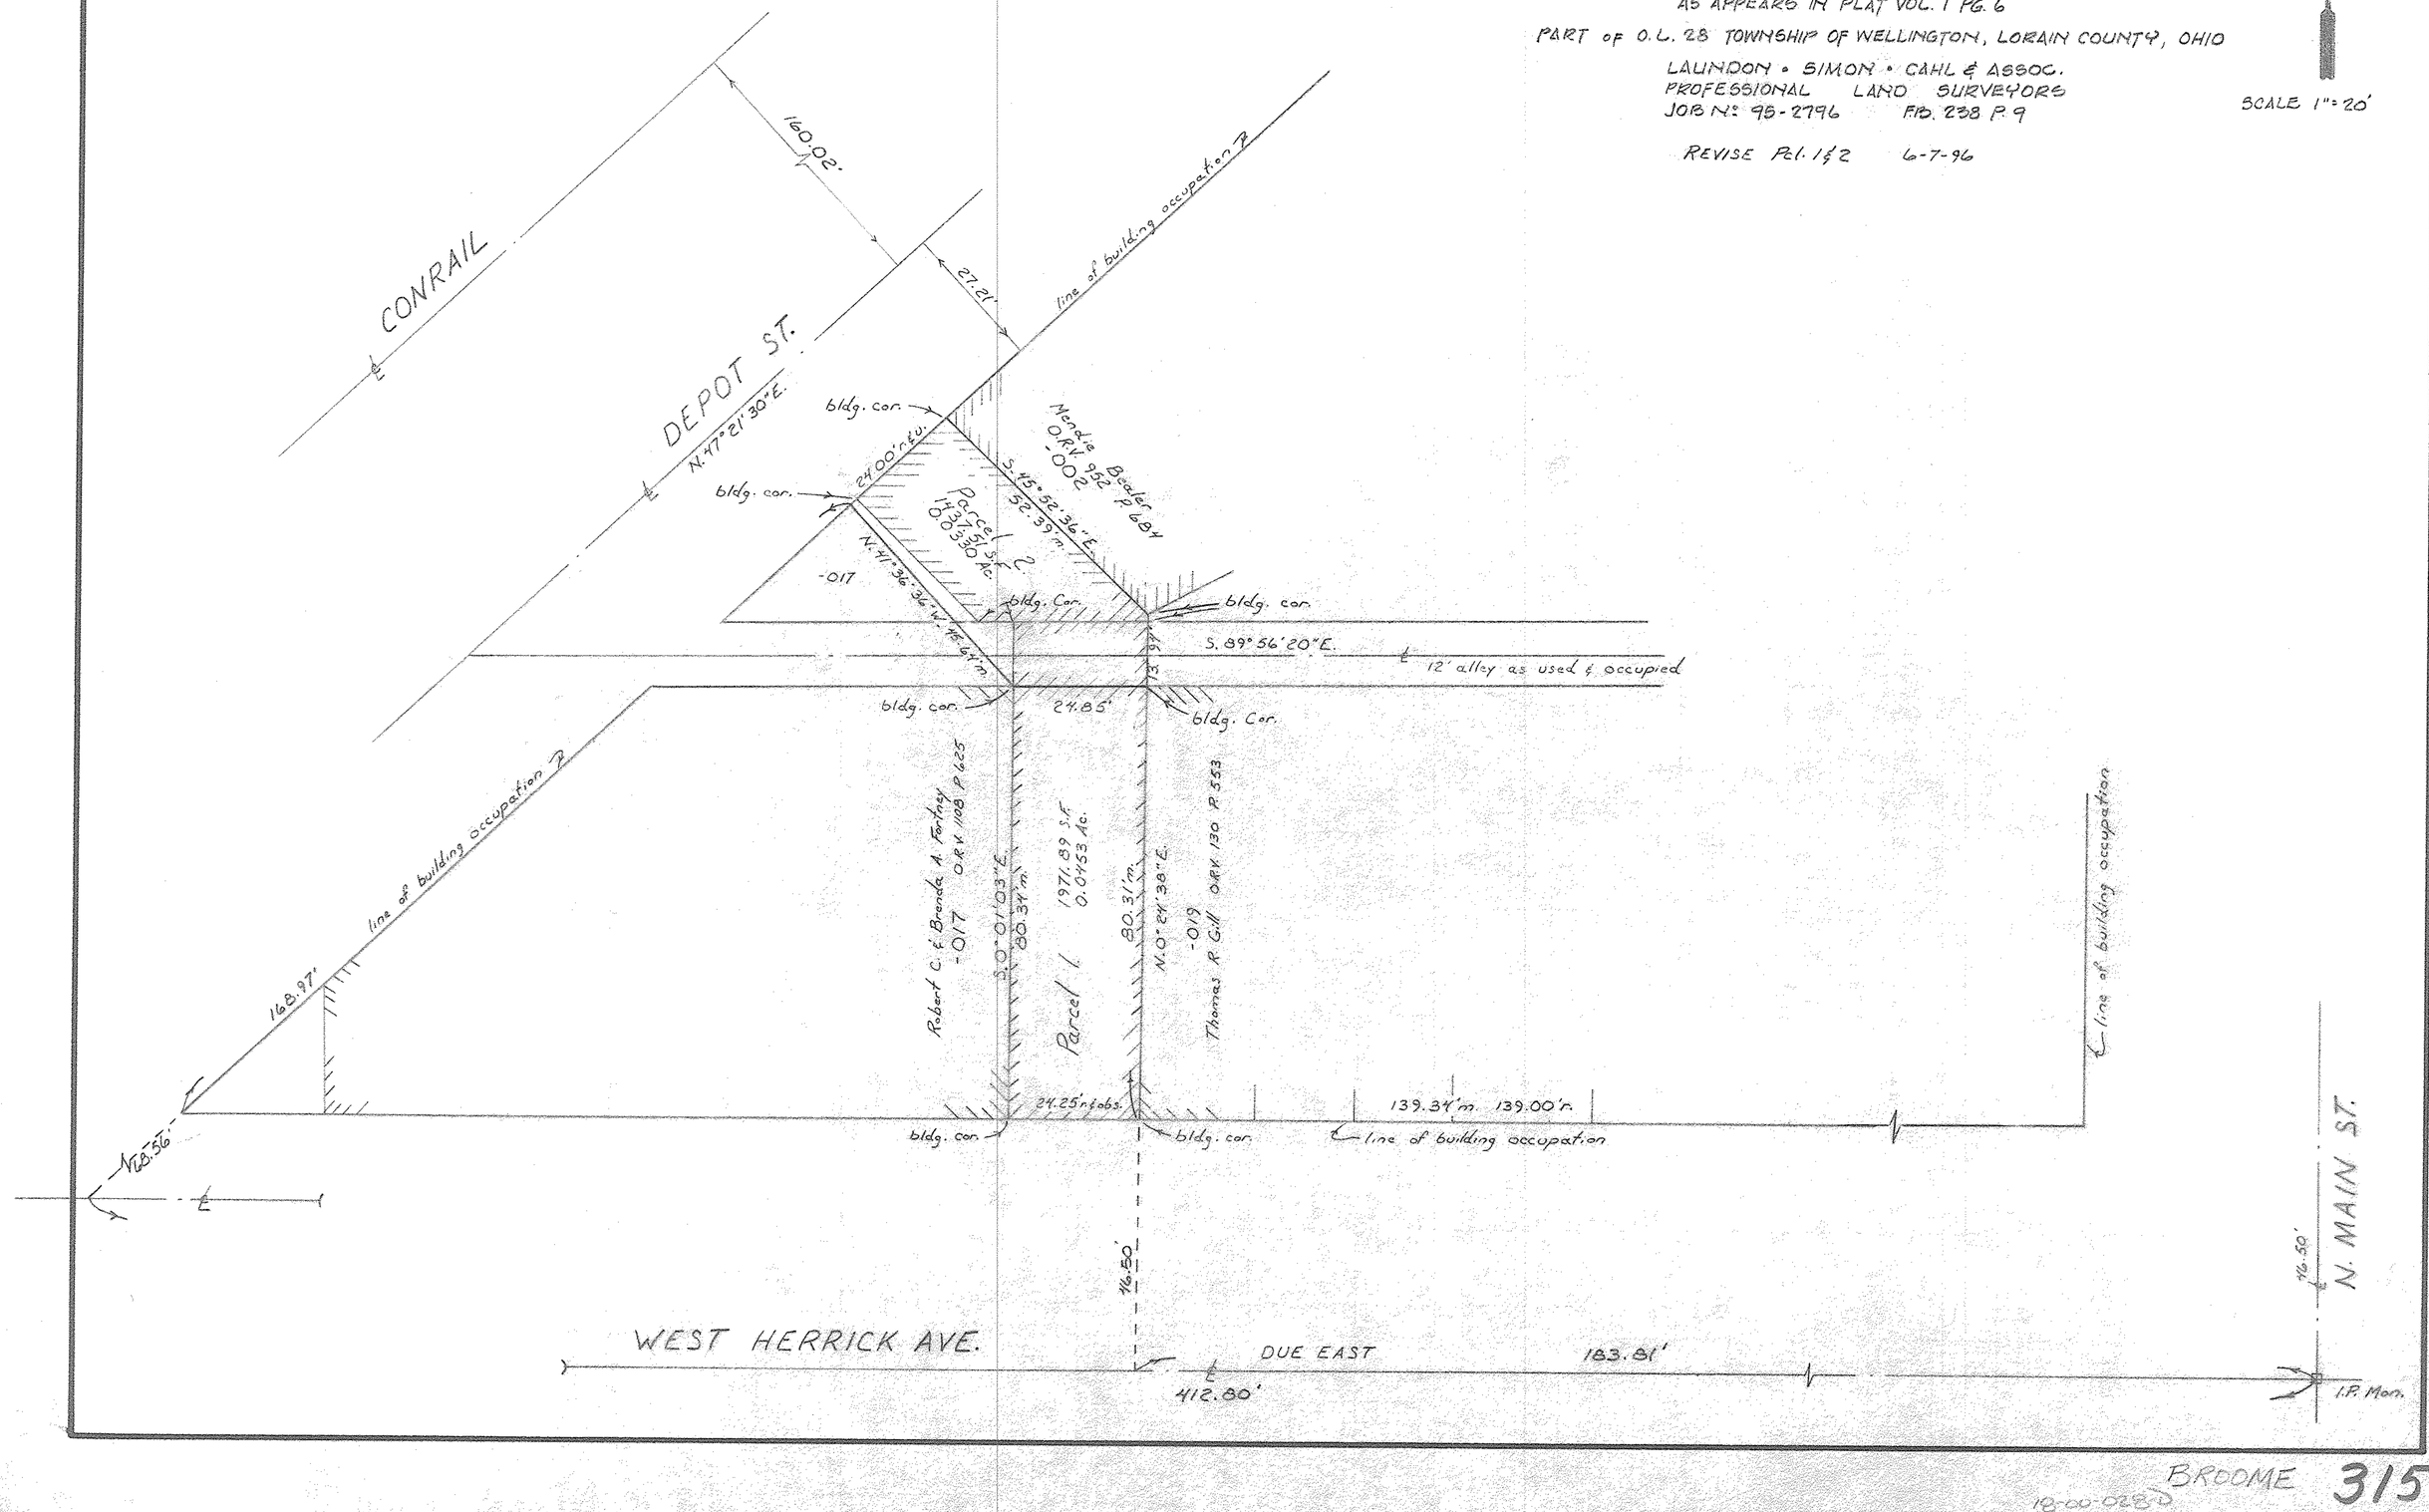

BROOME 315

18-00-028.0
18-00-028-115.027 & 028