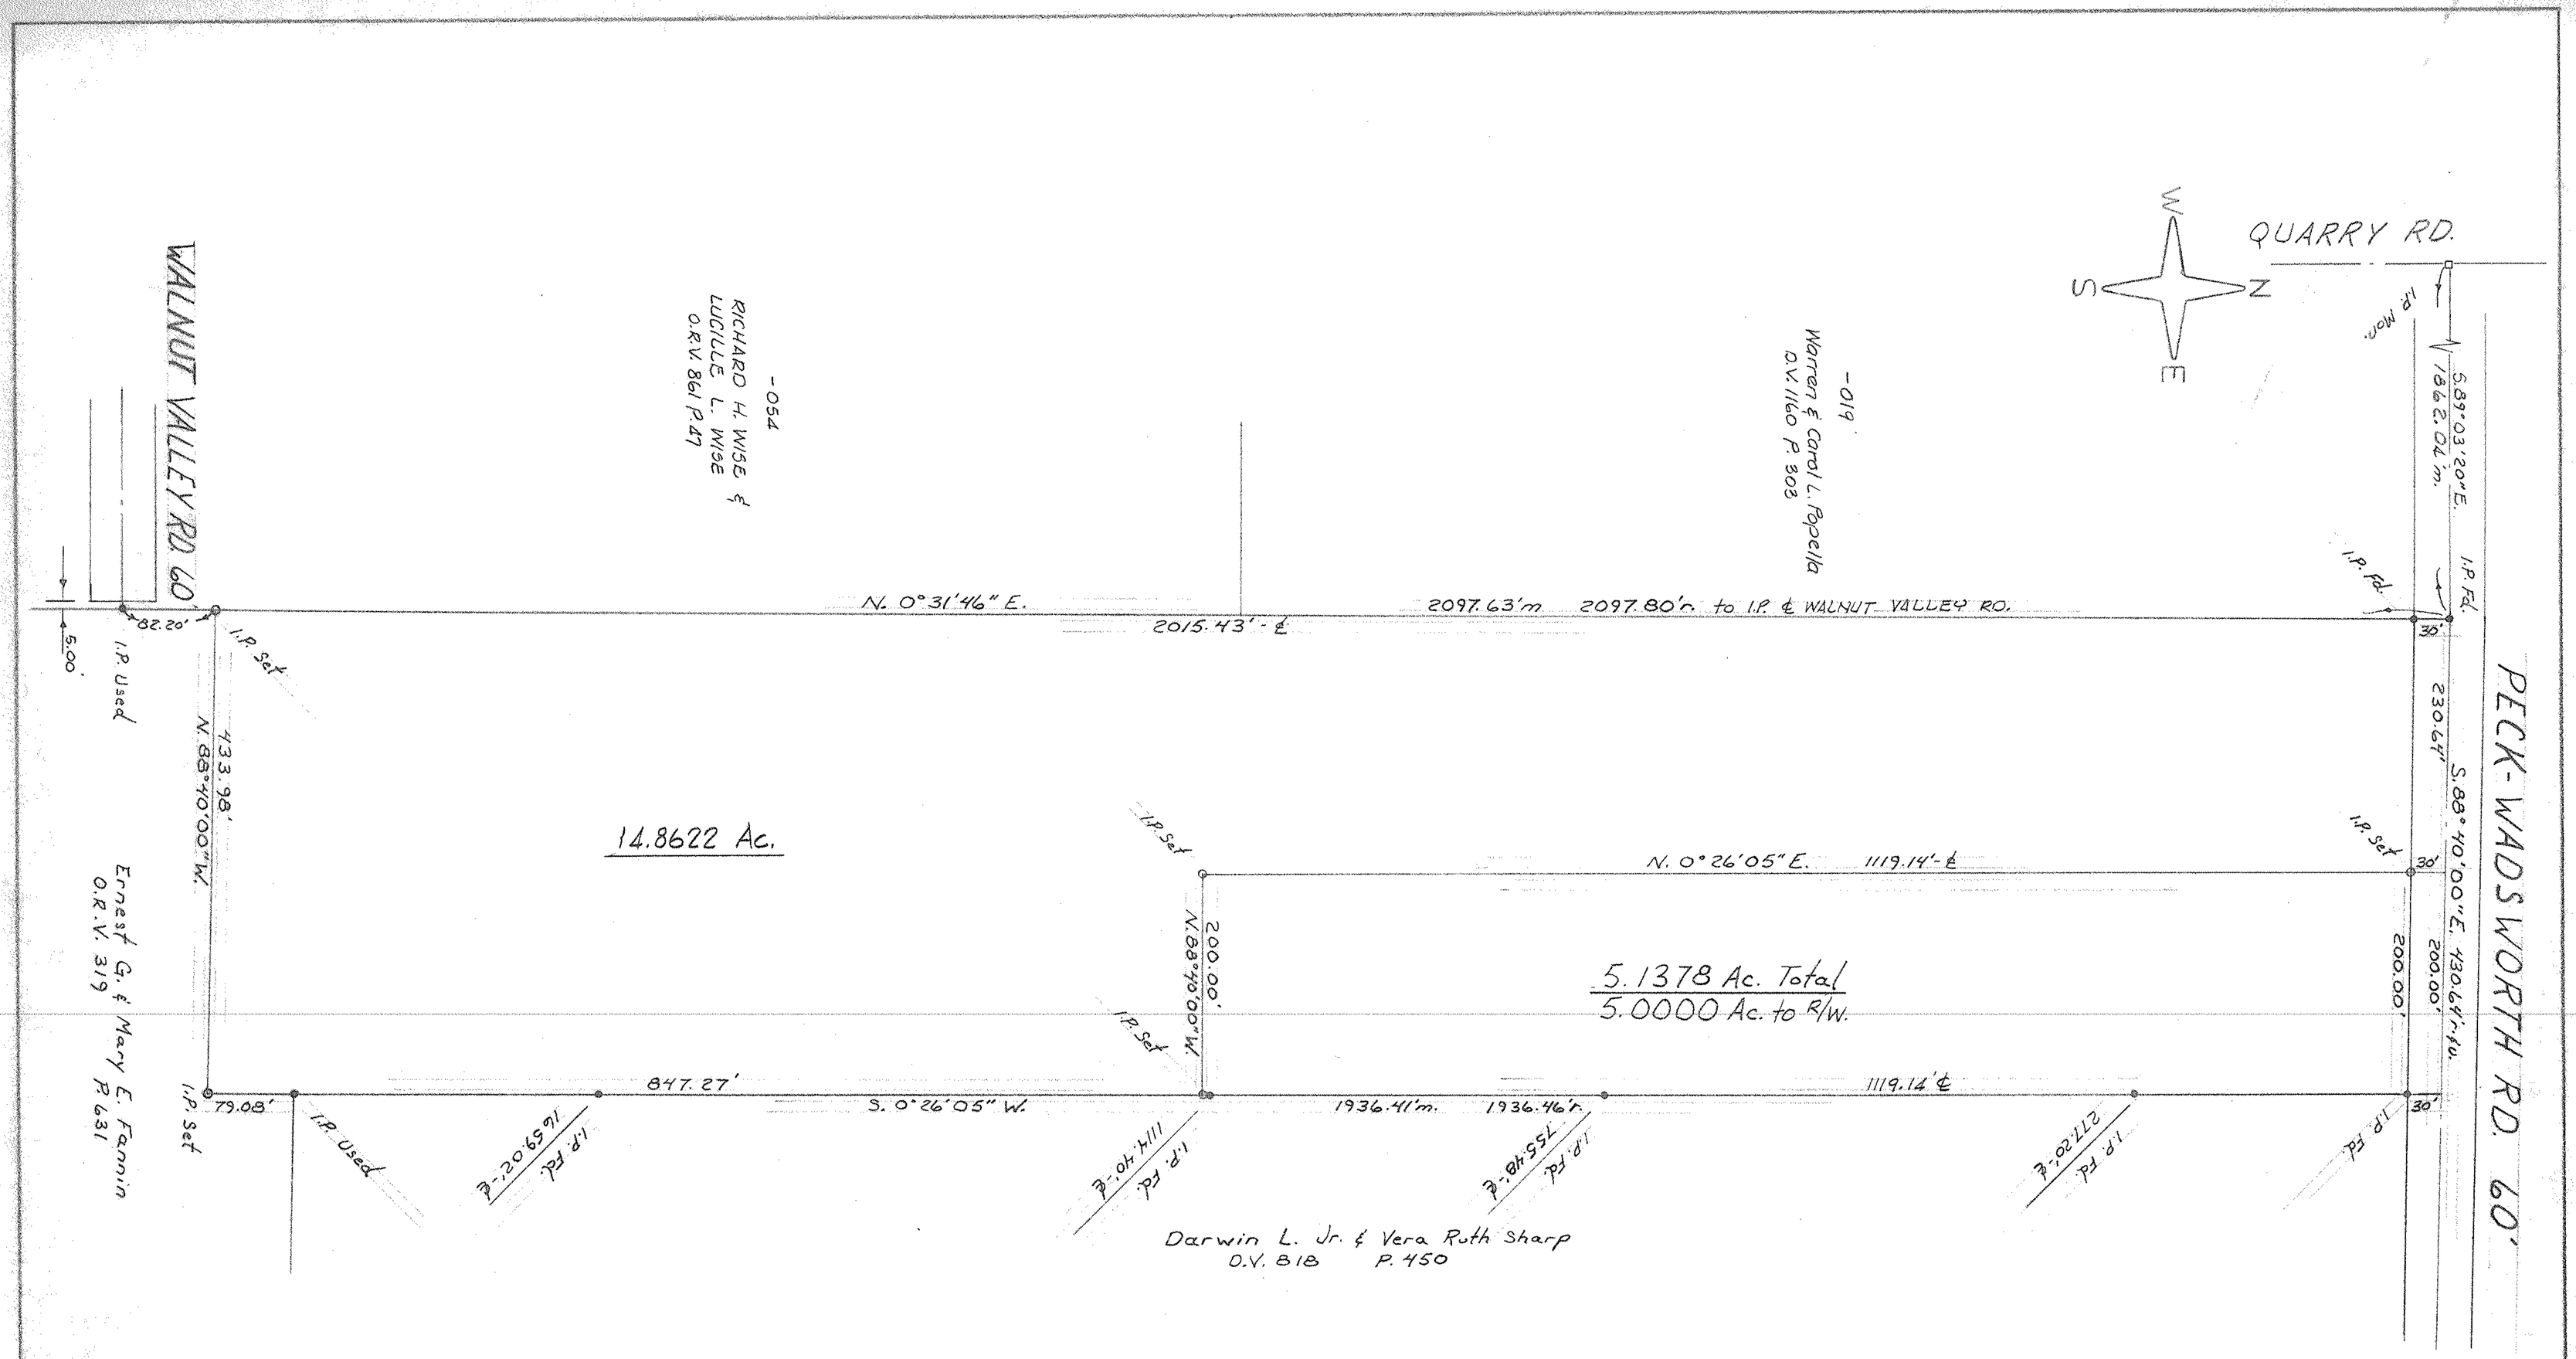

18-00-044-B
18-00-044-000-003

SURVEY FOR

WARREN & CAROL L. POPELLA

PART OF O.L. 44 TOWNSHIP OF WELLINGTON

COUNTY OF LORAIN STATE OF OHIO

SCALE 1"=100' MARCH, 1997

LAUNDON • SIMON • CAHL & ASSOC.

PROFESSIONAL LAND SURVEYORS

JOB Nº 97-2926 F.B. 240 P. 50