06-26-074-000-006
007
004
005
6-119

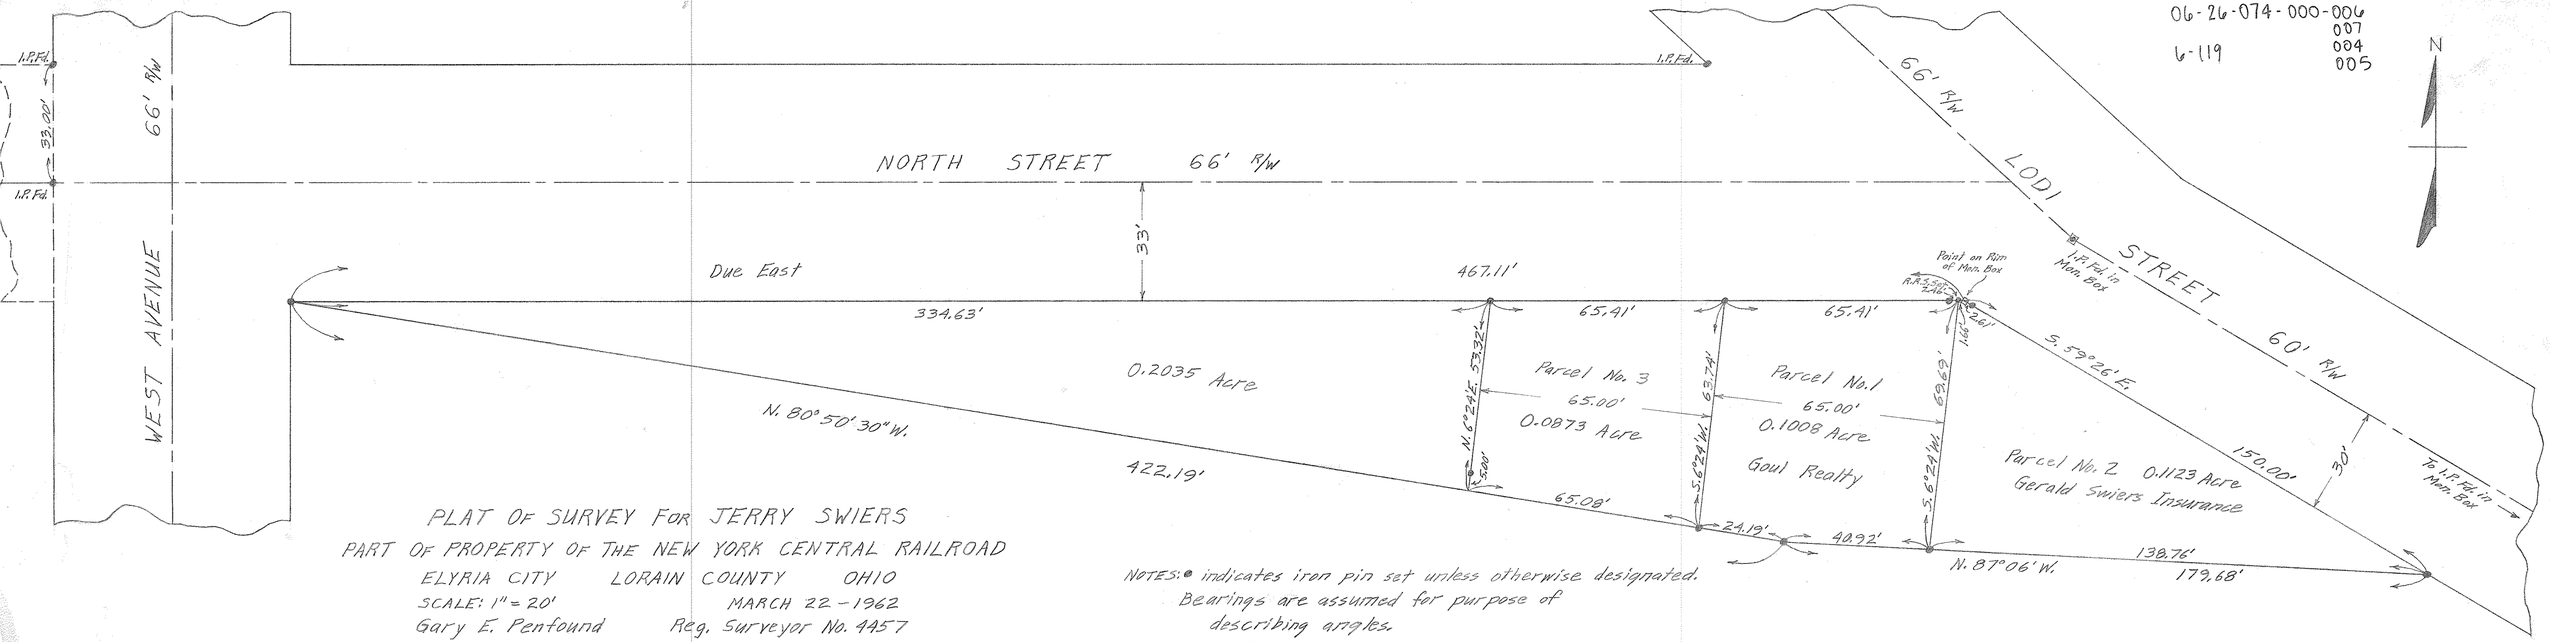

PLAT OF SURVEY FOR JERRY SWIERS
PART OF PROPERTY OF THE NEW YORK CENTRAL RAILROAD
ELYRIA CITY LORAIN COUNTY OHIO
SCALE: 1" = 20' MARCH 22 - 1962
Gary E. Penfound Reg. Surveyor No. 4457
REVISED SEPTEMBER 26-1962 FOR PARCELS NO'S. 1-2 & 3

NOTES: ● indicates iron pin set unless otherwise designated.
Bearings are assumed for purpose of describing angles.
REVISED MAY 1, 1963 — Showing iron pins in place or reset after grading.

06-26-074