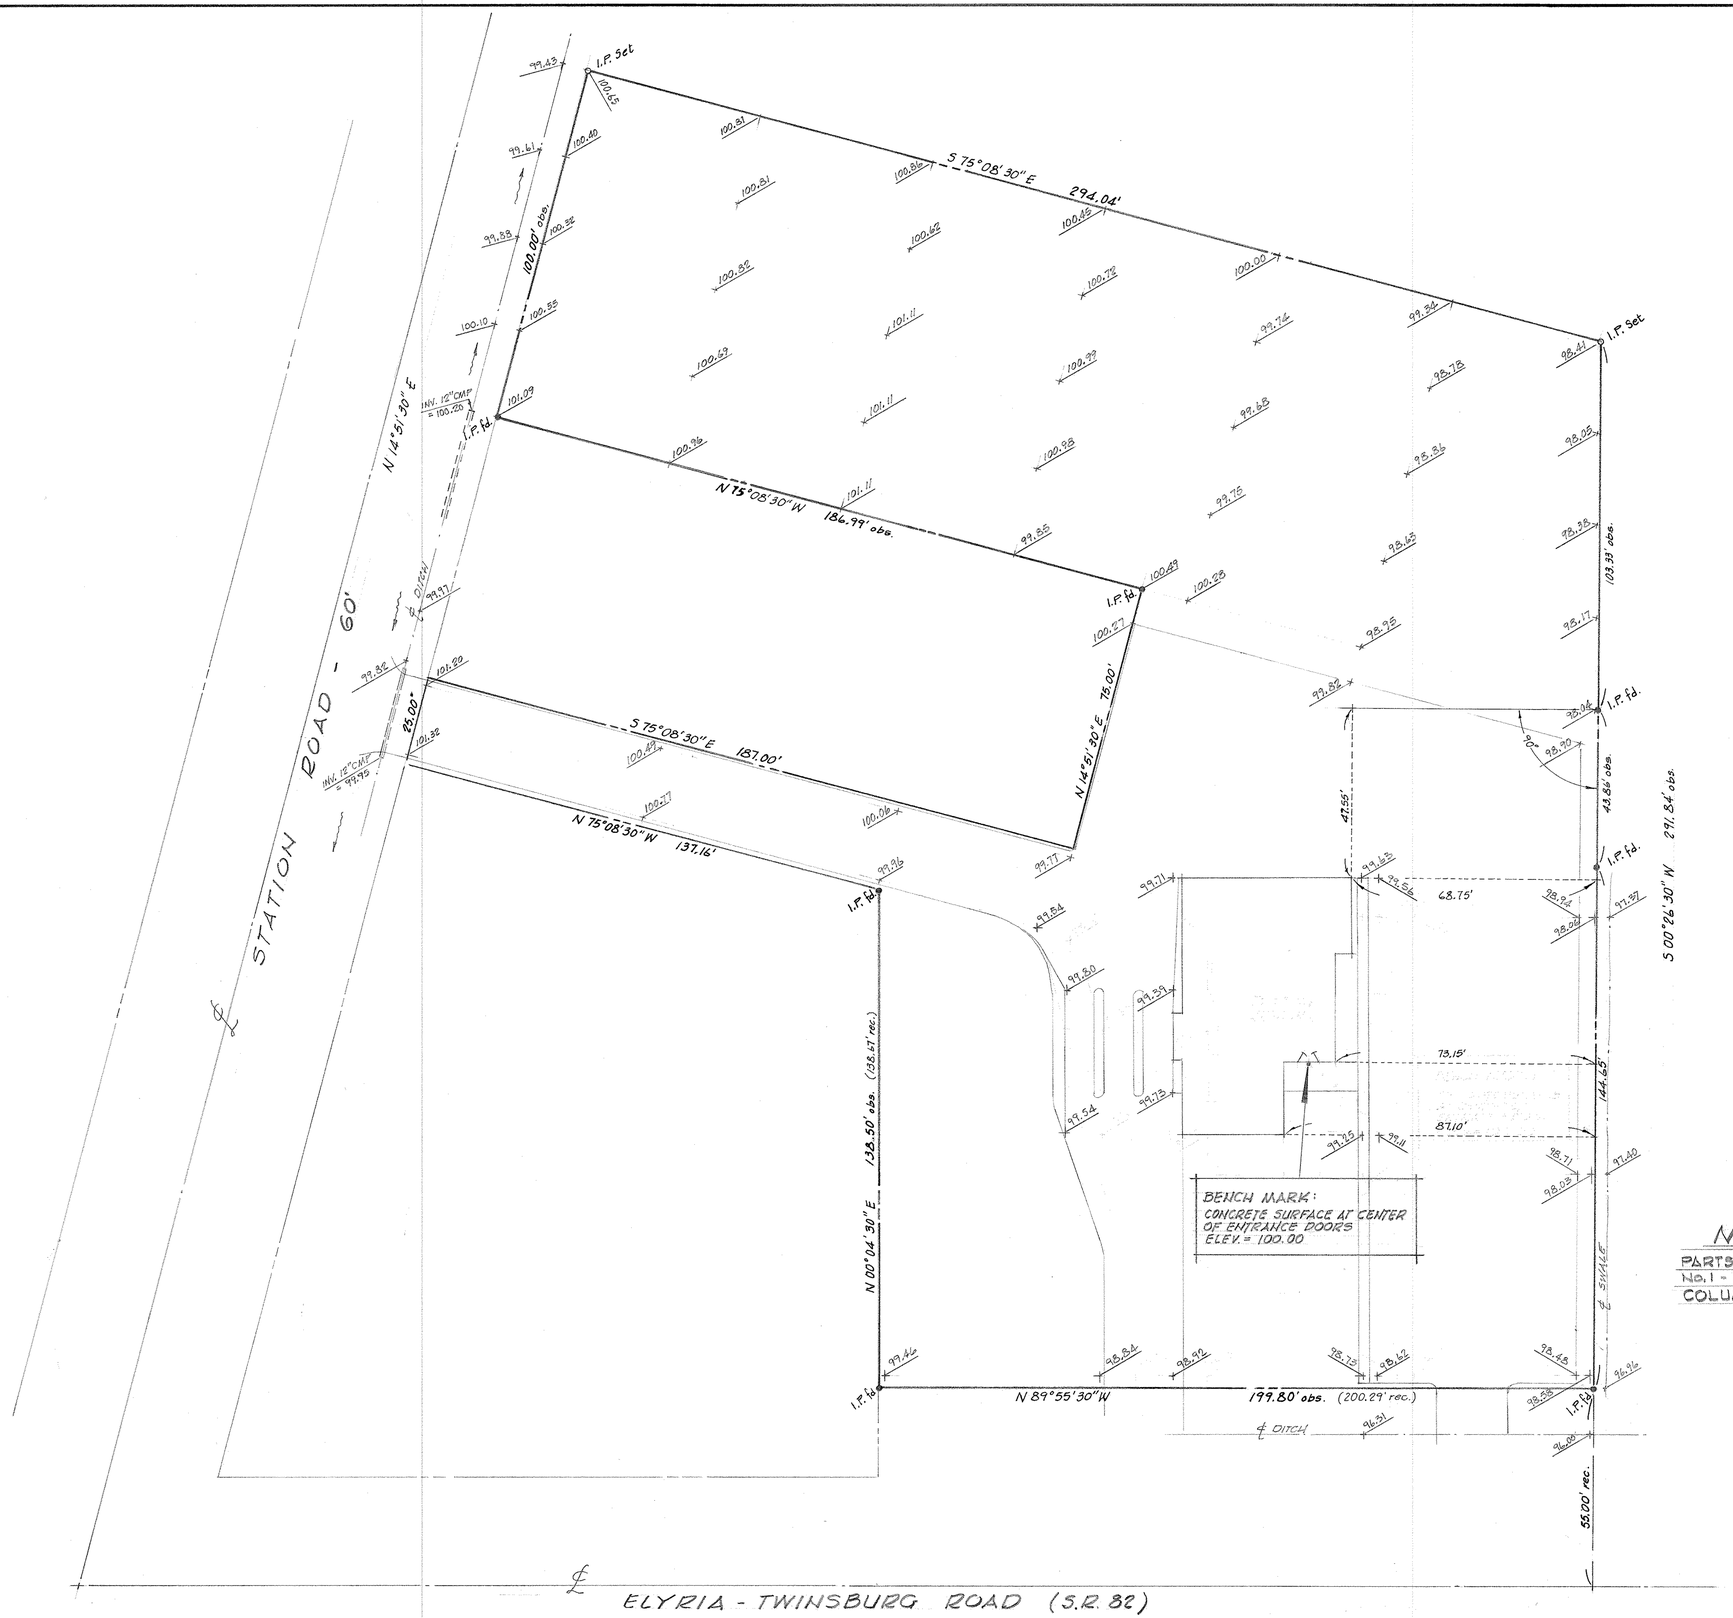

MAP of SURVEY

PARTS of SUBLOTS 4,5 and 6, HUMMON SUBDIVISION
No. 1 - Vol. 16 Pg. 13 and PART of ORIGINAL LOT 76
COLUMBIA TOWNSHIP, LORAIN COUNTY, OHIO

12-00-076-B
12-00-076-103-024 → -027, -029

McGLINCHY and ASSOCIATES
REGISTERED ENGINEERS & SURVEYORS
538 W. BROAD ST., ELYRIA, OHIO
JUNE 21, 1977 JOB# 772054