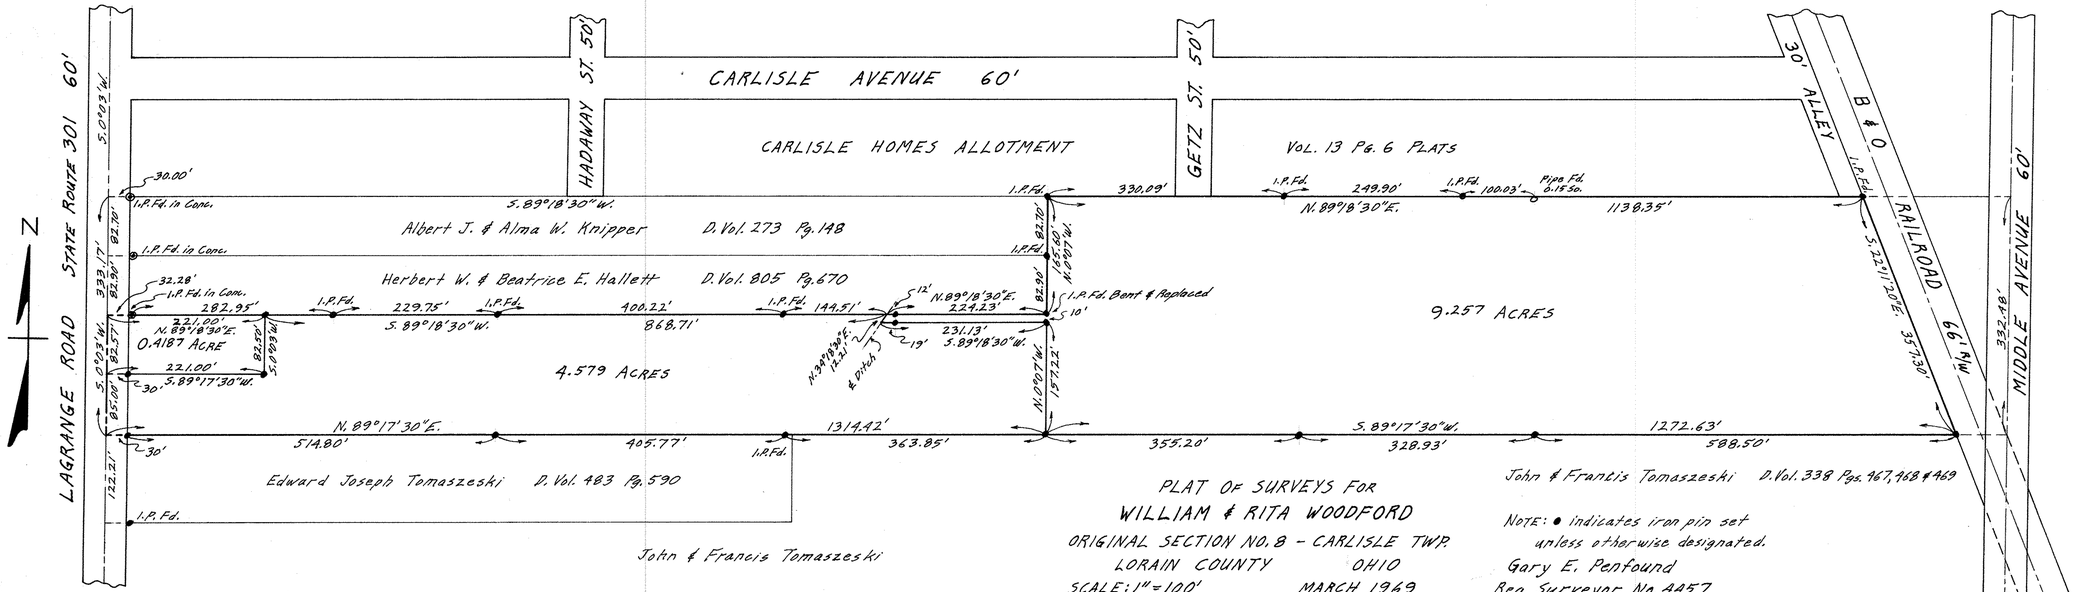

PLAT OF SURVEYS FOR
WILLIAM & RITA WOODFORD
ORIGINAL SECTION NO. 8 - CARLISLE TWP.
LORAIN COUNTY OHIO
SCALE: 1" = 100' MARCH 1969

NOTE: ● indicates iron pin set unless otherwise designated.

Gary E. Penfound
Reg. Surveyor No. 4957

-036 10-00-008-
10-00-008-114-039 10-00-008-

10-00-008