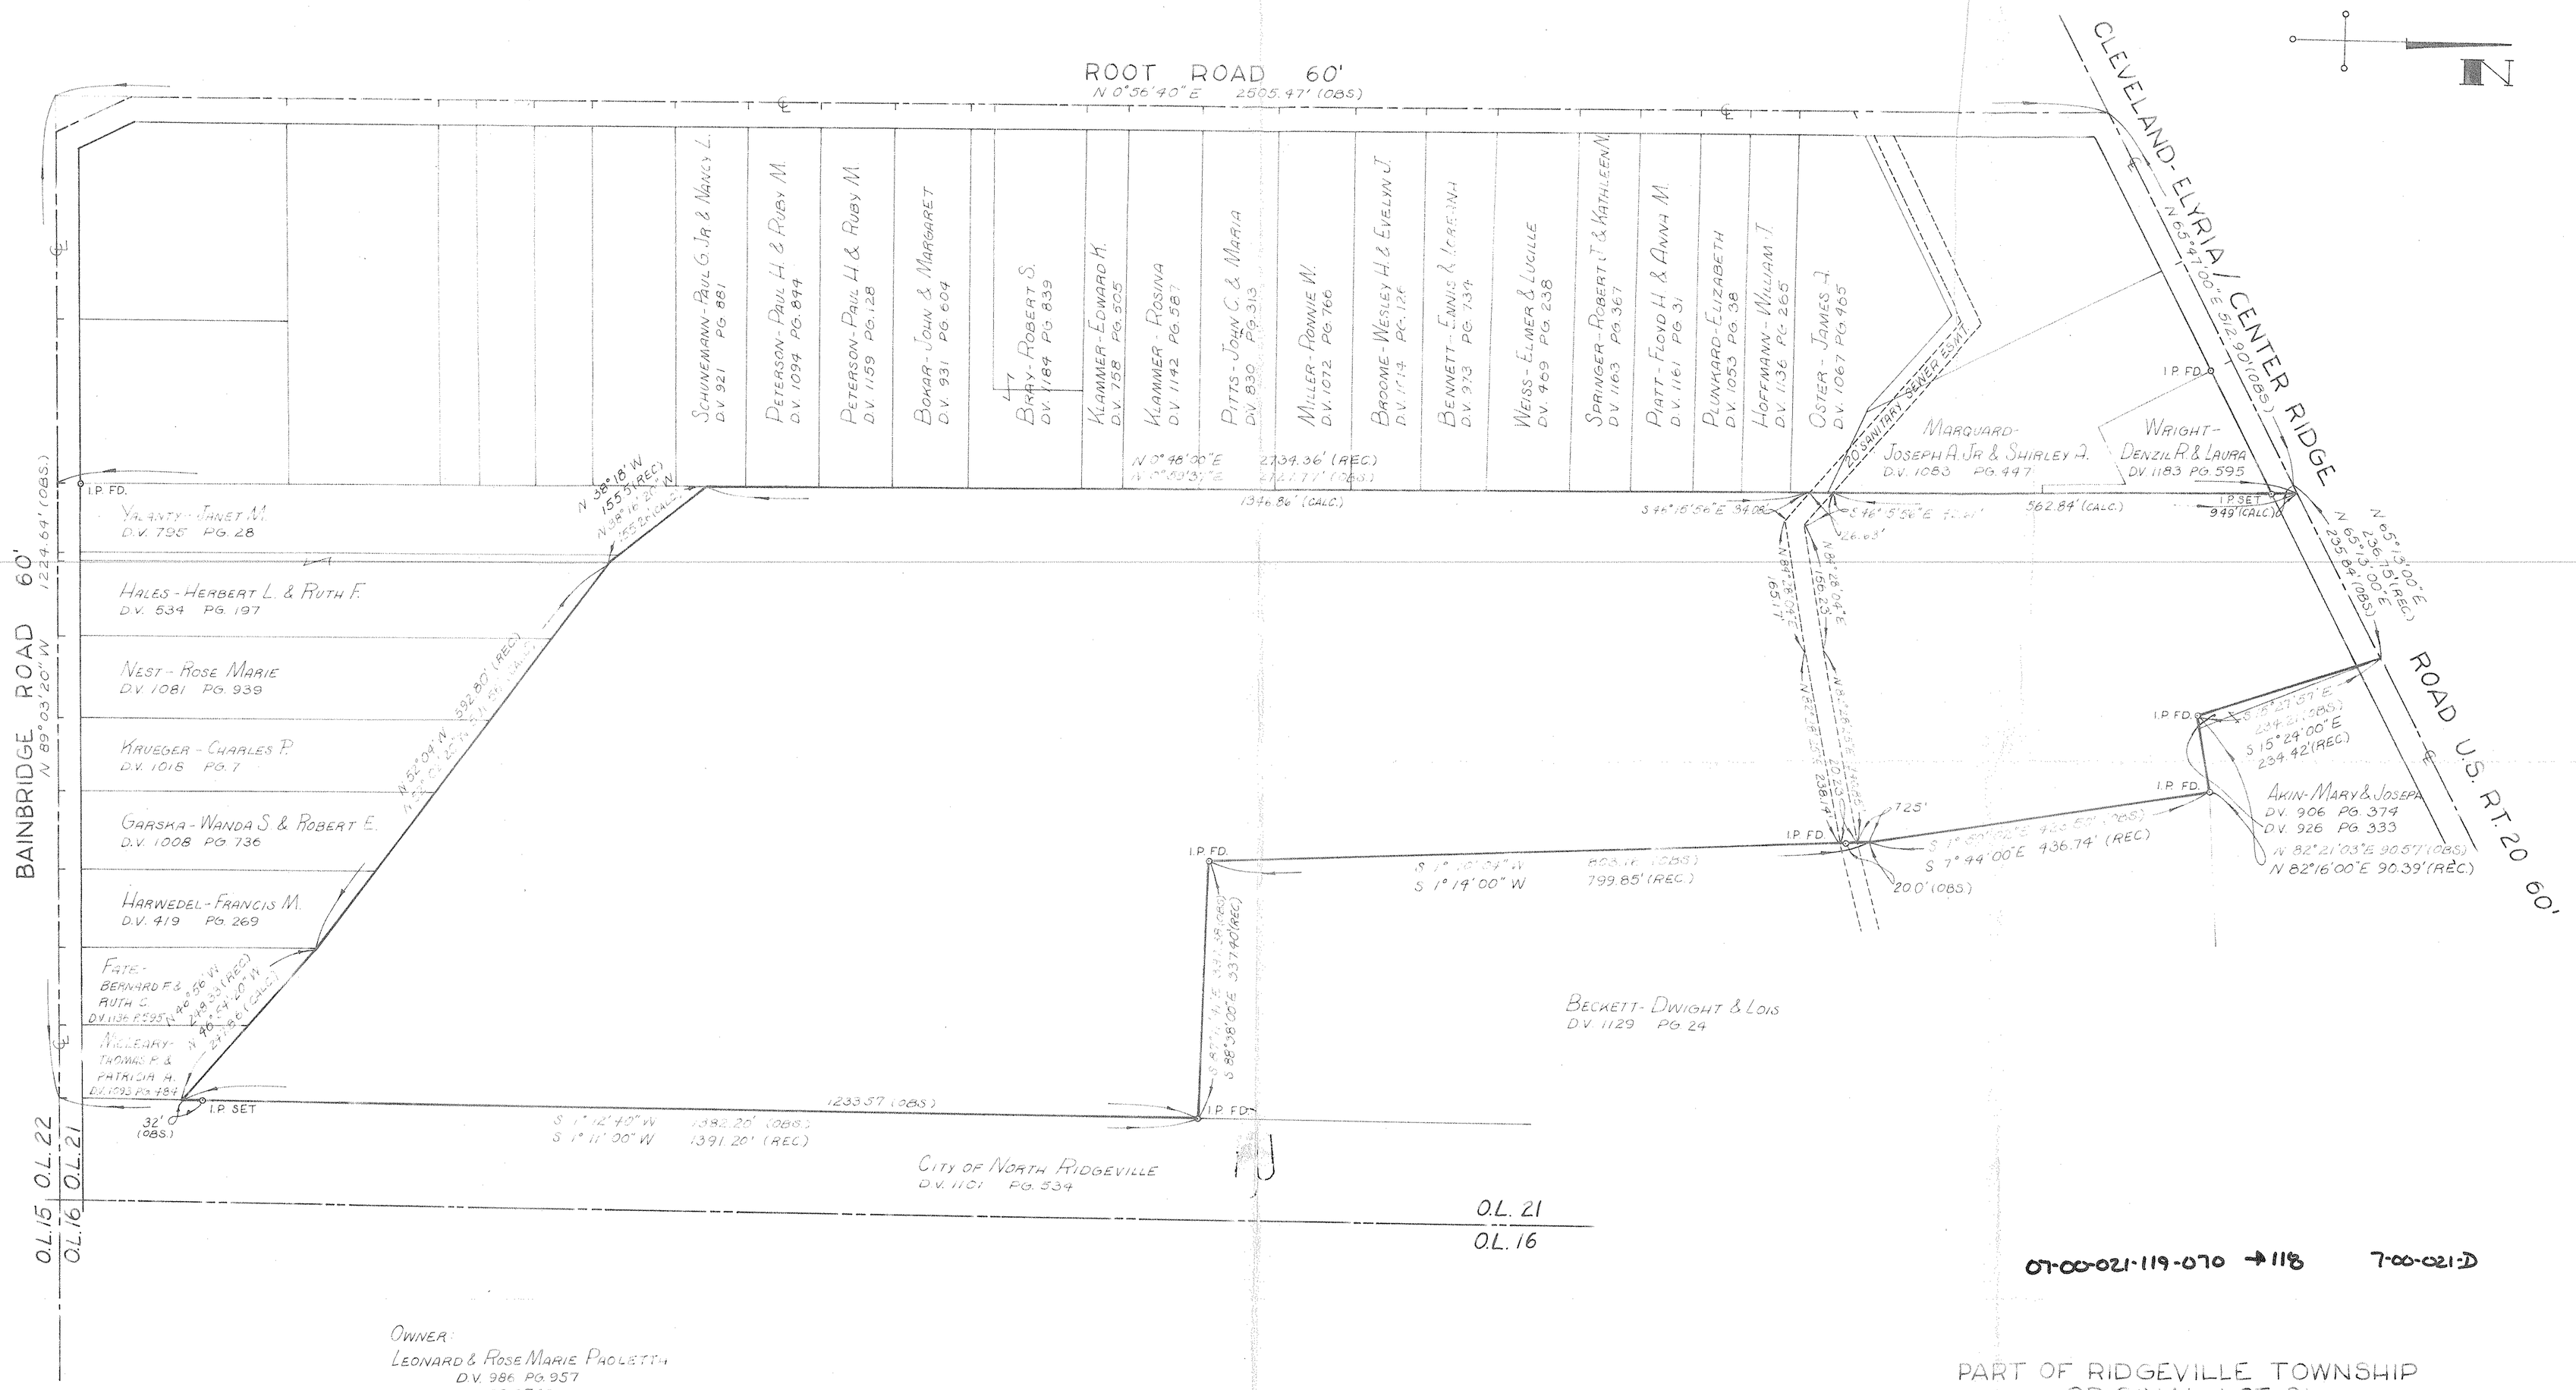

Owner:
Leonard & Rose Marie Paoletti
D.V. 986 PG. 957
28.65 Ac.

Note:
Boundary Data Designated "Rec." Are Deed Bearings and Distances

PART OF RIDGEVILLE TOWNSHIP
ORIGINAL LOT 21

CITY OF NORTH RIDGEVILLE
COUNTY OF LORAIN
STATE OF OHIO

SCALE: 1" = 100' JULY 1978

REVISIONS
8-7-78

PREPARED BY
KLEINOEDER - SCHMIDT & ASSOC.
CONSULTING ENGINEERS AND SURVEYORS

78-114