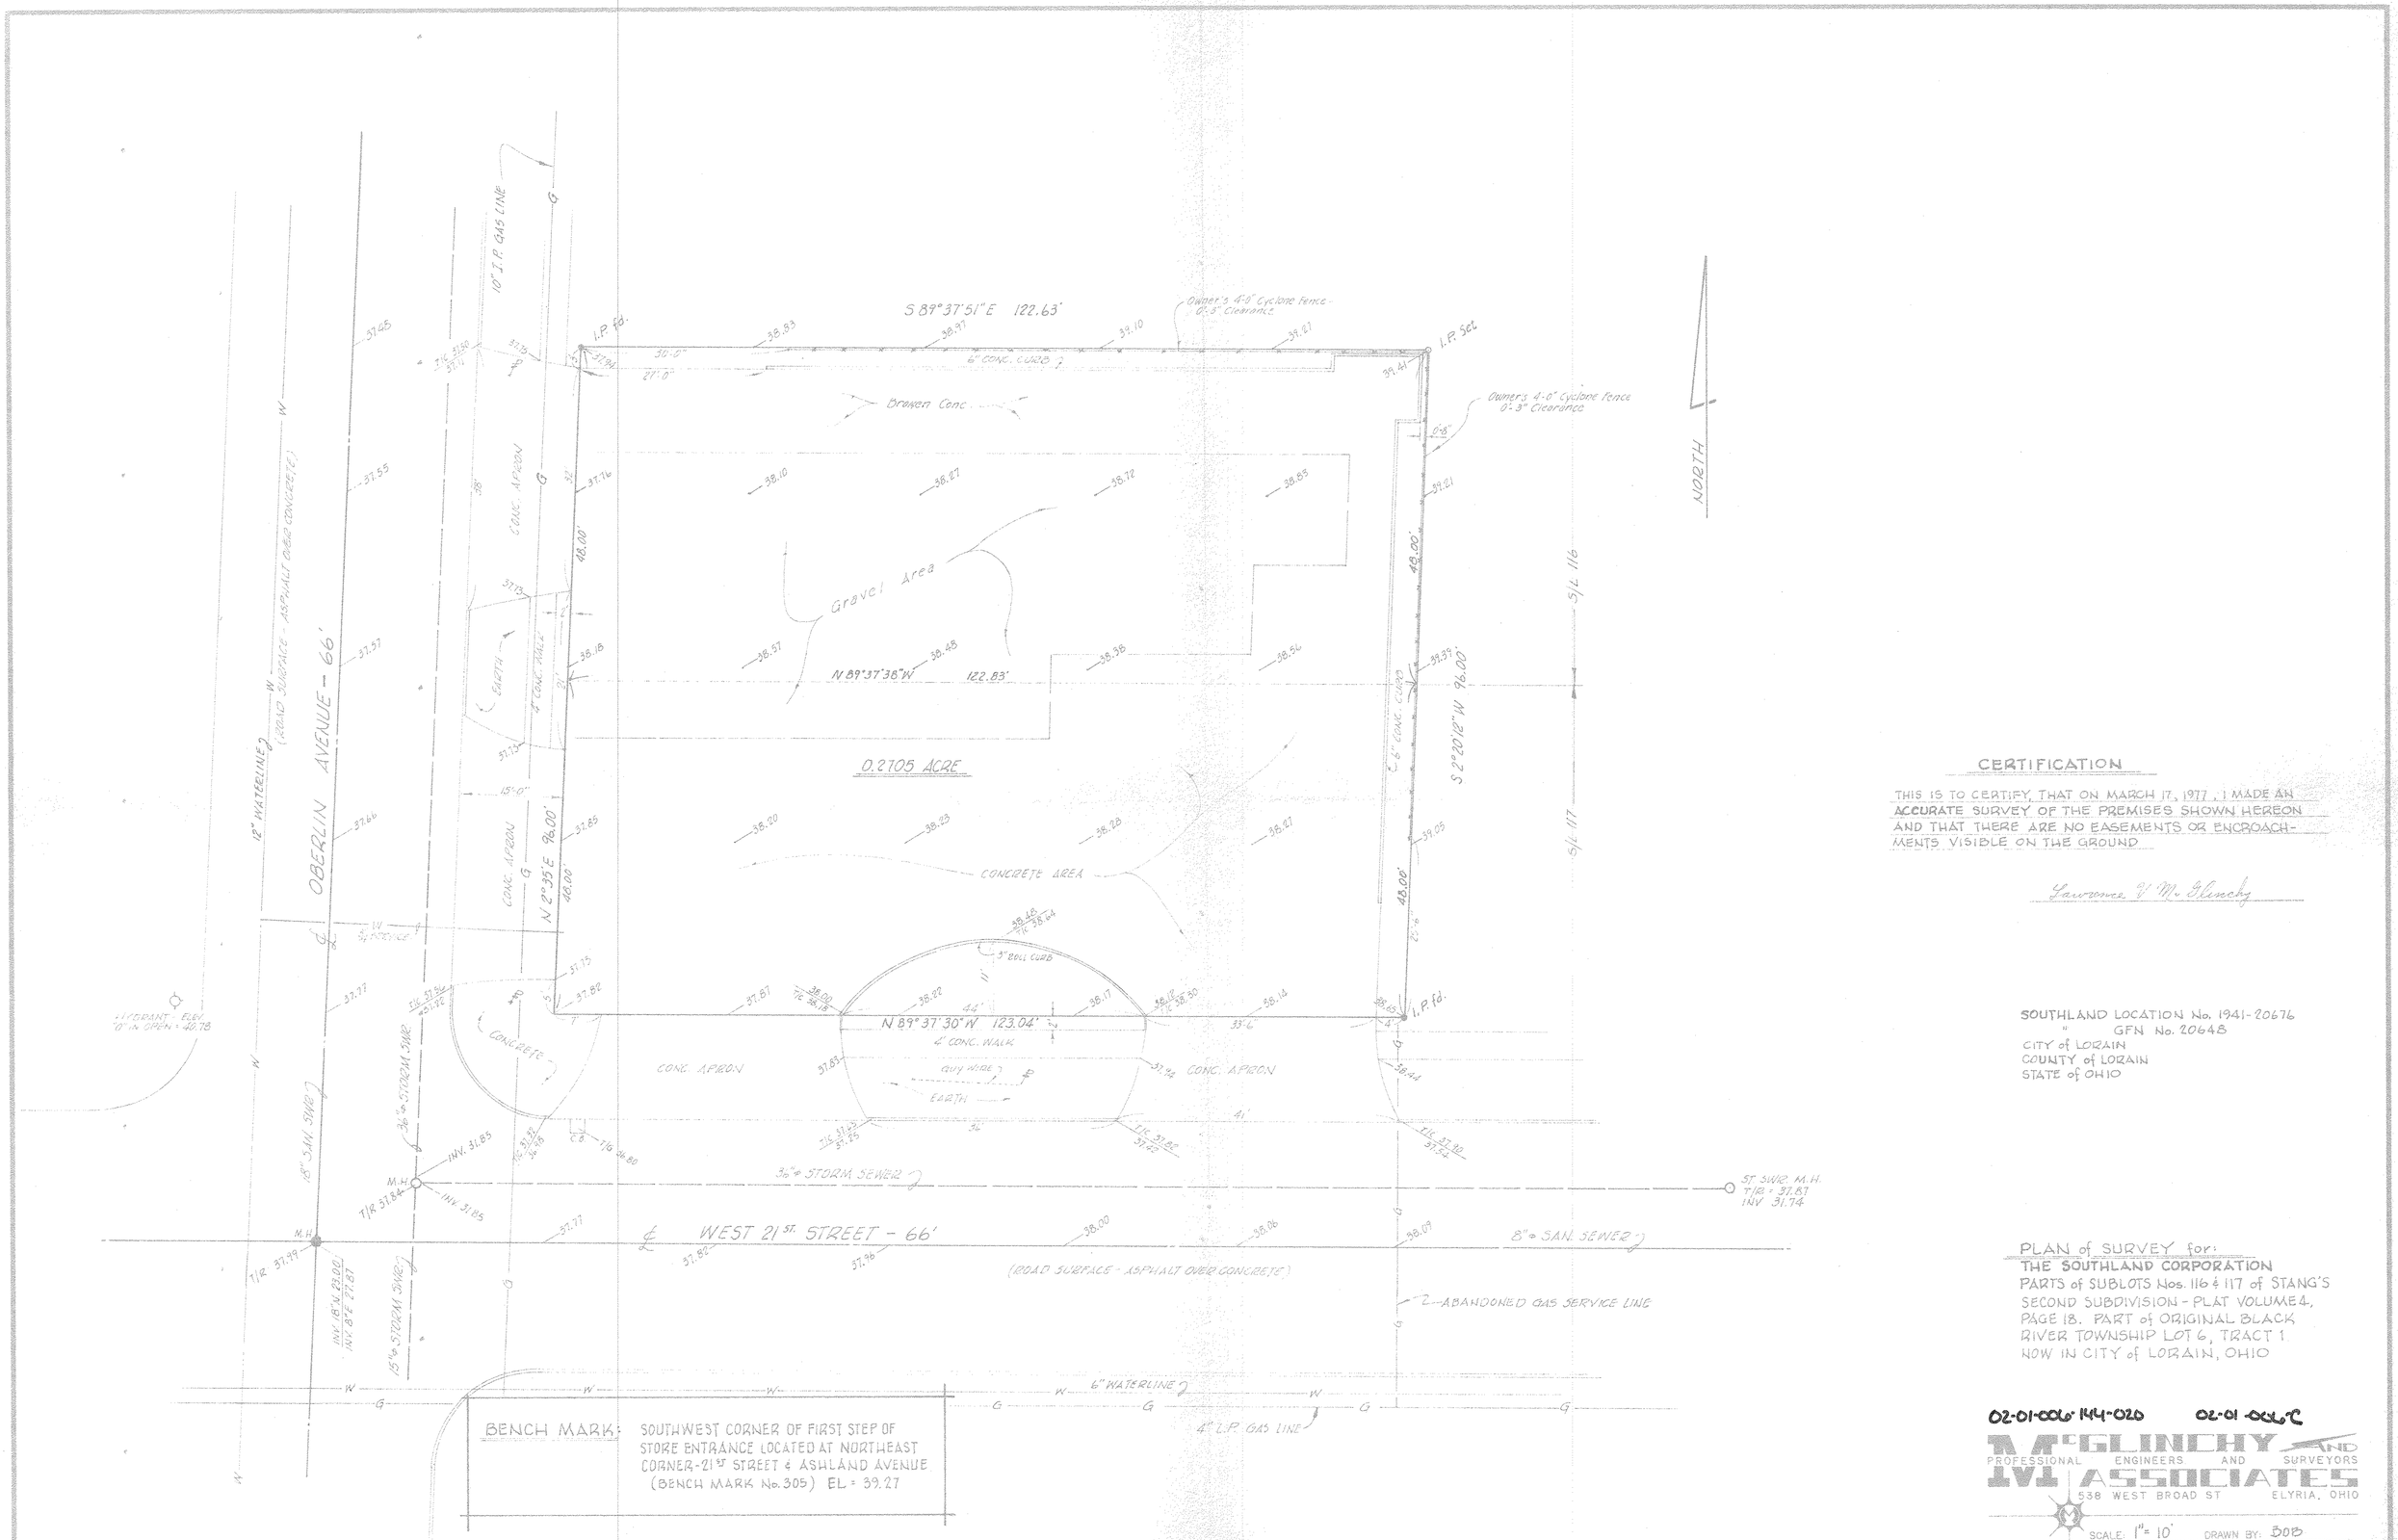

BENCH MARK: SOUTHWEST CORNER OF FIRST STEP OF STORE ENTRANCE LOCATED AT NORTHEAST CORNER-21ST STREET & ASHLAND AVENUE (BENCH MARK No. 305) EL = 39.27

CERTIFICATION

THIS IS TO CERTIFY THAT ON MARCH 17, 1977, I MADE AN ACCURATE SURVEY OF THE PREMISES SHOWN HEREON AND THAT THERE ARE NO EASEMENTS OR ENCROACHMENTS VISIBLE ON THE GROUND

Lawrence V. McGlinchy

SOUTHLAND LOCATION No. 1941-20676
" GFN No. 20648
CITY of LORAIN
COUNTY of LORAIN
STATE of OHIO

PLAN of SURVEY for:
THE SOUTHLAND CORPORATION
PARTS of SUBLOTS Nos. 116 & 117 of STANG'S SECOND SUBDIVISION - PLAT VOLUME 4, PAGE 18. PART of ORIGINAL BLACK RIVER TOWNSHIP LOT 6, TRACT 1
NOW IN CITY of LORAIN, OHIO

02-01-006-144-020 02-01-006-C

McGLINCHY AND ASSOCIATES
PROFESSIONAL ENGINEERS AND SURVEYORS
538 WEST BROAD ST ELYRIA, OHIO

SCALE: 1" = 10' DRAWN BY: BOB
DATE: 3-21-78 JOB NO. 782956
REV. 4-7-78