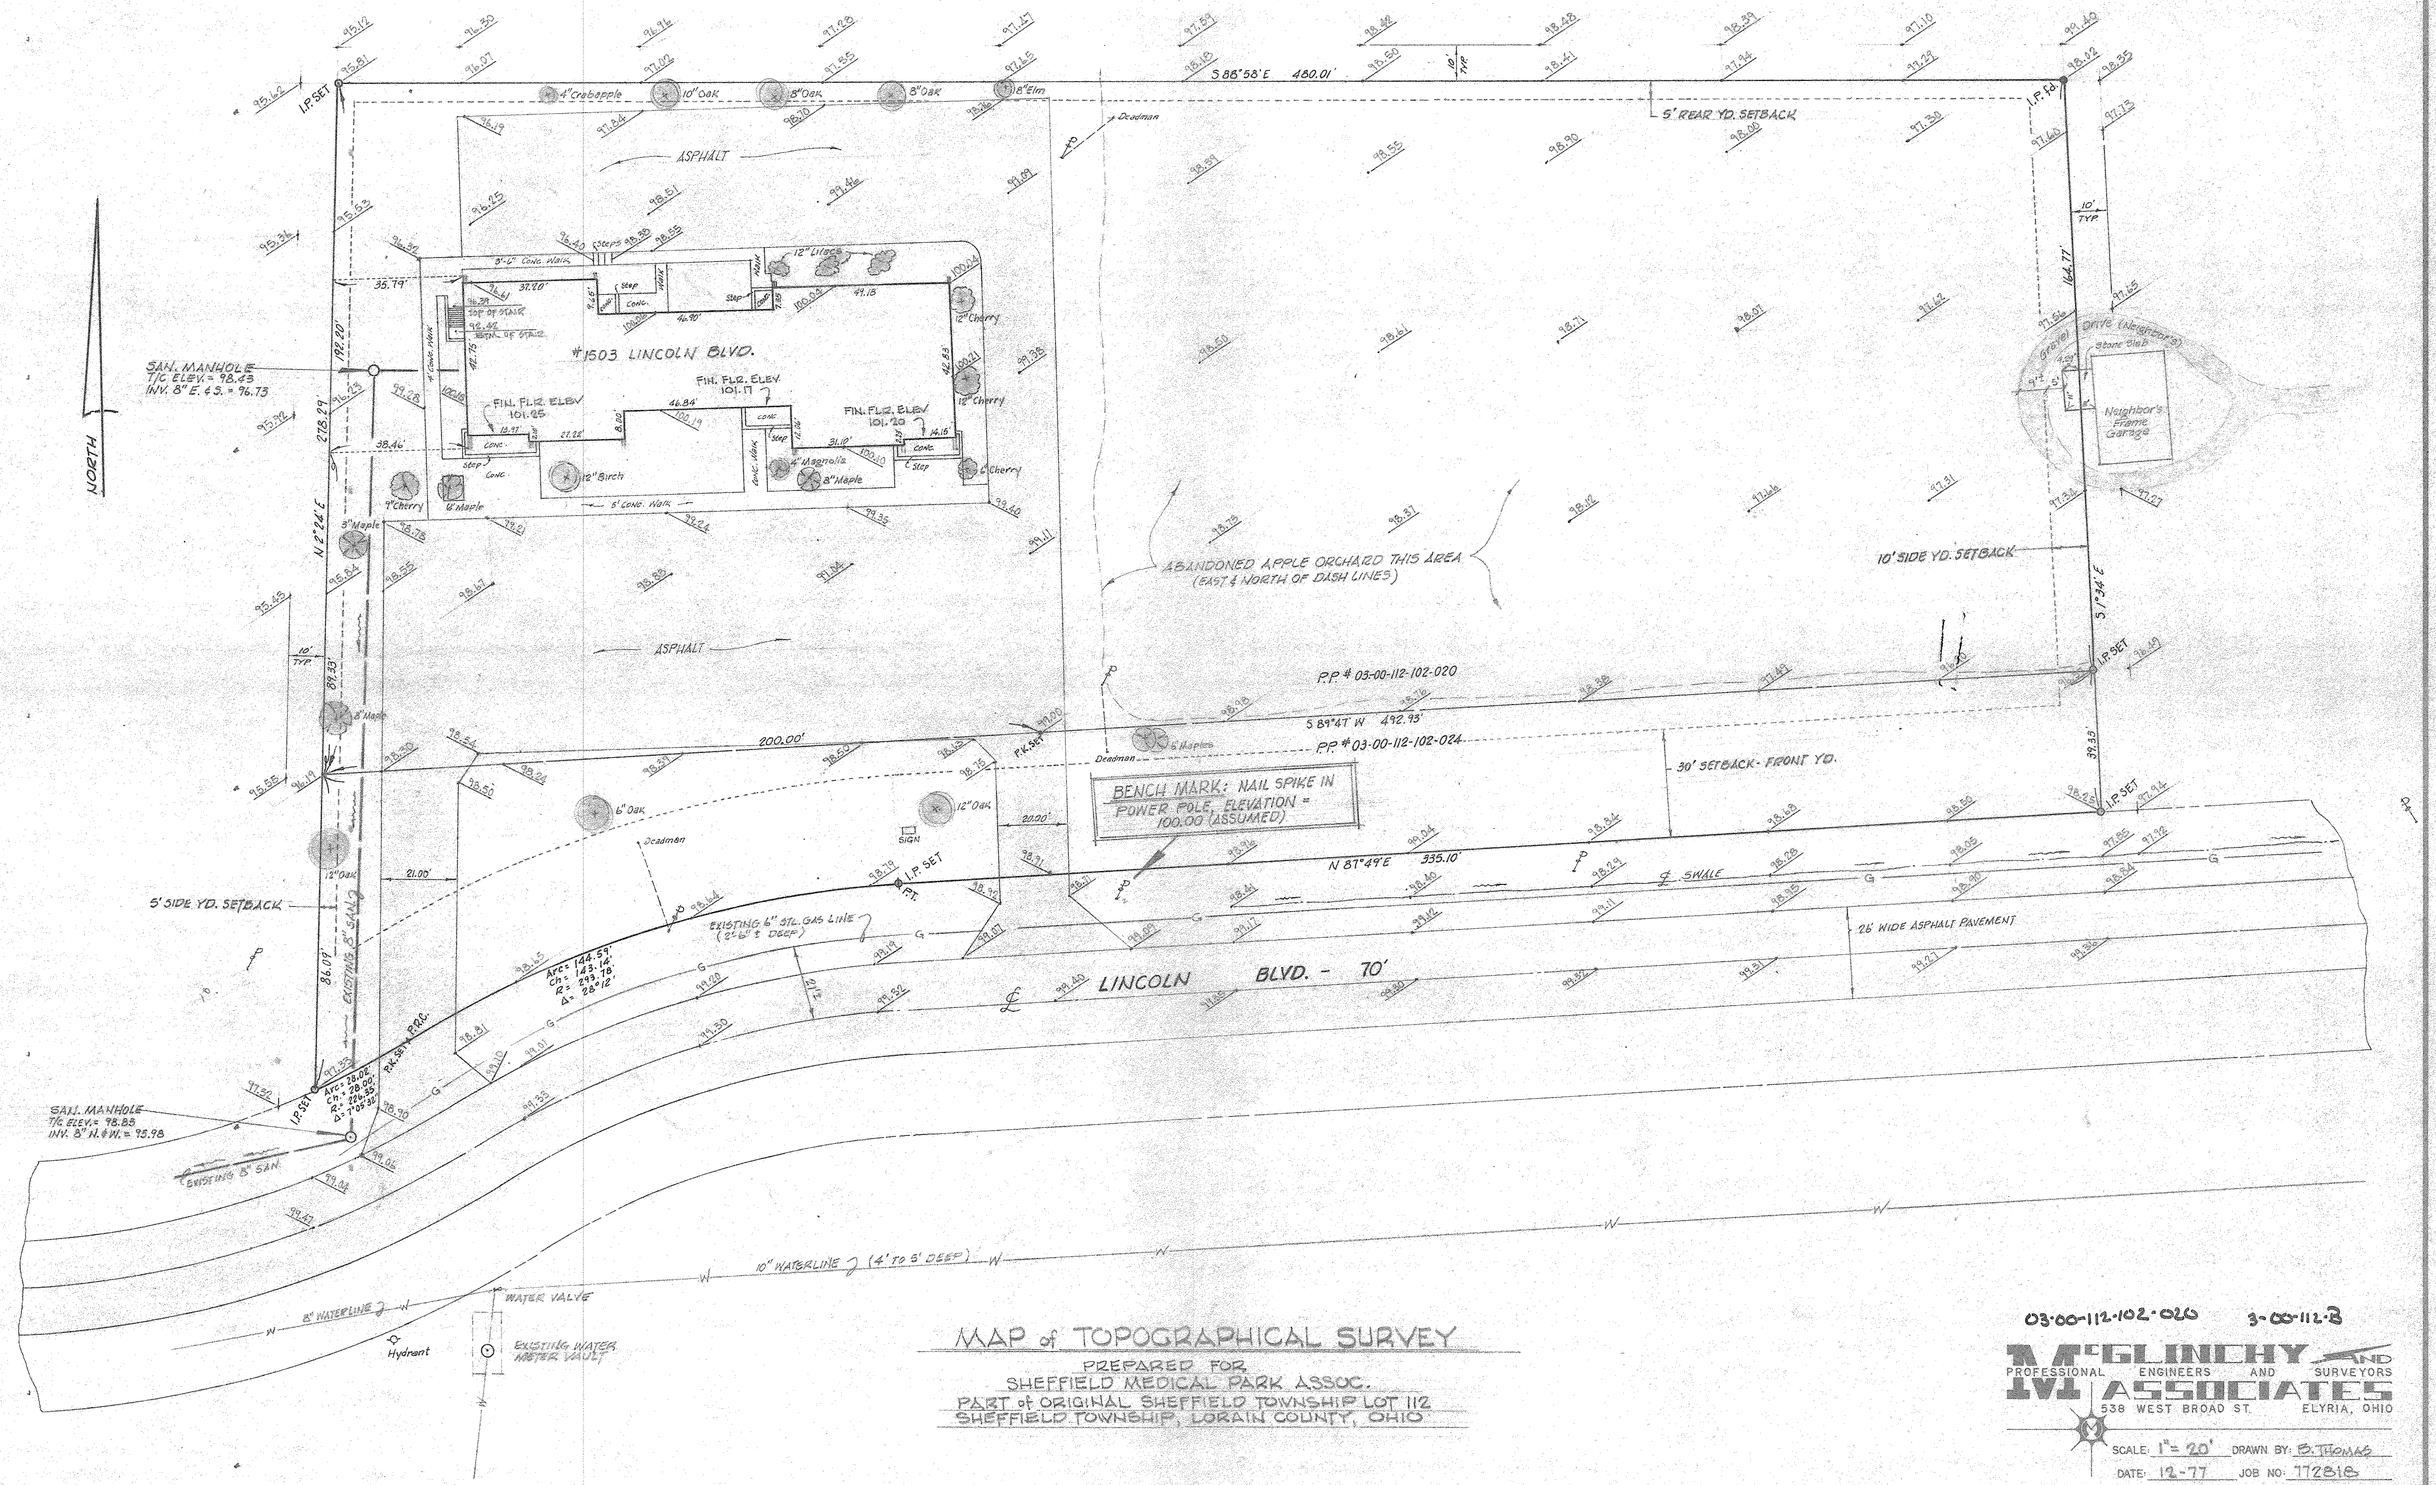

MAP of TOPOGRAPHICAL SURVEY

PREPARED FOR
SHEFFIELD MEDICAL PARK ASSOC.
PART of ORIGINAL SHEFFIELD TOWNSHIP LOT 112
SHEFFIELD TOWNSHIP, LORAIN COUNTY, OHIO

03-00-112-102-020 3-00-112-8

McGLINCHY AND ASSOCIATES
PROFESSIONAL ENGINEERS AND SURVEYORS
538 WEST BROAD ST. ELYRIA, OHIO

SCALE: 1" = 20' DRAWN BY: B. THOMAS
DATE: 12-77 JOB NO. 772818