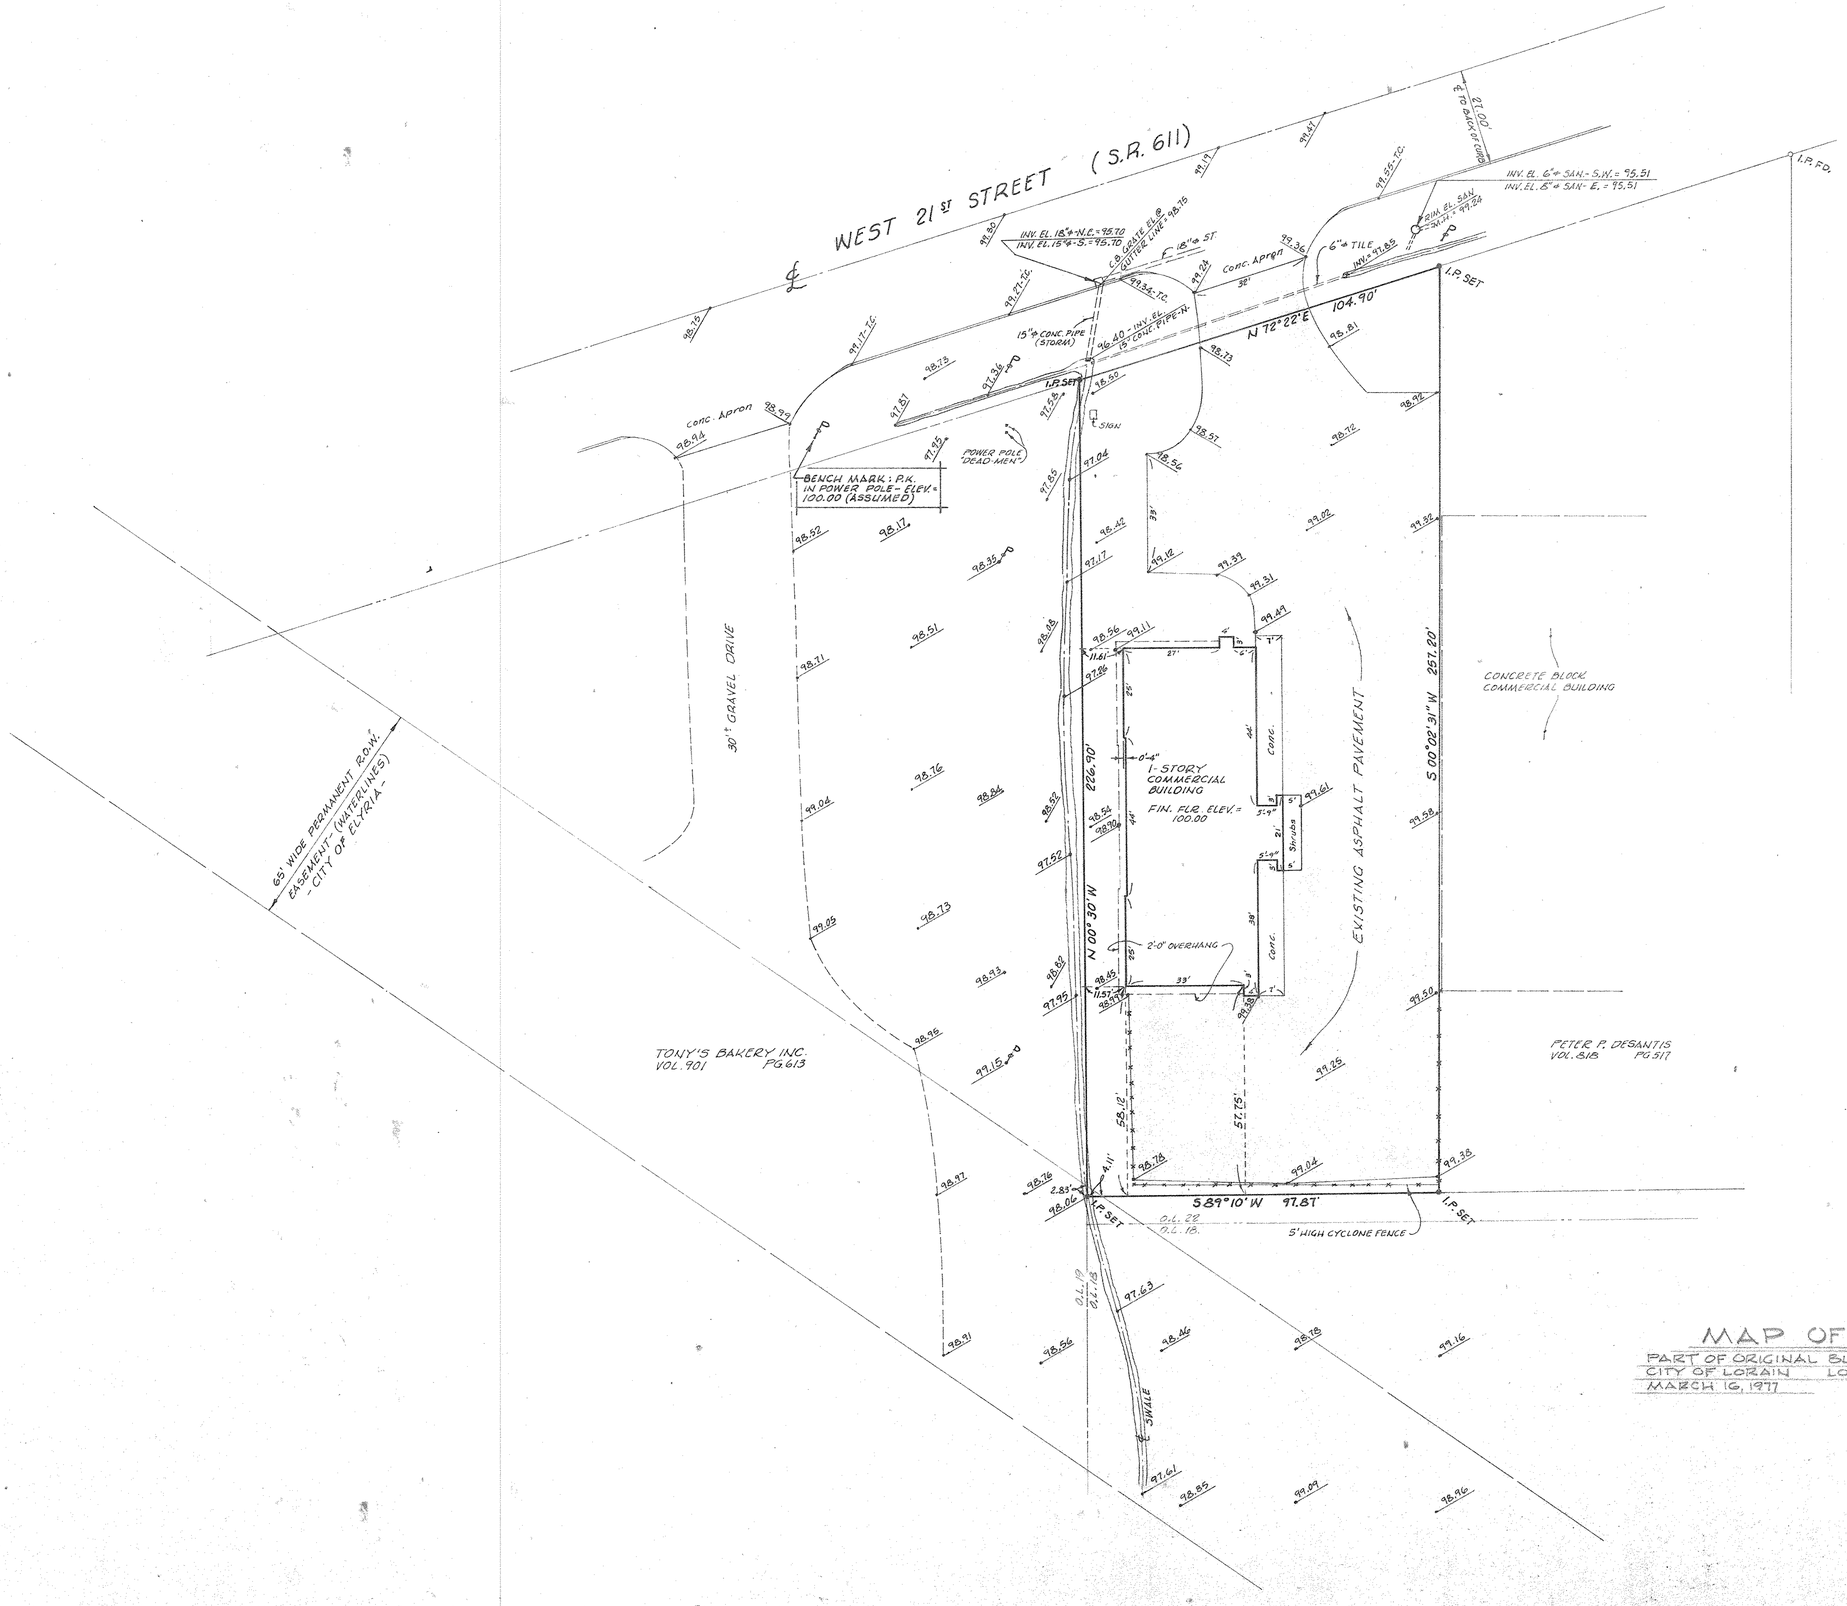

MAP OF SURVEY

PART OF ORIGINAL BLACK RIVER TWP. LOT 22
CITY OF LORAIN LORAIN COUNTY OHIO
MARCH 16, 1977

ORIGINAL SENT TO BOB POST 3/23/77

McGLINCHY and ASSOCIATES
ELYRIA OHIO
JOB No. 771685

02-02-022-107-???

02-02-022