NOTE: LOCATION & SIZES OF STORM SEWER and LATERALS ALONG MAPLE STREET DERIVED FROM DRAWING INFO. BY LAUNDON, HUFFMAN & SIMON DATED JAN. 1971

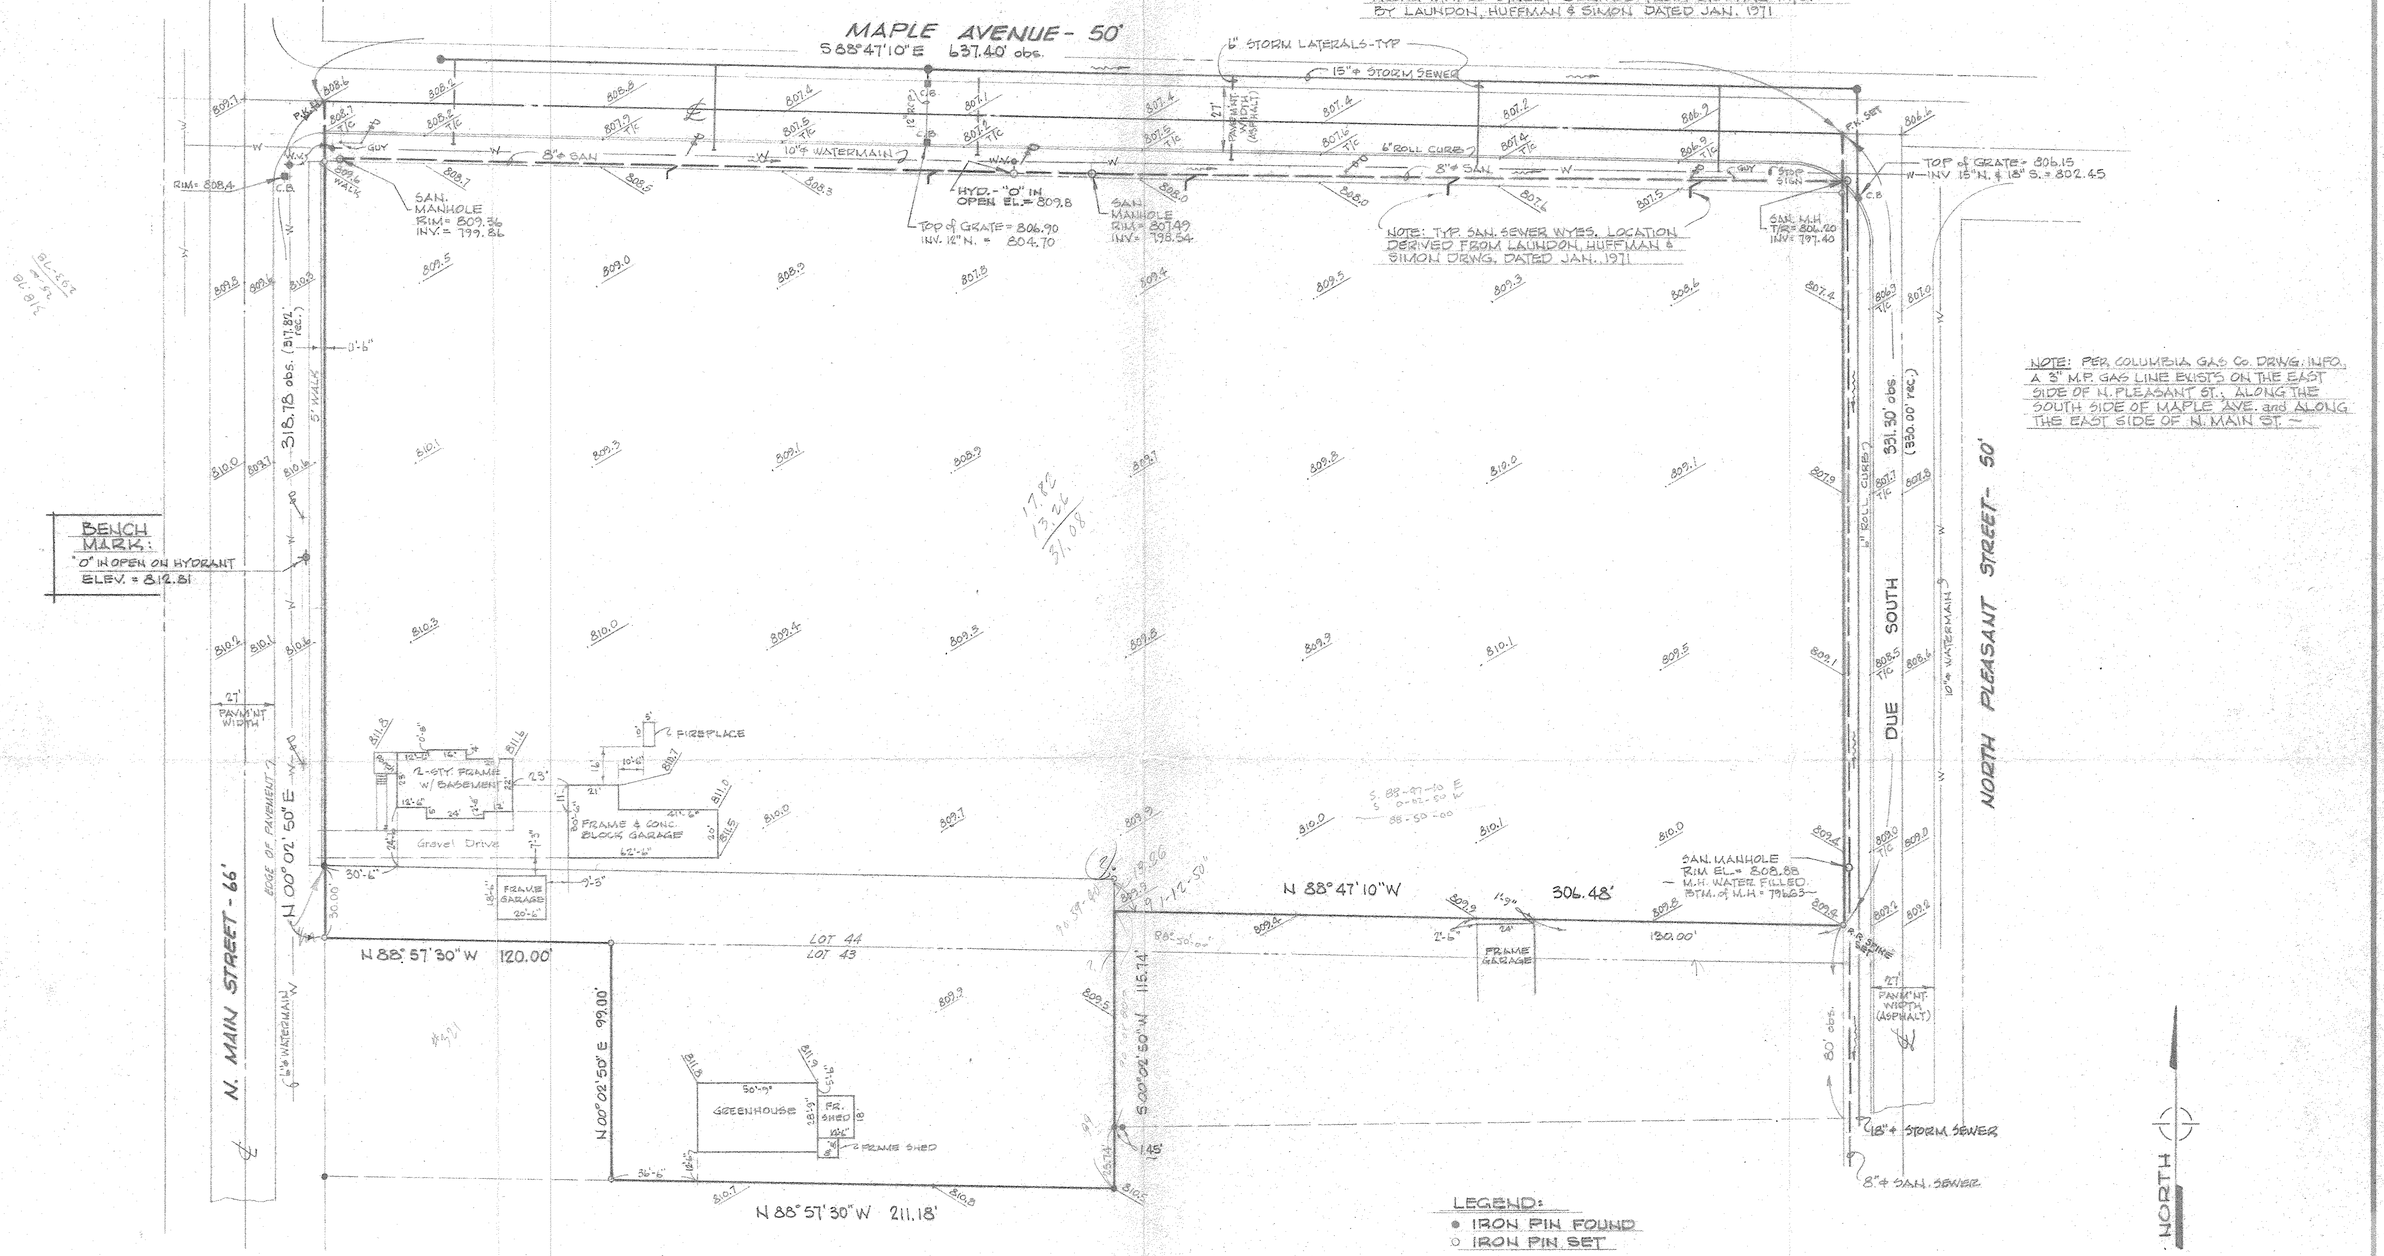

NOTE: PER COLUMBIA GAS Co. DRWG. INFO. A 3" M.P. GAS LINE EXISTS ON THE EAST SIDE OF N. PLEASANT ST., ALONG THE SOUTH SIDE OF MAPLE AVE. and ALONG THE EAST SIDE OF N. MAIN ST. ~

LEGEND:
- ● IRON PIN FOUND
- ○ IRON PIN SET

MAP of BOUNDARY and TOPOGRAPHIC SURVEY

PREPARED FOR CLARK and POST ARCHITECTS INC.

PART of LOT 43 and ALL of LOT 44 of ORIG. VILLAGE PLAT - VOL. 1, PG 20
PART of ORIGINAL RUSSIA TOWNSHIP LOT No. 76
NOW in CITY of OBERLIN, LORAIN COUNTY, OHIO

09-00-076-101-061
09-00-076-A

McGLINCHY AND ASSOCIATES
PROFESSIONAL ENGINEERS AND SURVEYORS
538 WEST BROAD ST ELYRIA, OHIO

SCALE: 1" = 30' DRAWN BY: BOB
DATE: MAR. 1979 JOB NO. 794898