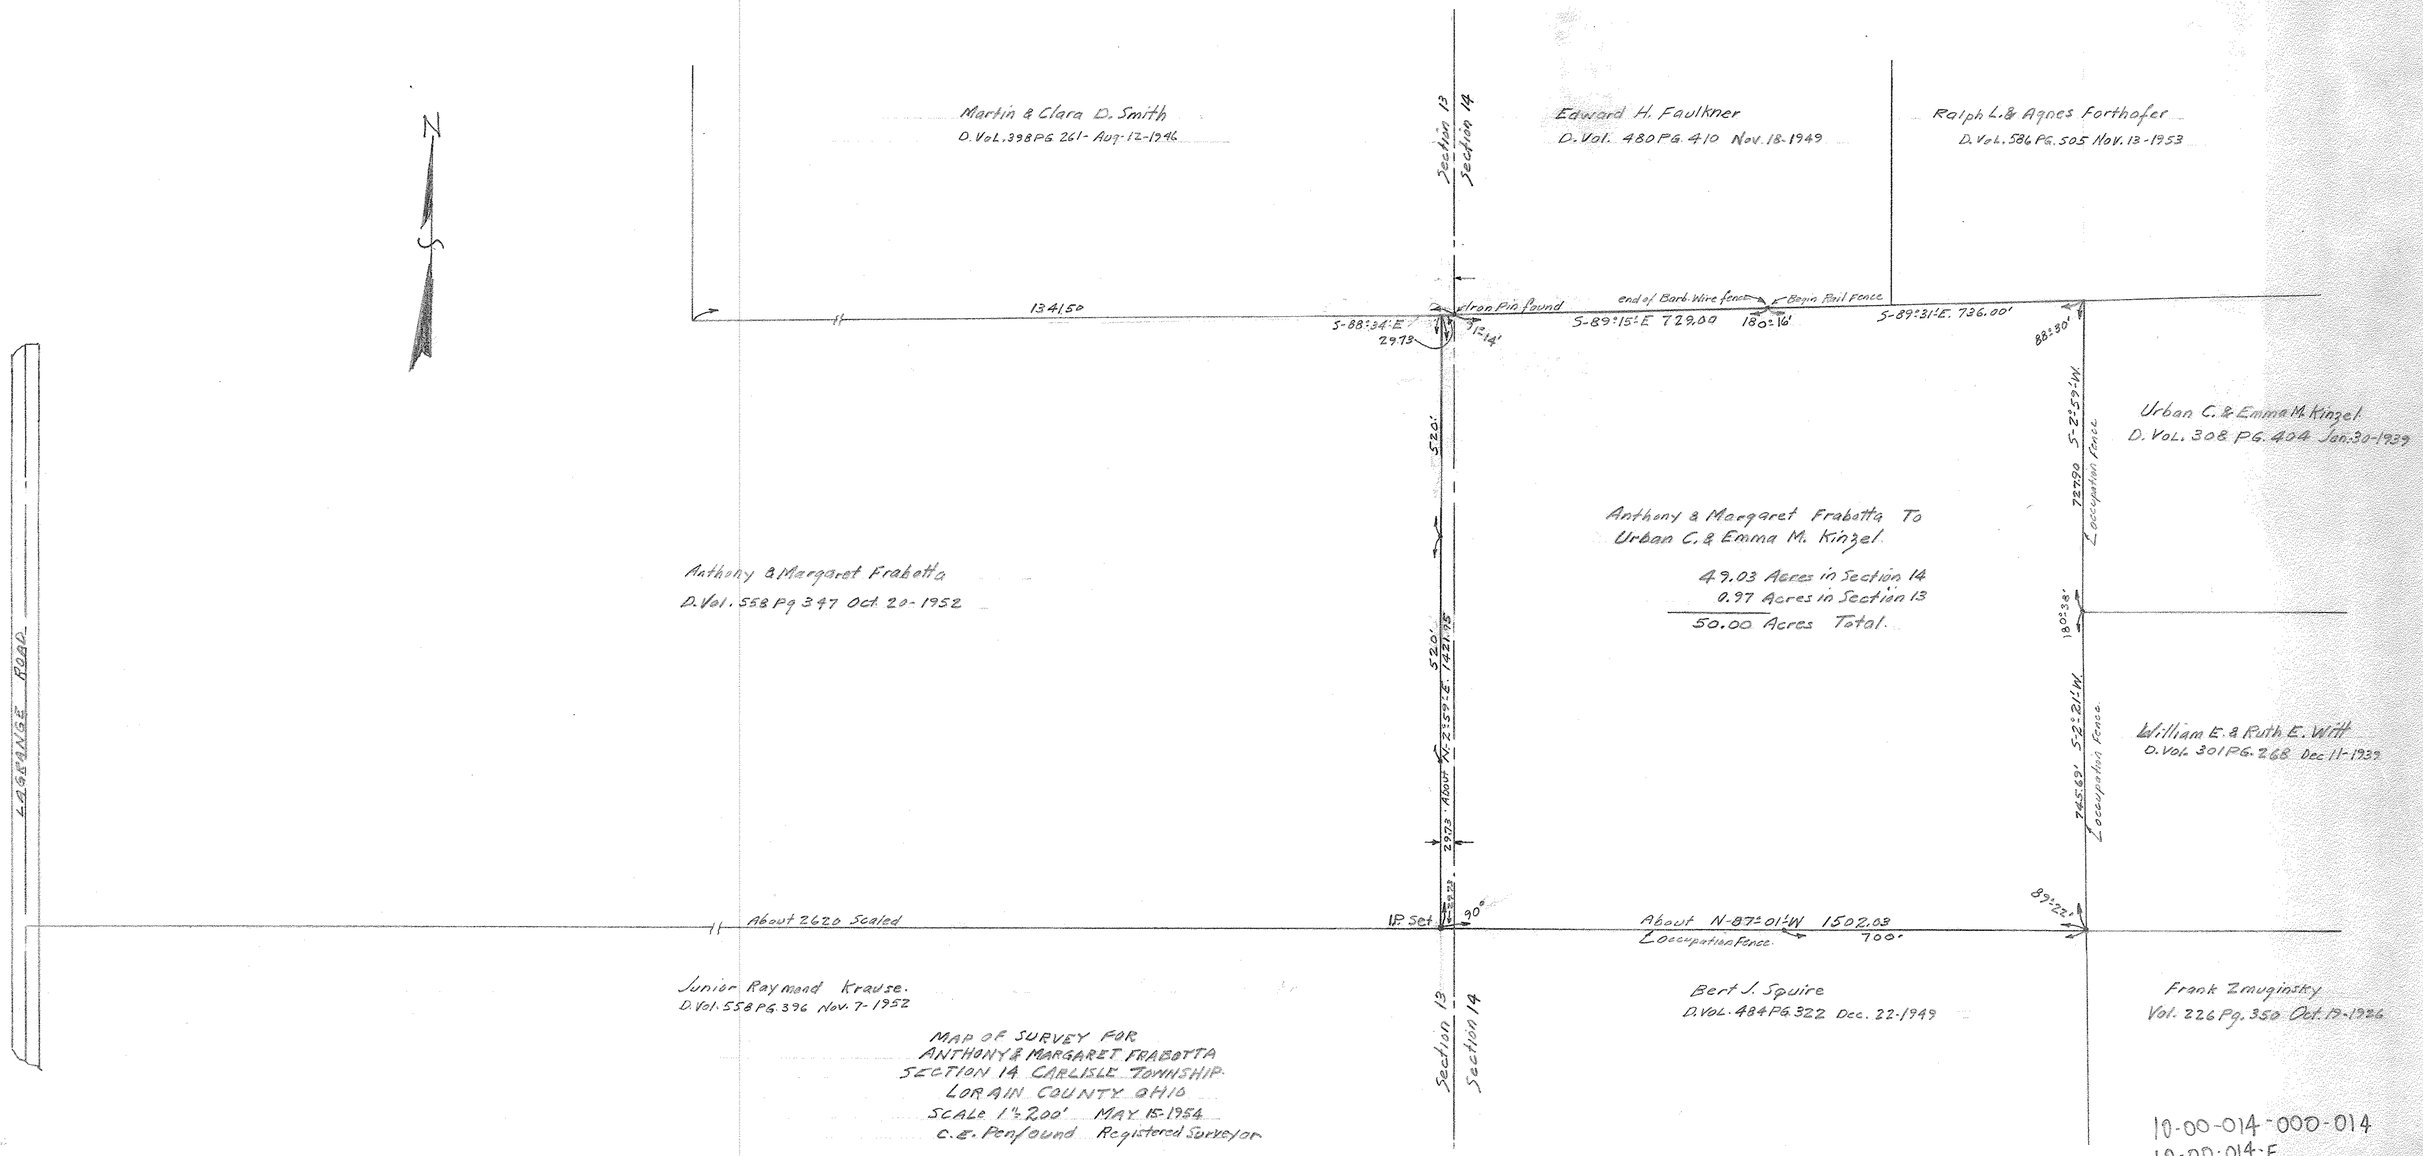


MAP OF SURVEY FOR
ANTHONY & MARGARET FRABOTTA
SECTION 14 CARLISLE TOWNSHIP
LORAIN COUNTY OHIO
SCALE 1" = 200' MAY 15-1954
C. E. Penfound Registered Surveyor

10-00-014-000-014
10-00-014-E
10-00-013-000-047
10-00-013-H

10-00-014