NOTE: Iron pins found or set shown thus: •

NOTE: FOLLOWING PARCELS SURVEYED BY
Gary E. Penfound – Reg. Surveyor No. 4457
6-8-13-14-15-16-17-18-21
PARCELS 14-A, 19-R & 20 SURVEYED MAY-1972.
PARCELS 22 & 22-A, 23 & 23-A SURVEYED OCT. 1977

PLAT OF SURVEY FOR EDGAR C. & HELEN CLARK

SECTION 20 CARLISLE TOWNSHIP LORAIN COUNTY – OHIO
SCALE: 1" = 100'

C. E. Penfound Registered Surveyor
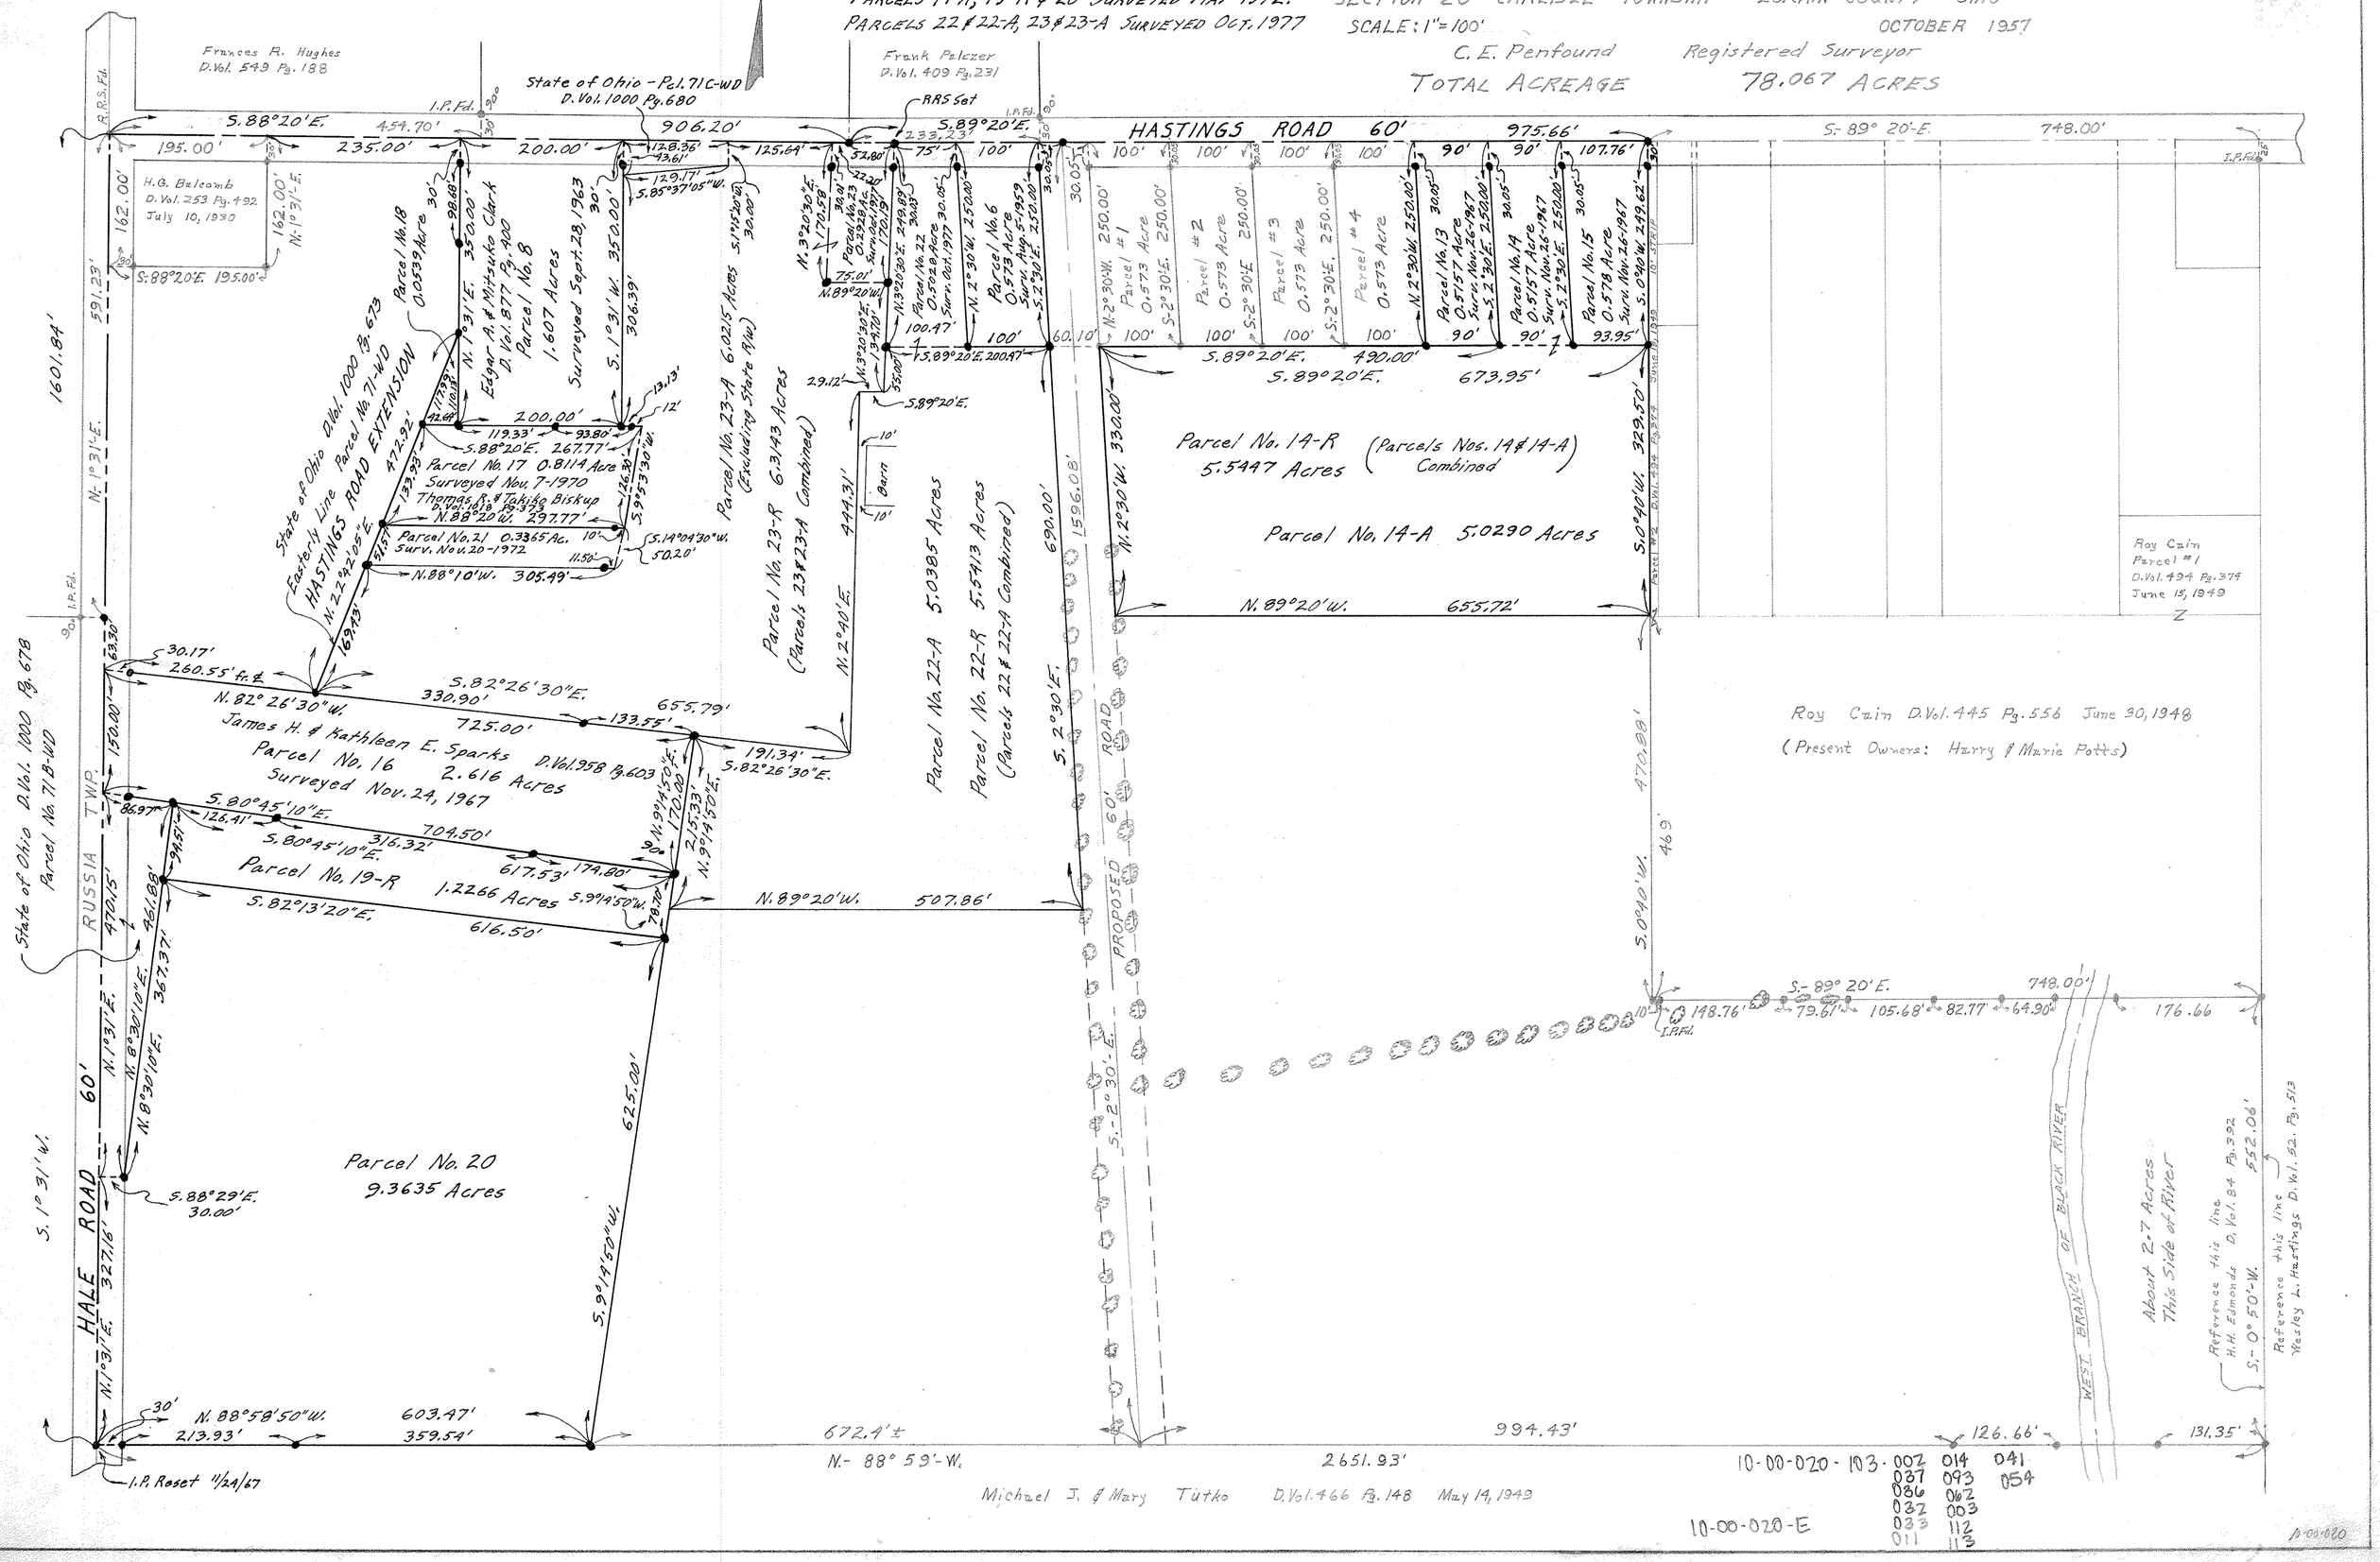
TOTAL ACREAGE 78.067 ACRES