


PLAT OF SURVEYS FOR  
 MRS. WILMA M. MARTIN AND  
 JACKSON M. & BERNICE JEAN DUNCAN  
 ORIGINAL LOT 92 EATON TOWNSHIP  
 LORAIN COUNTY OHIO  
 SCALE: 1"=60' JULY 1968

Gary E. Penfound  
 Reg. Surveyor No. 4457

NOTES: Heavy lines indicate outline  
 of PARCELS A-B-C & D.  
 • indicates iron pin set unless  
 otherwise designated.

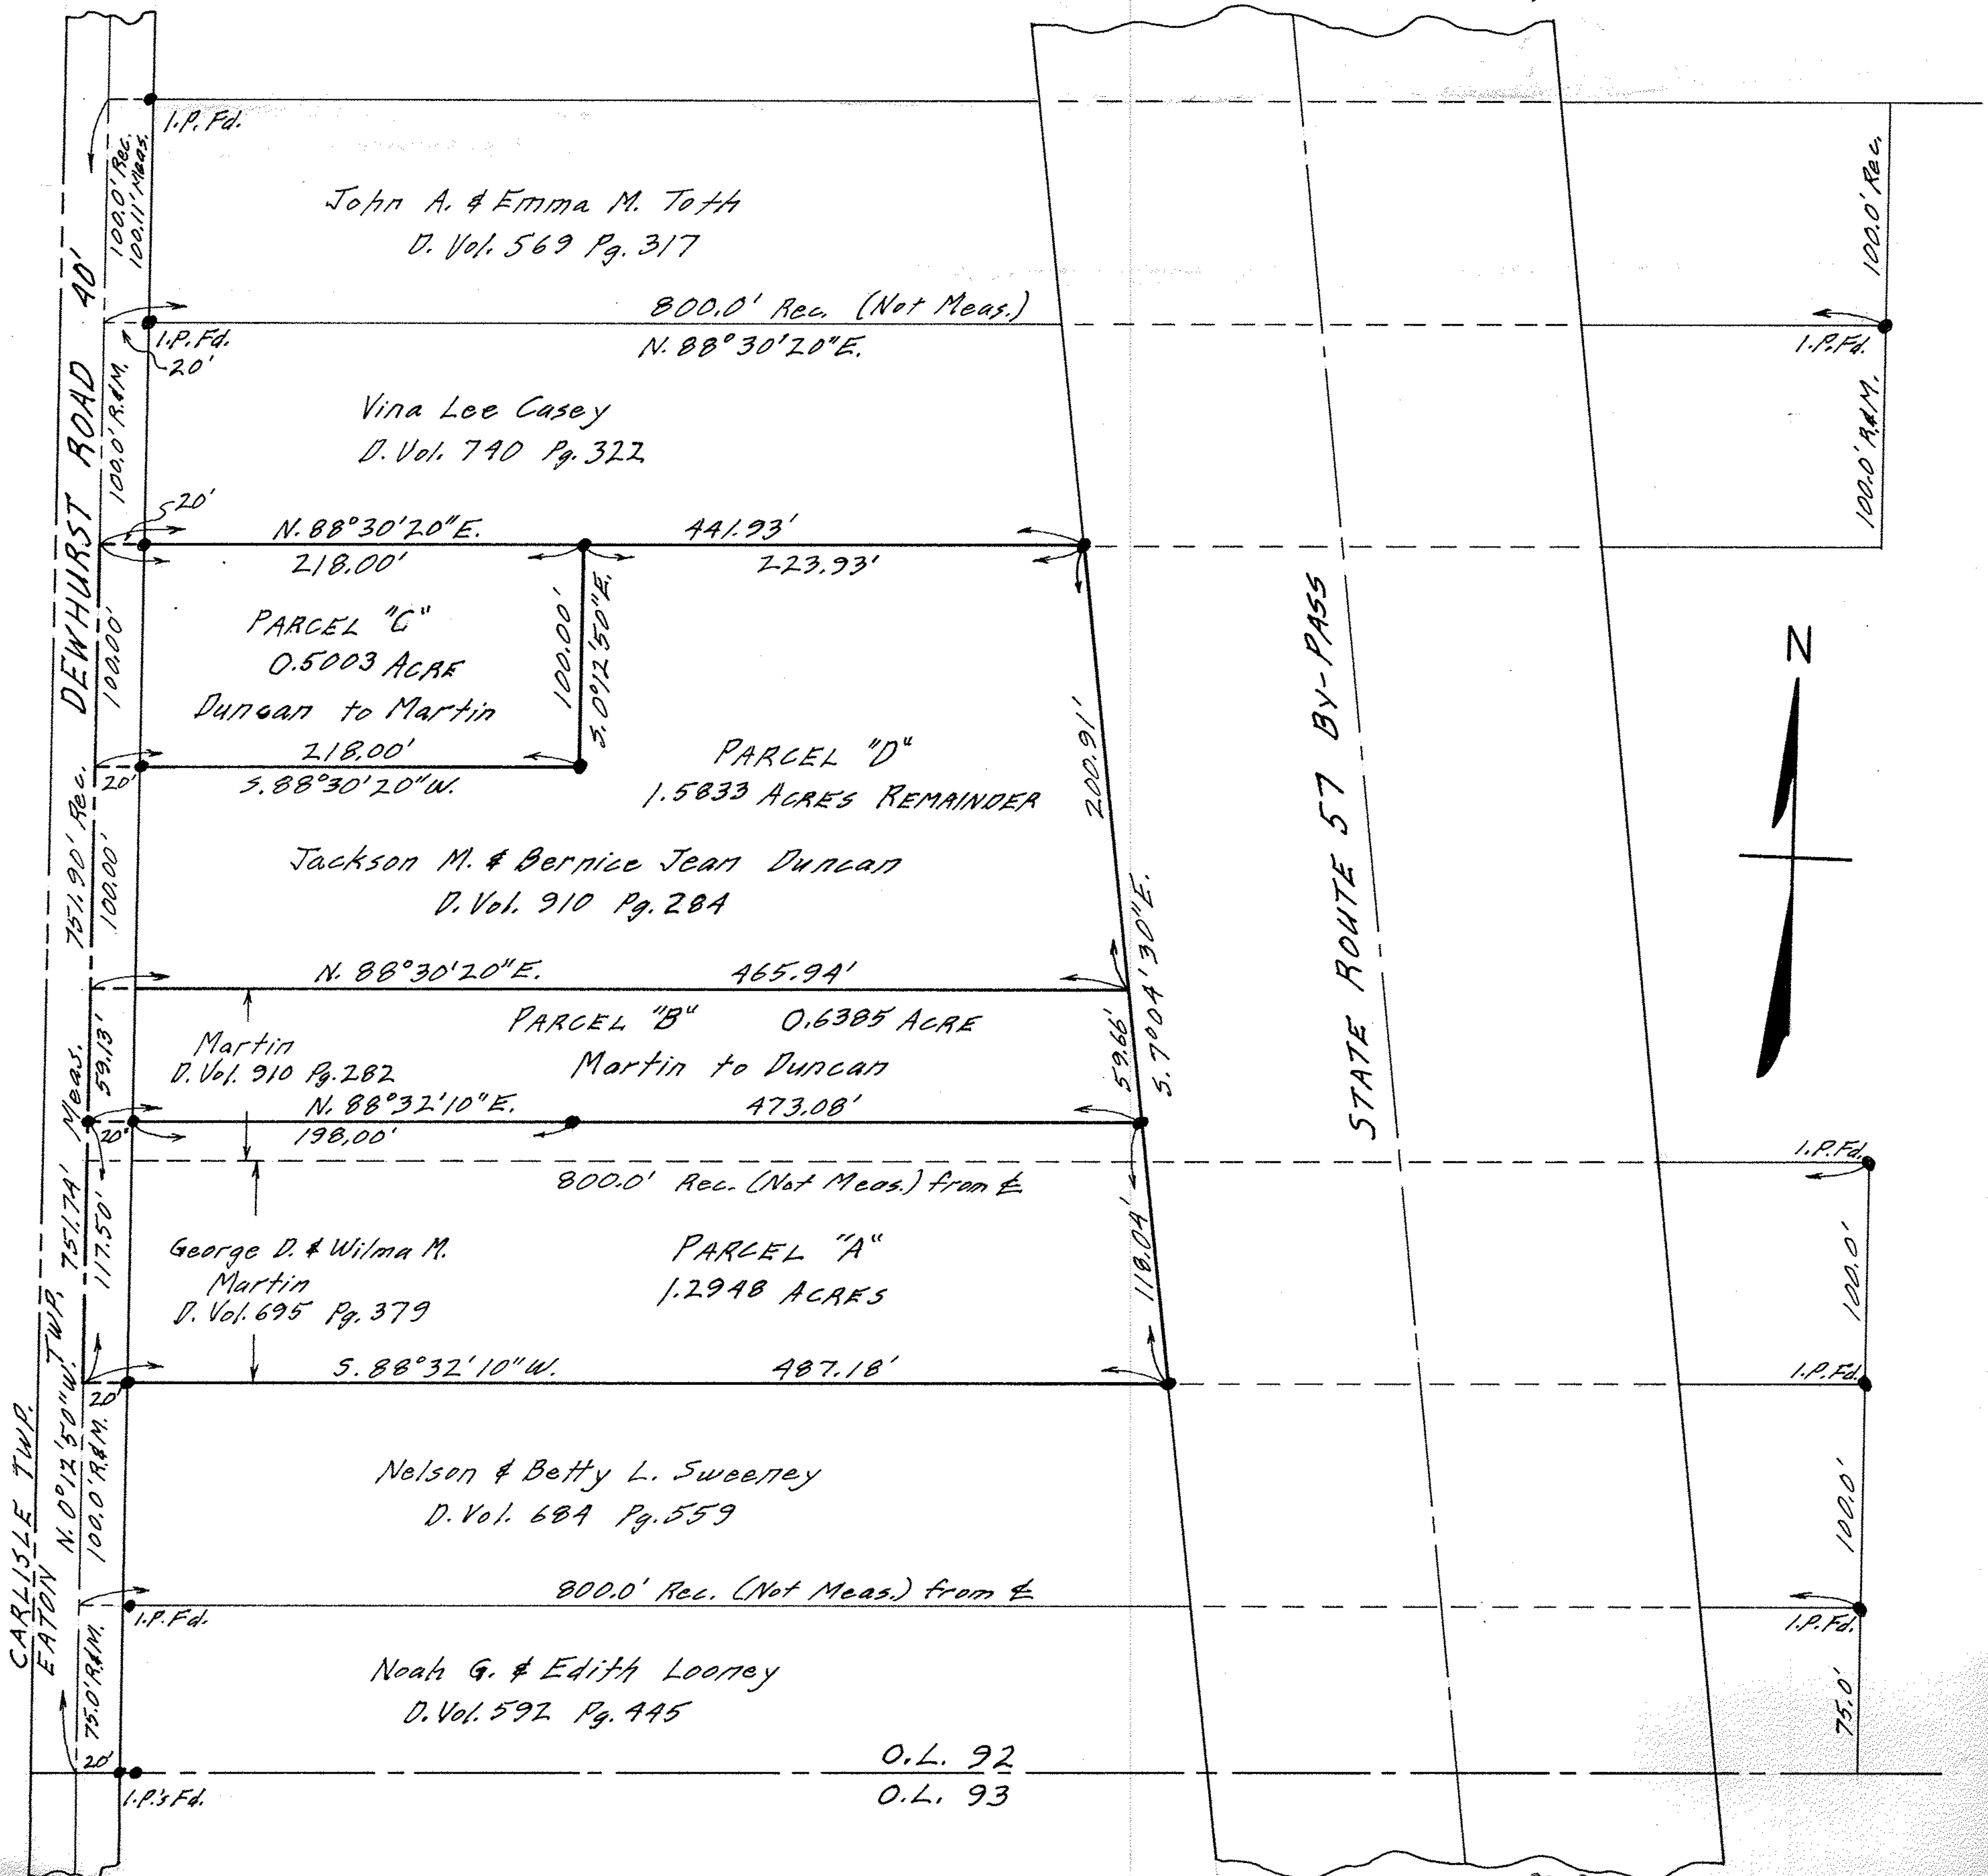

O.L. 92  
 O.L. 93