PLAT OF SURVEYS FOR WALTER G. CASPER AND MRS. MARY CASPER

ORIGINAL LOT NO. 13 COLUMBIA TOWNSHIP
LORAIN COUNTY OHIO
SCALE: 1" = 100' OCTOBER - 1979
Gary E. Pentfound Reg. Surveyor No. 4457
SURVEY MARKERS FOR PARCELS NOS. 1 THRU 7
~~SET DECEMBER 1979 And JANUARY 1980~~

Raymond & Frances Gay D. Vol. 1139 Pg. 769

NOTES: ● indicates iron pin set on this or previous surveying.
o indicates railroad spike set in pavement.

All iron pins and railroad spikes set as shown Apr. 29 - May 1, 1980.

12-00-013-000-026, -027, -029, -030
-023, -024
-031, -032, -033, -034
-036
12-00-013, A & B

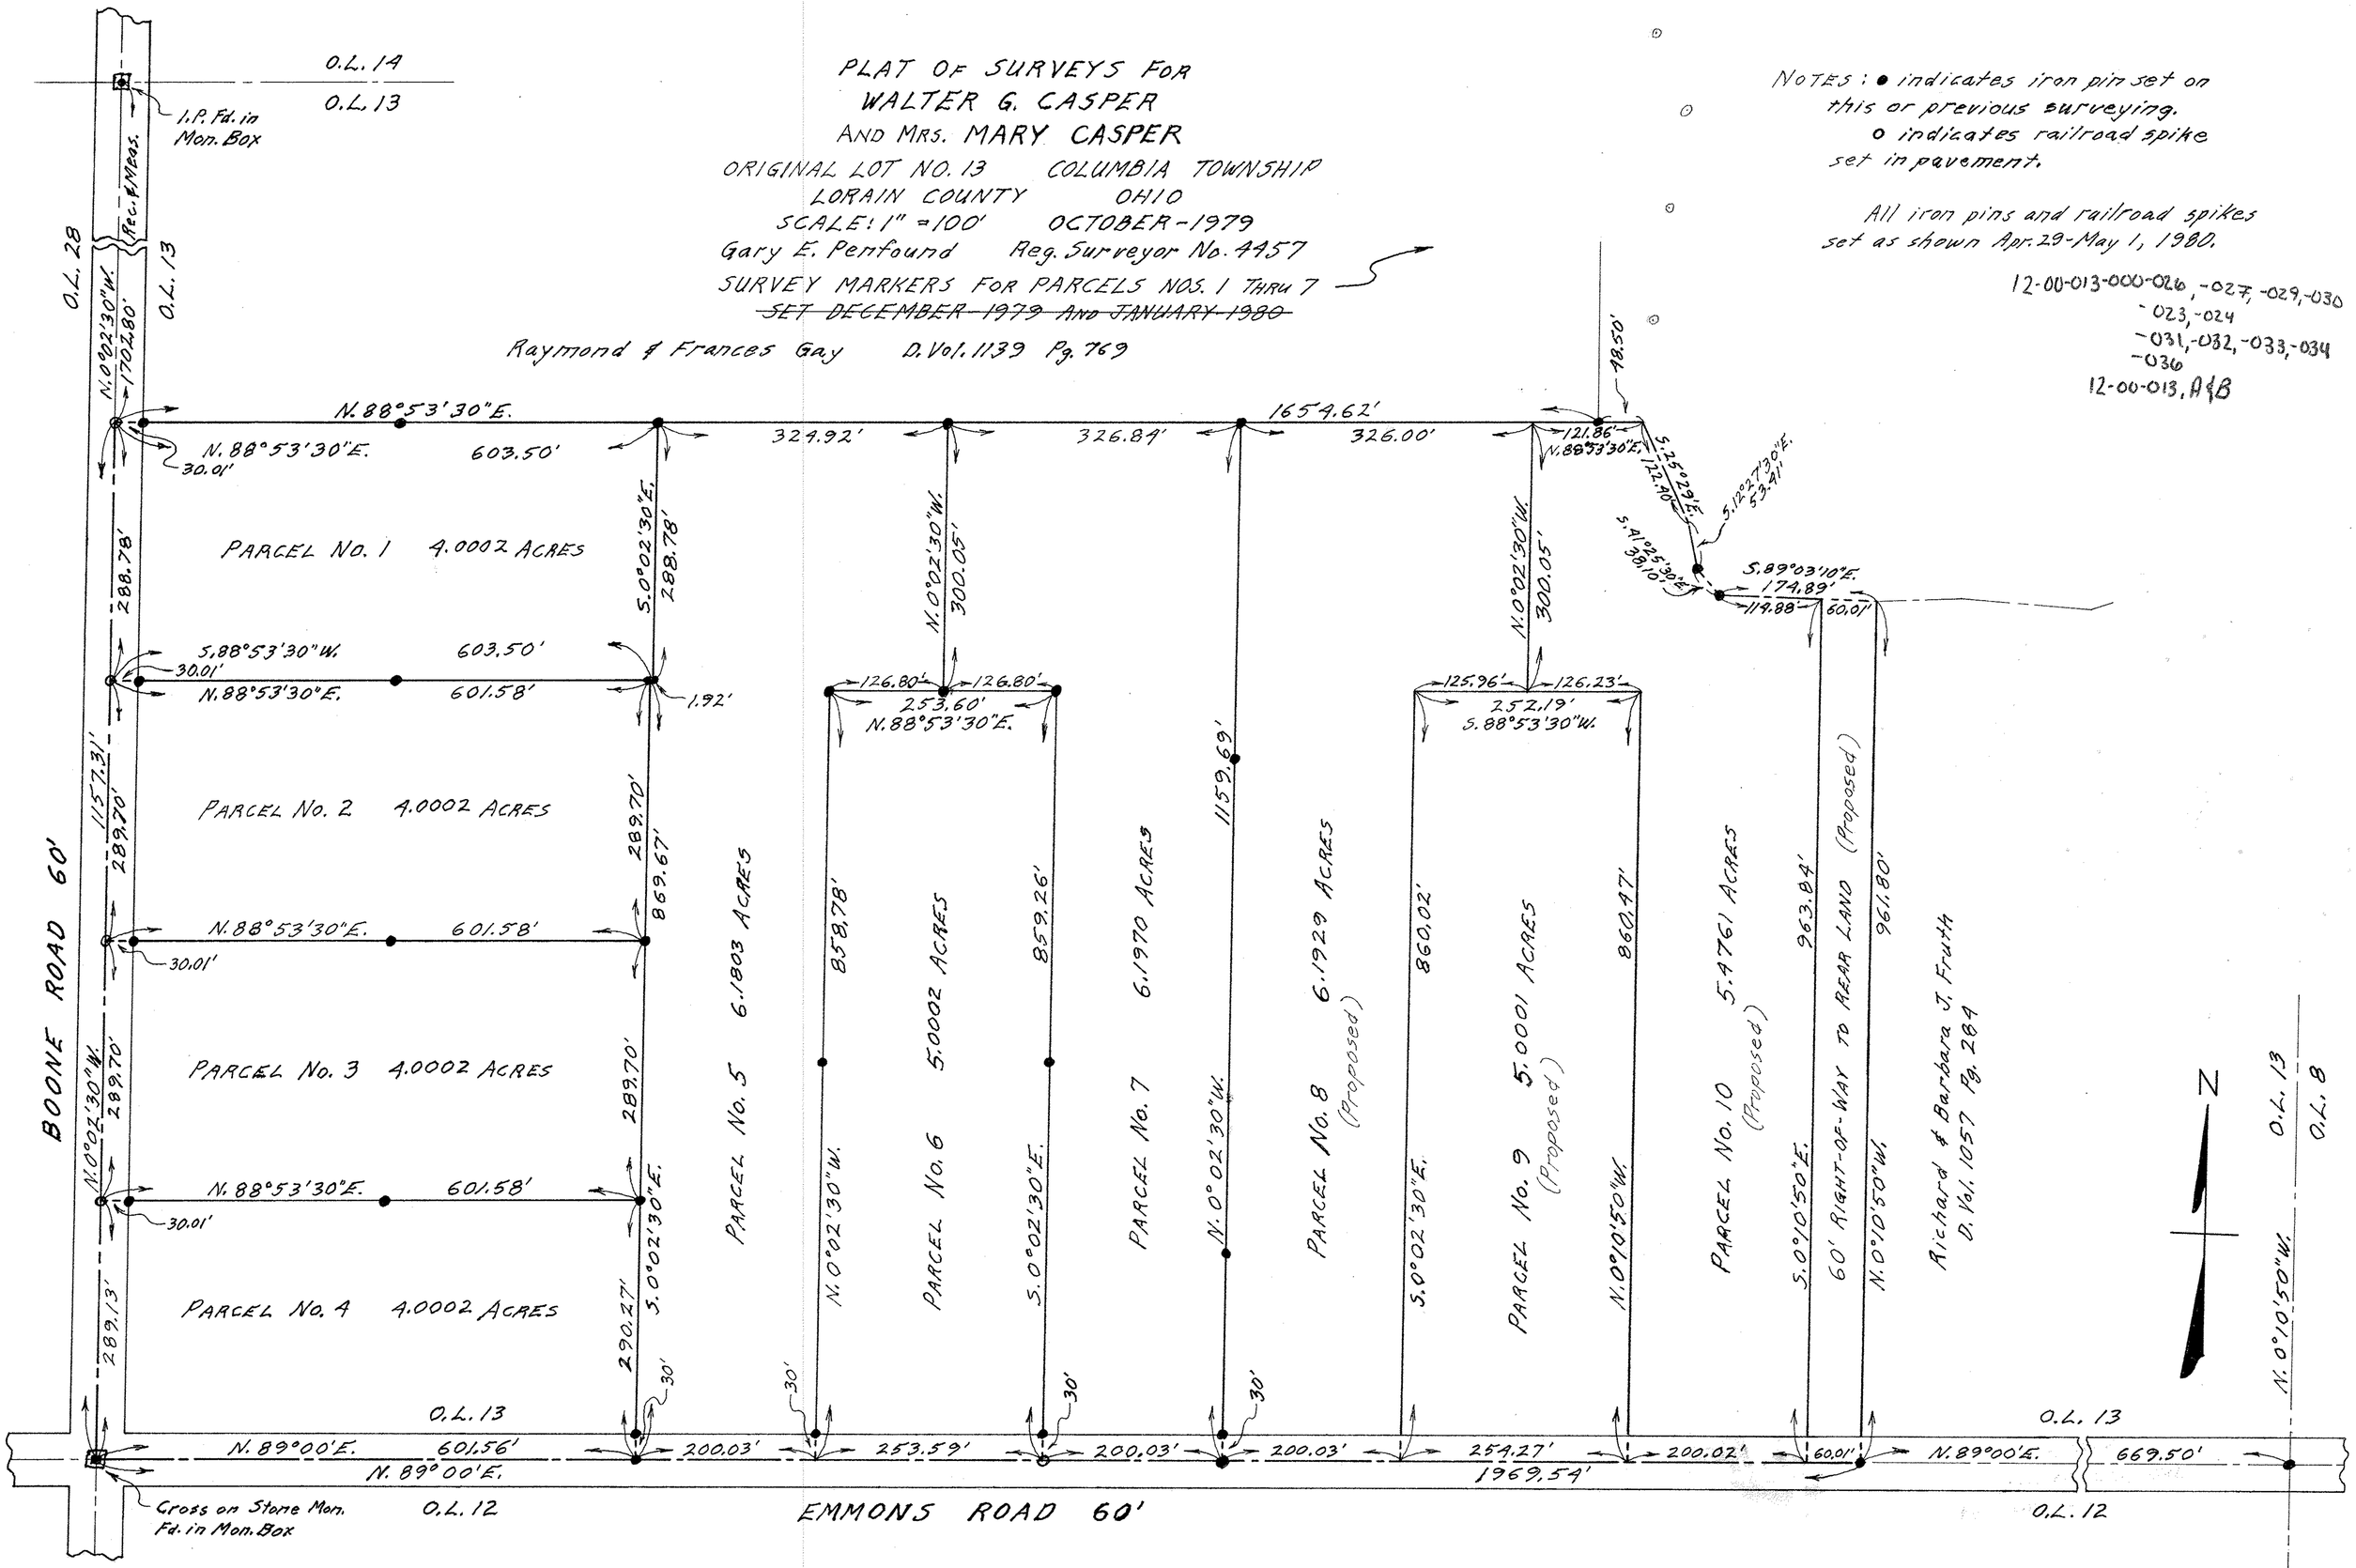

12-00-013