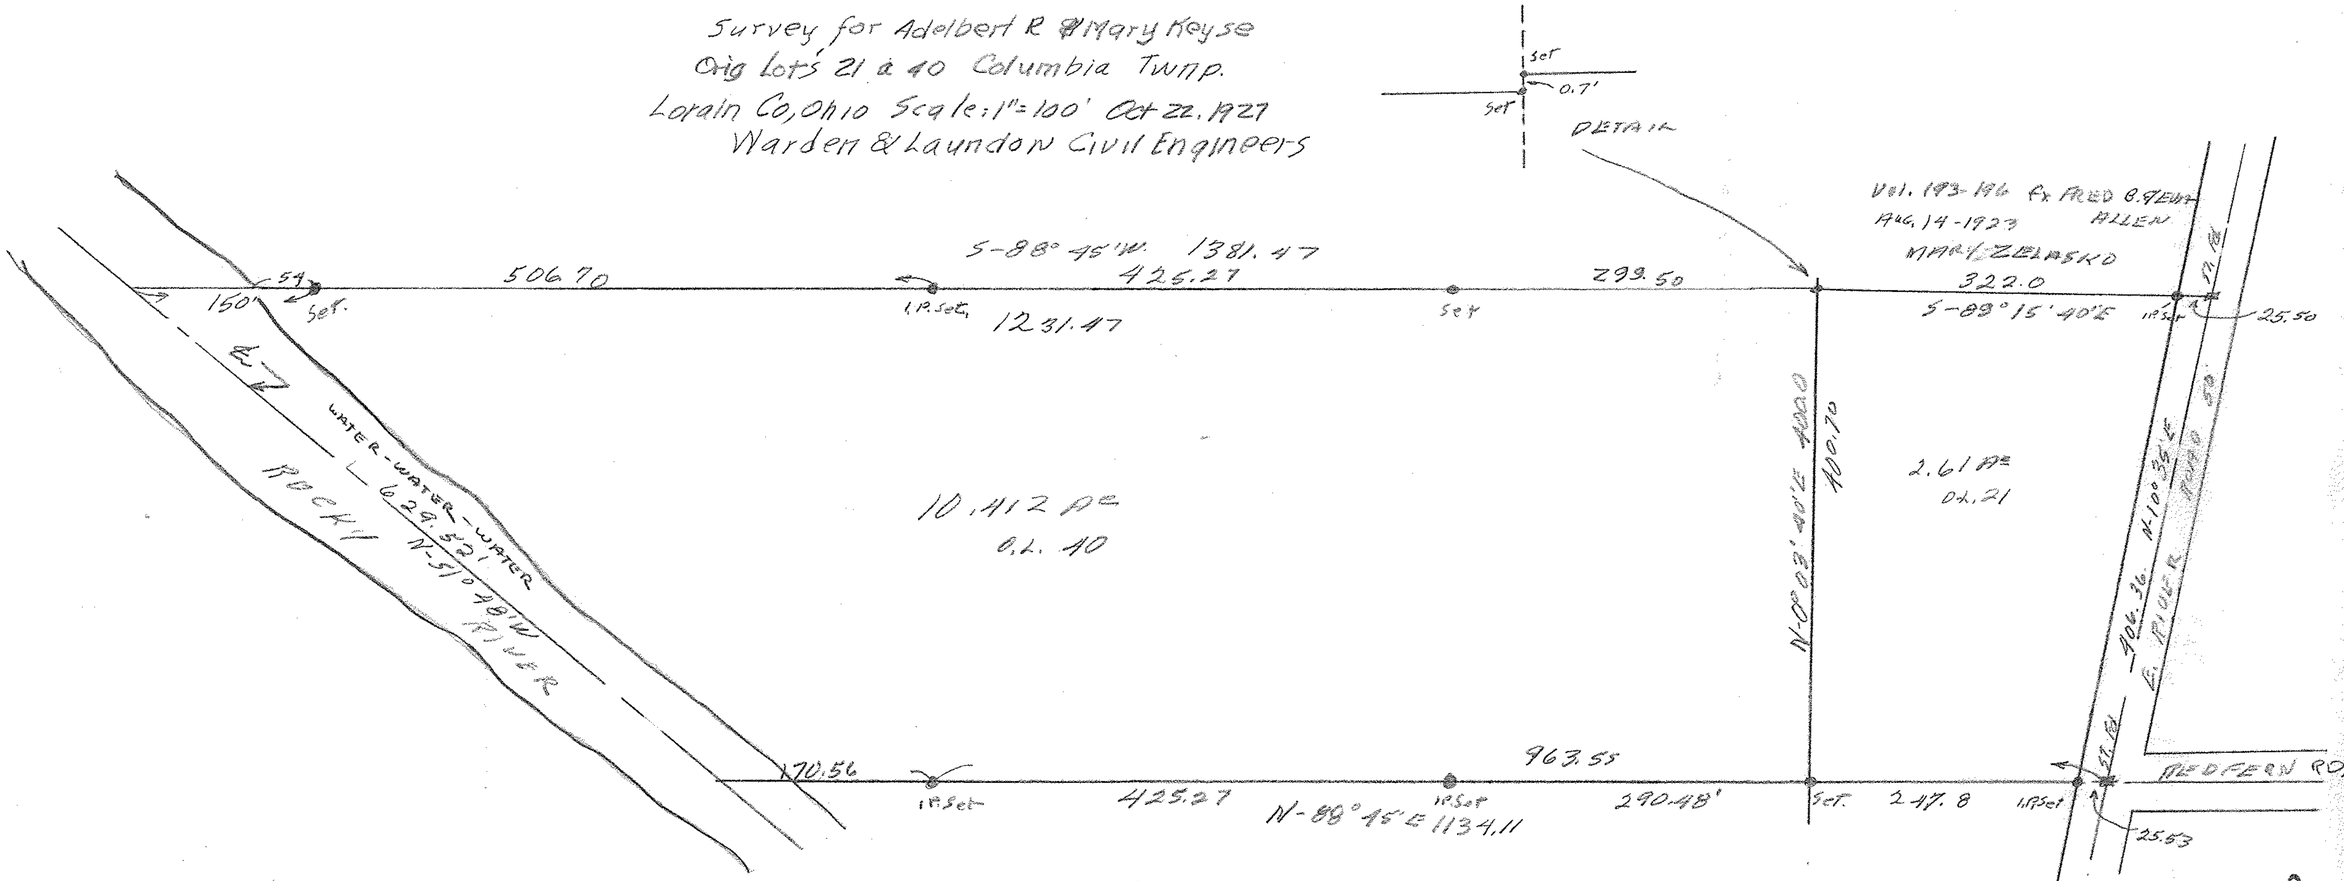Survey for Adelbert R & Mary Keyse
Orig Lots 21 & 40 Columbia Twnp.
Lorain Co, Ohio Scale: 1" = 100' Oct 22, 1927
Warden & Laundon Civil Engineers