Gary E. Penfound
Reg. Surveyor No. 4457

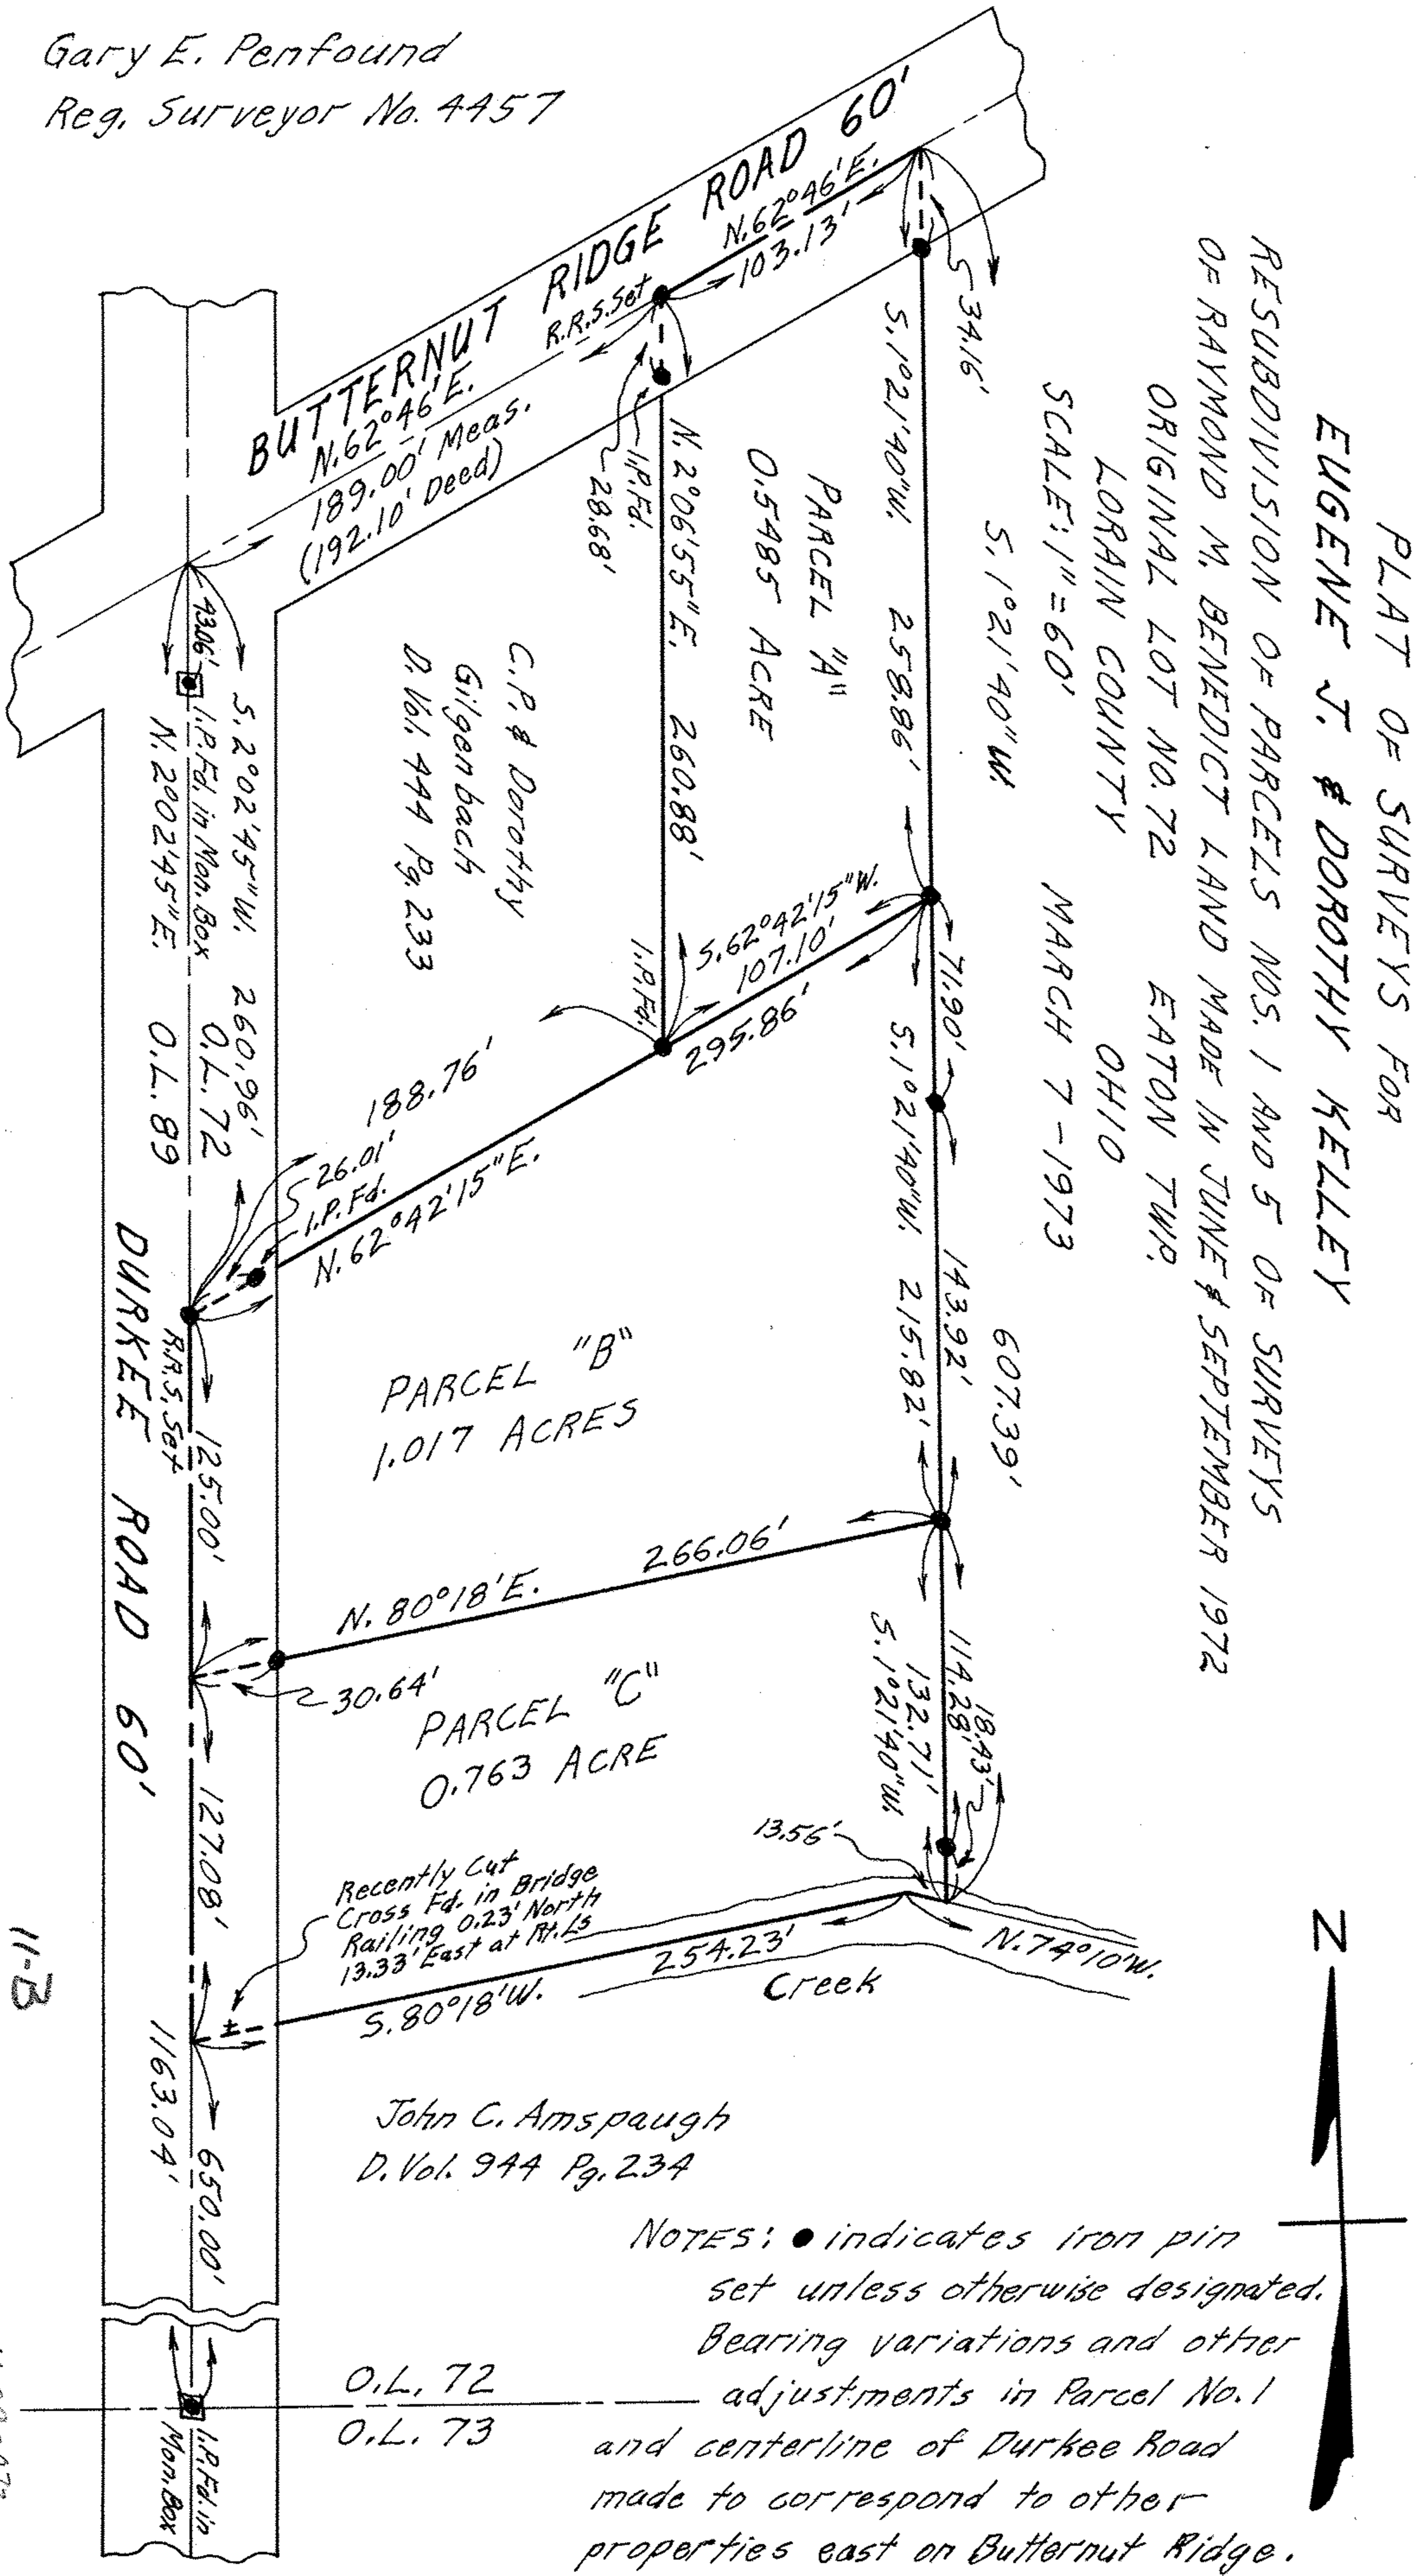

NOTES: ● indicates iron pin set unless otherwise designated. Bearing variations and other adjustments in Parcel No. 1 and centerline of Durkee Road made to correspond to other properties east on Butternut Ridge.

11-00-072 · 000-045-052

11-B