
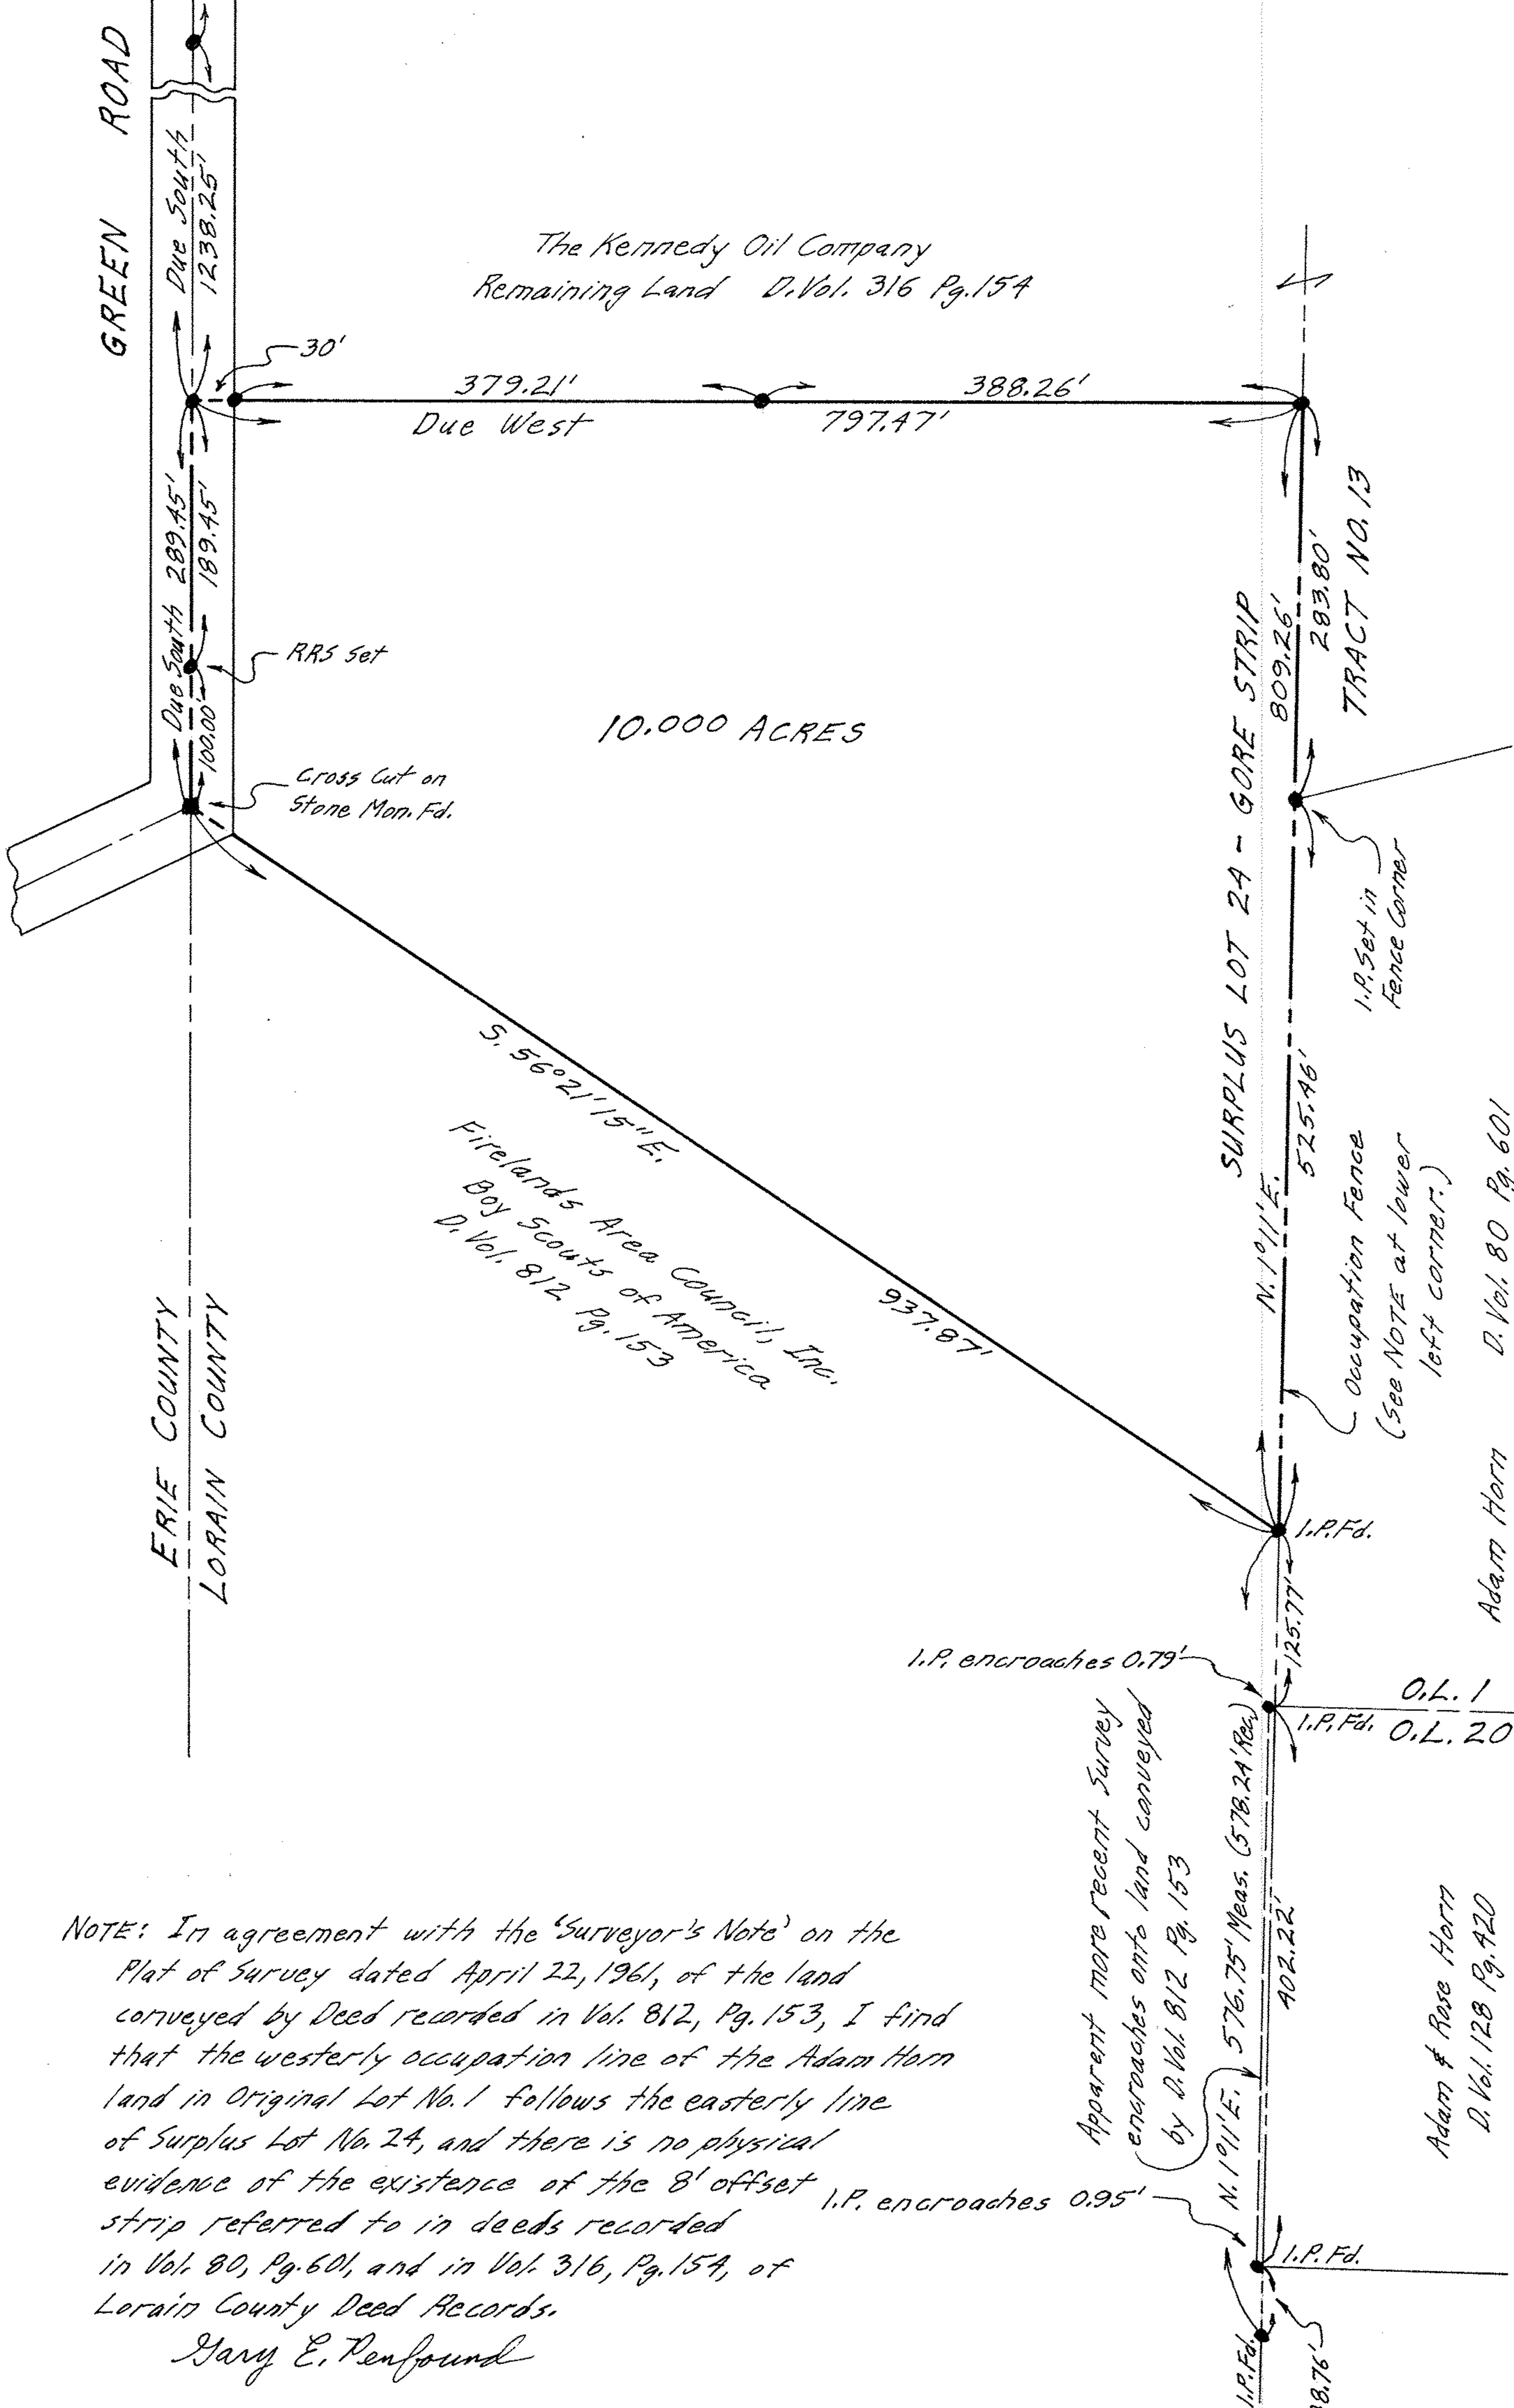


PLAT OF SURVEY FOR  
 FIRELANDS AREA COUNCIL, INC.  
 BOY SCOUTS OF AMERICA  
 PART OF SURPLUS LOT NO. 24 OF  
 THE GORE STRIP IN HENRIETTA TWP.  
 LORAIN COUNTY OHIO  
 SCALE: 1"=100' OCTOBER 1972  
 Gary E. Penfound Reg. Surveyor No. 4457

NOTE: ● indicates iron pin set  
 unless otherwise designated.

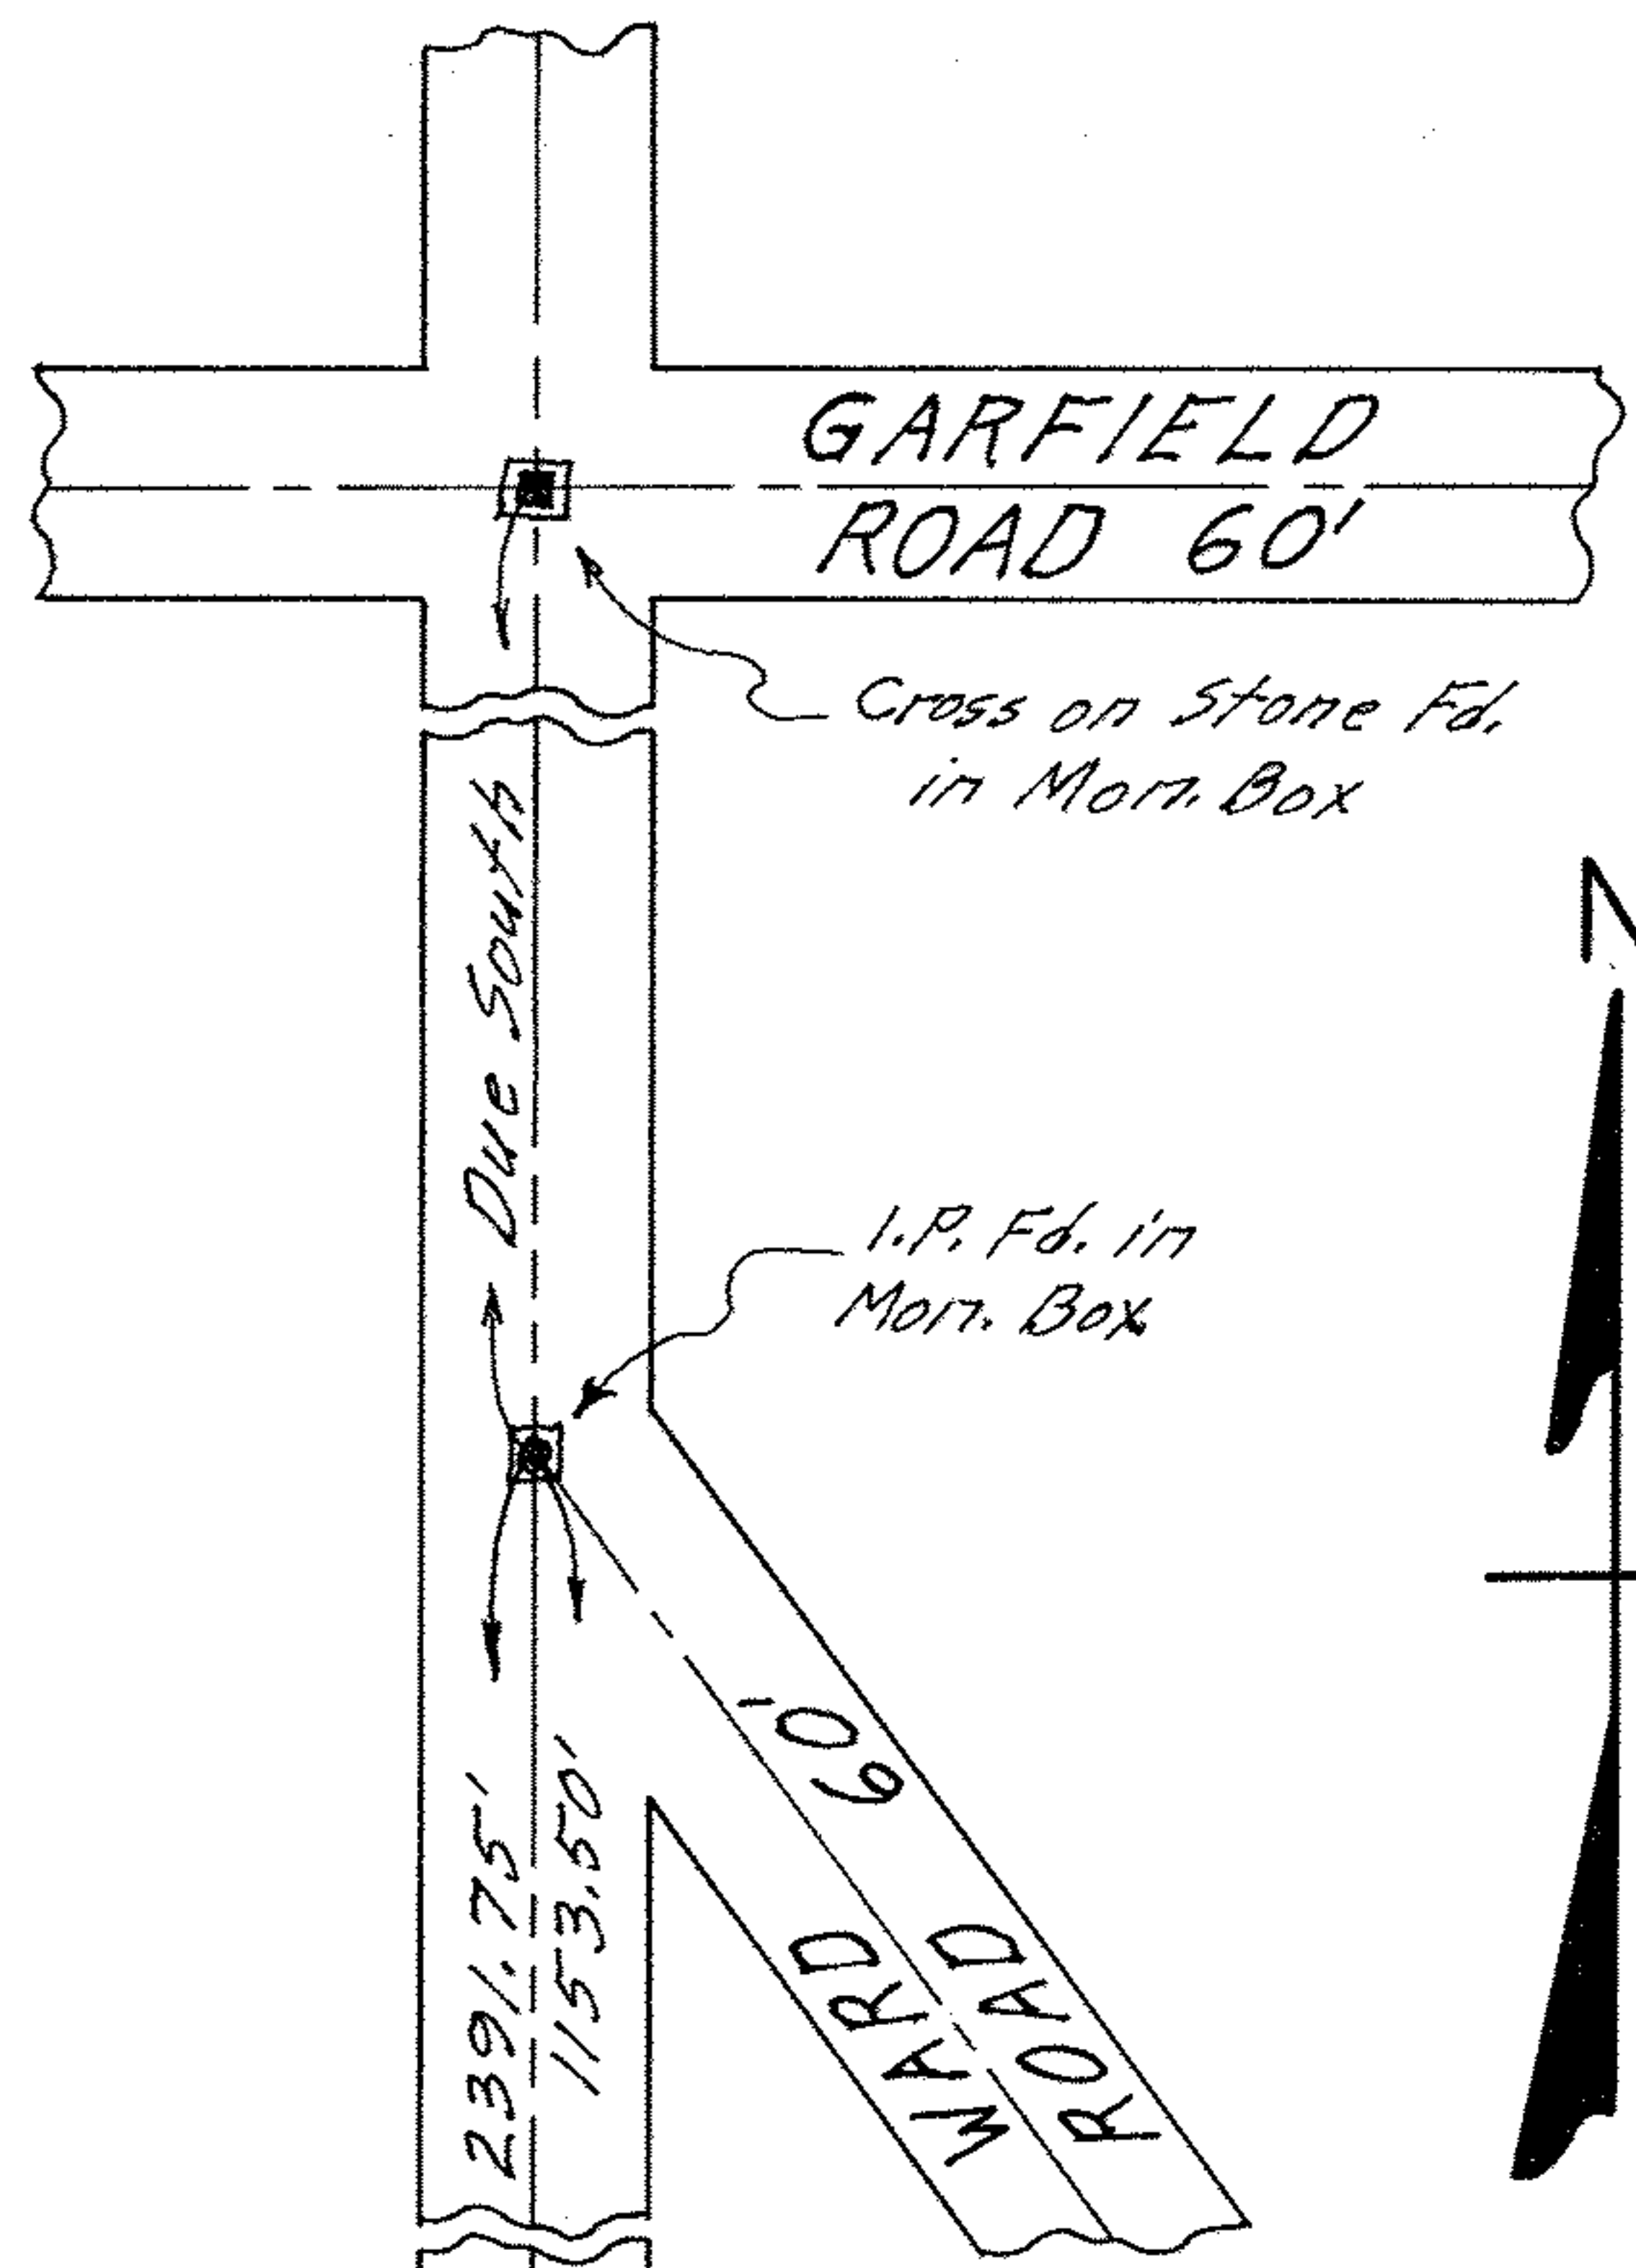

NOTE: In agreement with the 'Surveyor's Note' on the Plat of Survey dated April 22, 1961, of the land conveyed by Deed recorded in Vol. 812, Pg. 153, I find that the westerly occupation line of the Adam Horn land in Original Lot No. 1 follows the easterly line of Surplus Lot No. 24, and there is no physical evidence of the existence of the 8' offset strip referred to in deeds recorded in Vol. 80, Pg. 601, and in Vol. 316, Pg. 154, of Lorain County Deed Records.

Gary E. Penfound

Apparent more recent Survey encroaches onto land conveyed by D. Vol. 812, Pg. 153

Adam & Rose Horn  
 D. Vol. 128 Pg. 420

Adam Horn D. Vol. 80 Pg. 601