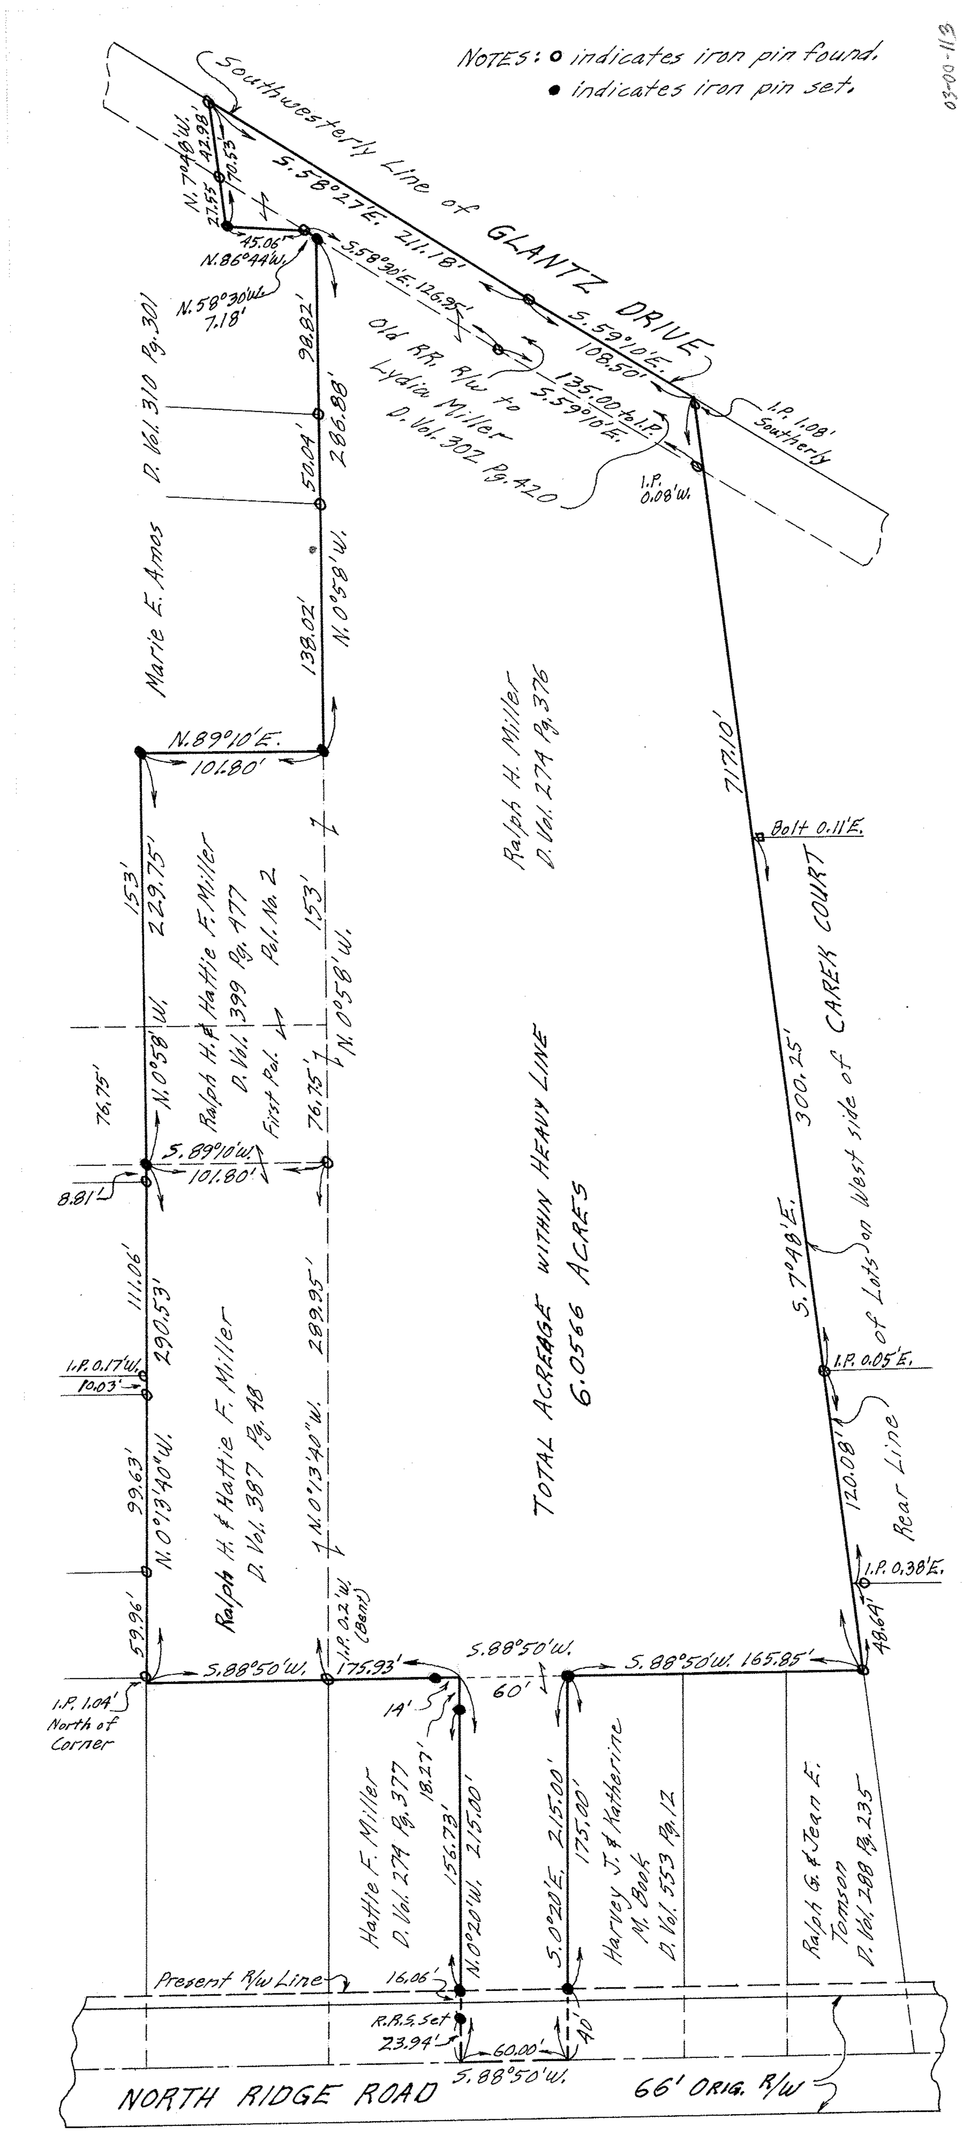

PLAT OF SURVEY FOR
RALPH H. & HATTIE F. MILLER
ORIGINAL LOT NO. 113 SHEFFIELD TWP.
LORAIN COUNTY OHIO
SCALE: 1" = 60' NOVEMBER 1971
Gary E. Penfound
Reg. Surveyor No. 4457

N

03-00-113-107-047 thru -050
3-00-113-B