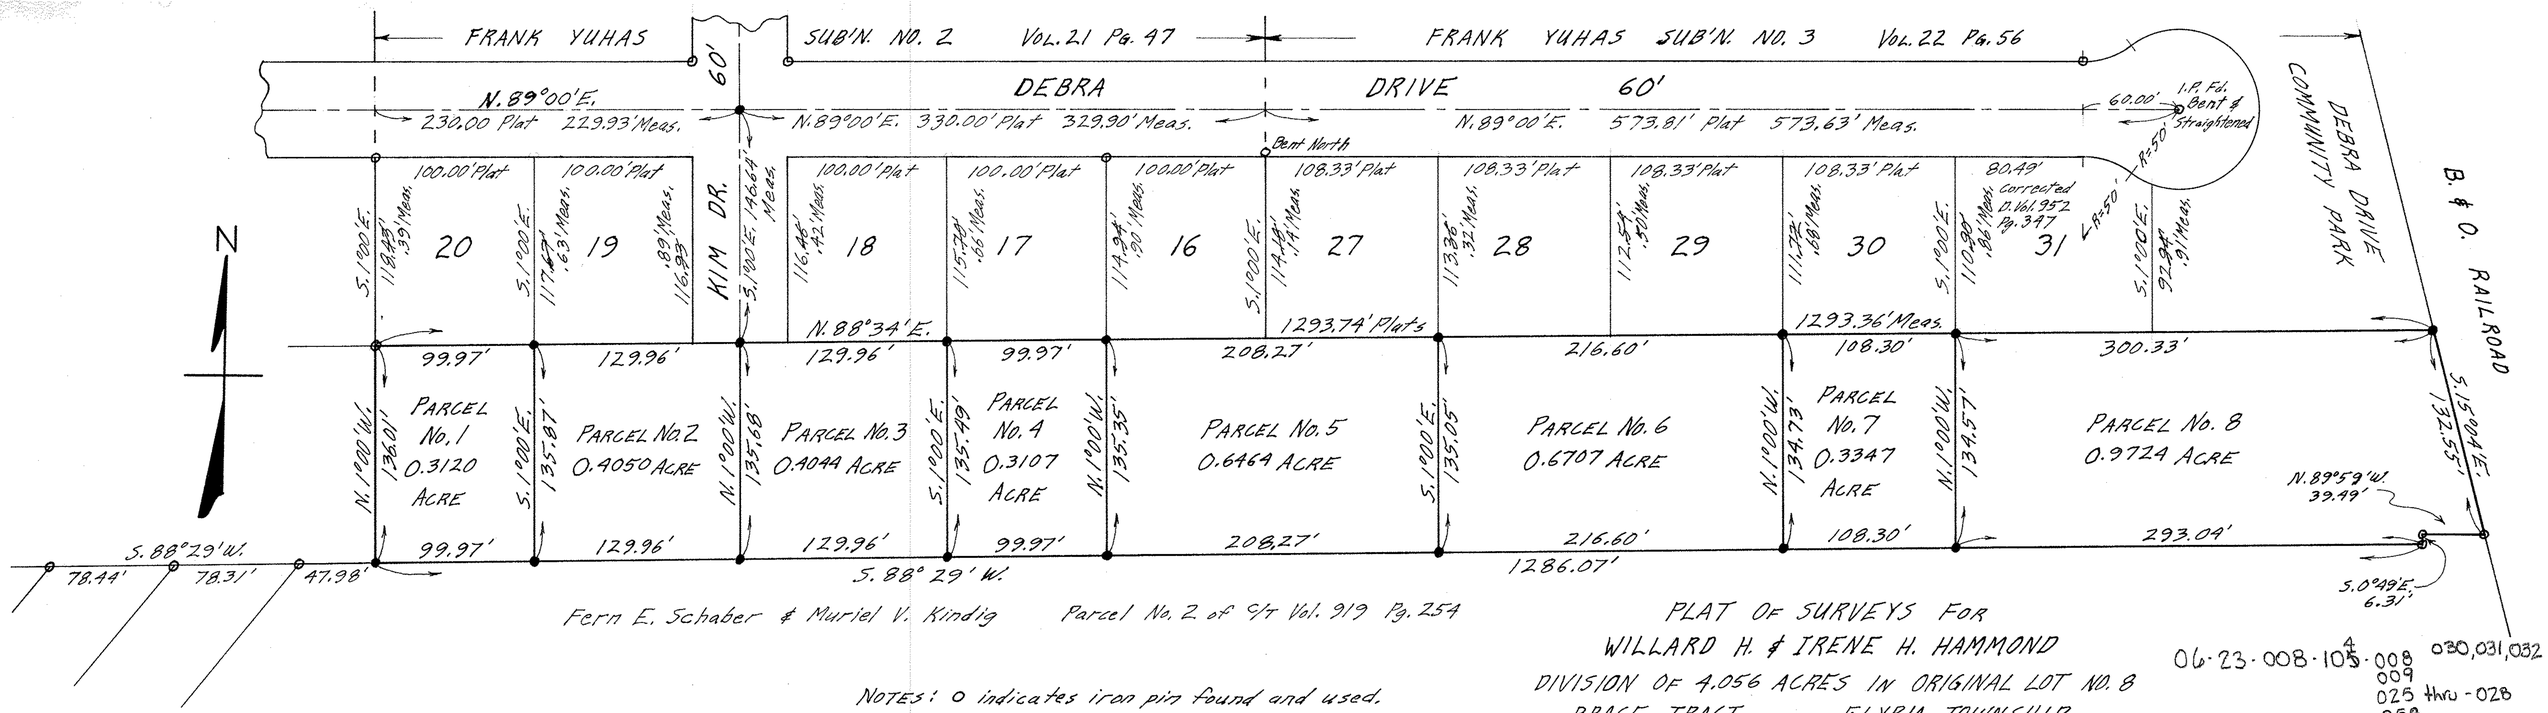

Fern E. Schaber & Muriel V. Kindig Parcel No. 2 of C/T Vol. 919 Pg. 254

NOTES: o indicates iron pin found and used.
• indicates iron pin set.
A shortage of 0.03' per 100' was found to exist in Subdivisions as orginally surveyed and monumented.

PLAT OF SURVEYS FOR
WILLARD H. & IRENE H. HAMMOND
DIVISION OF 4.056 ACRES IN ORIGINAL LOT NO. 8
BRACE TRACT ELYRIA TOWNSHIP
LORAIN COUNTY OHIO
SCALE: 1" = 60' OCTOBER 1970
Gary E. Penfound Reg. Surveyor No. 4957

06-23-008-105-008 030,031,032
009
025 thru -028
058
057

06-23-008-105-001 thru -008

6-25, 6-24

06-23-008