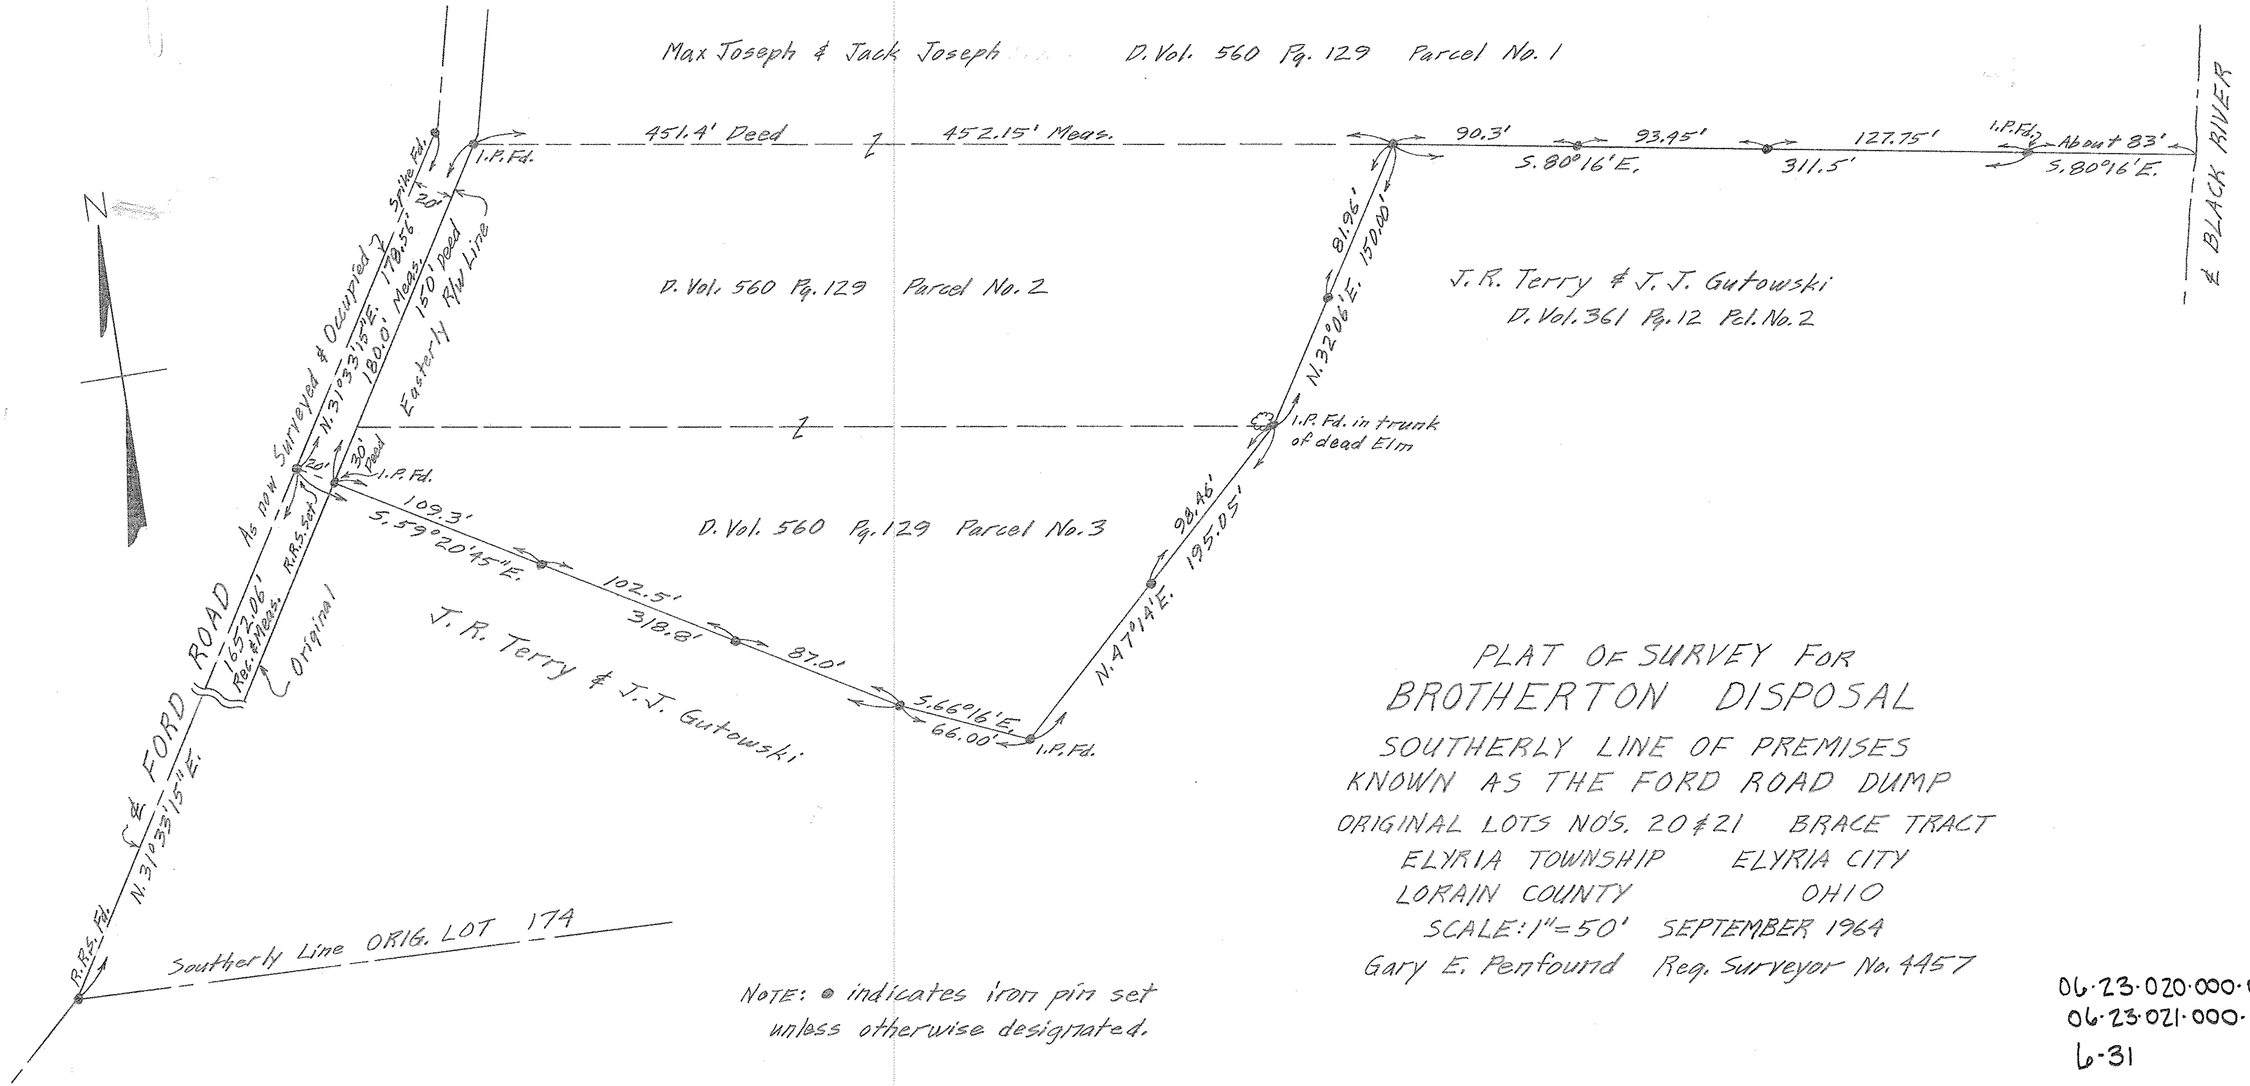

PLAT OF SURVEY FOR
BROTHERTON DISPOSAL
SOUTHERLY LINE OF PREMISES
KNOWN AS THE FORD ROAD DUMP
ORIGINAL LOTS NO'S. 20 & 21 BRACE TRACT
ELYRIA TOWNSHIP ELYRIA CITY
LORAIN COUNTY OHIO
SCALE: 1" = 50' SEPTEMBER 1964
Gary E. Pentfound Reg. Surveyor No. 4457

NOTE: ● indicates iron pin set unless otherwise designated.

06-23-020-000-006
06-23-021-000-021
6-31

06-23-020,201