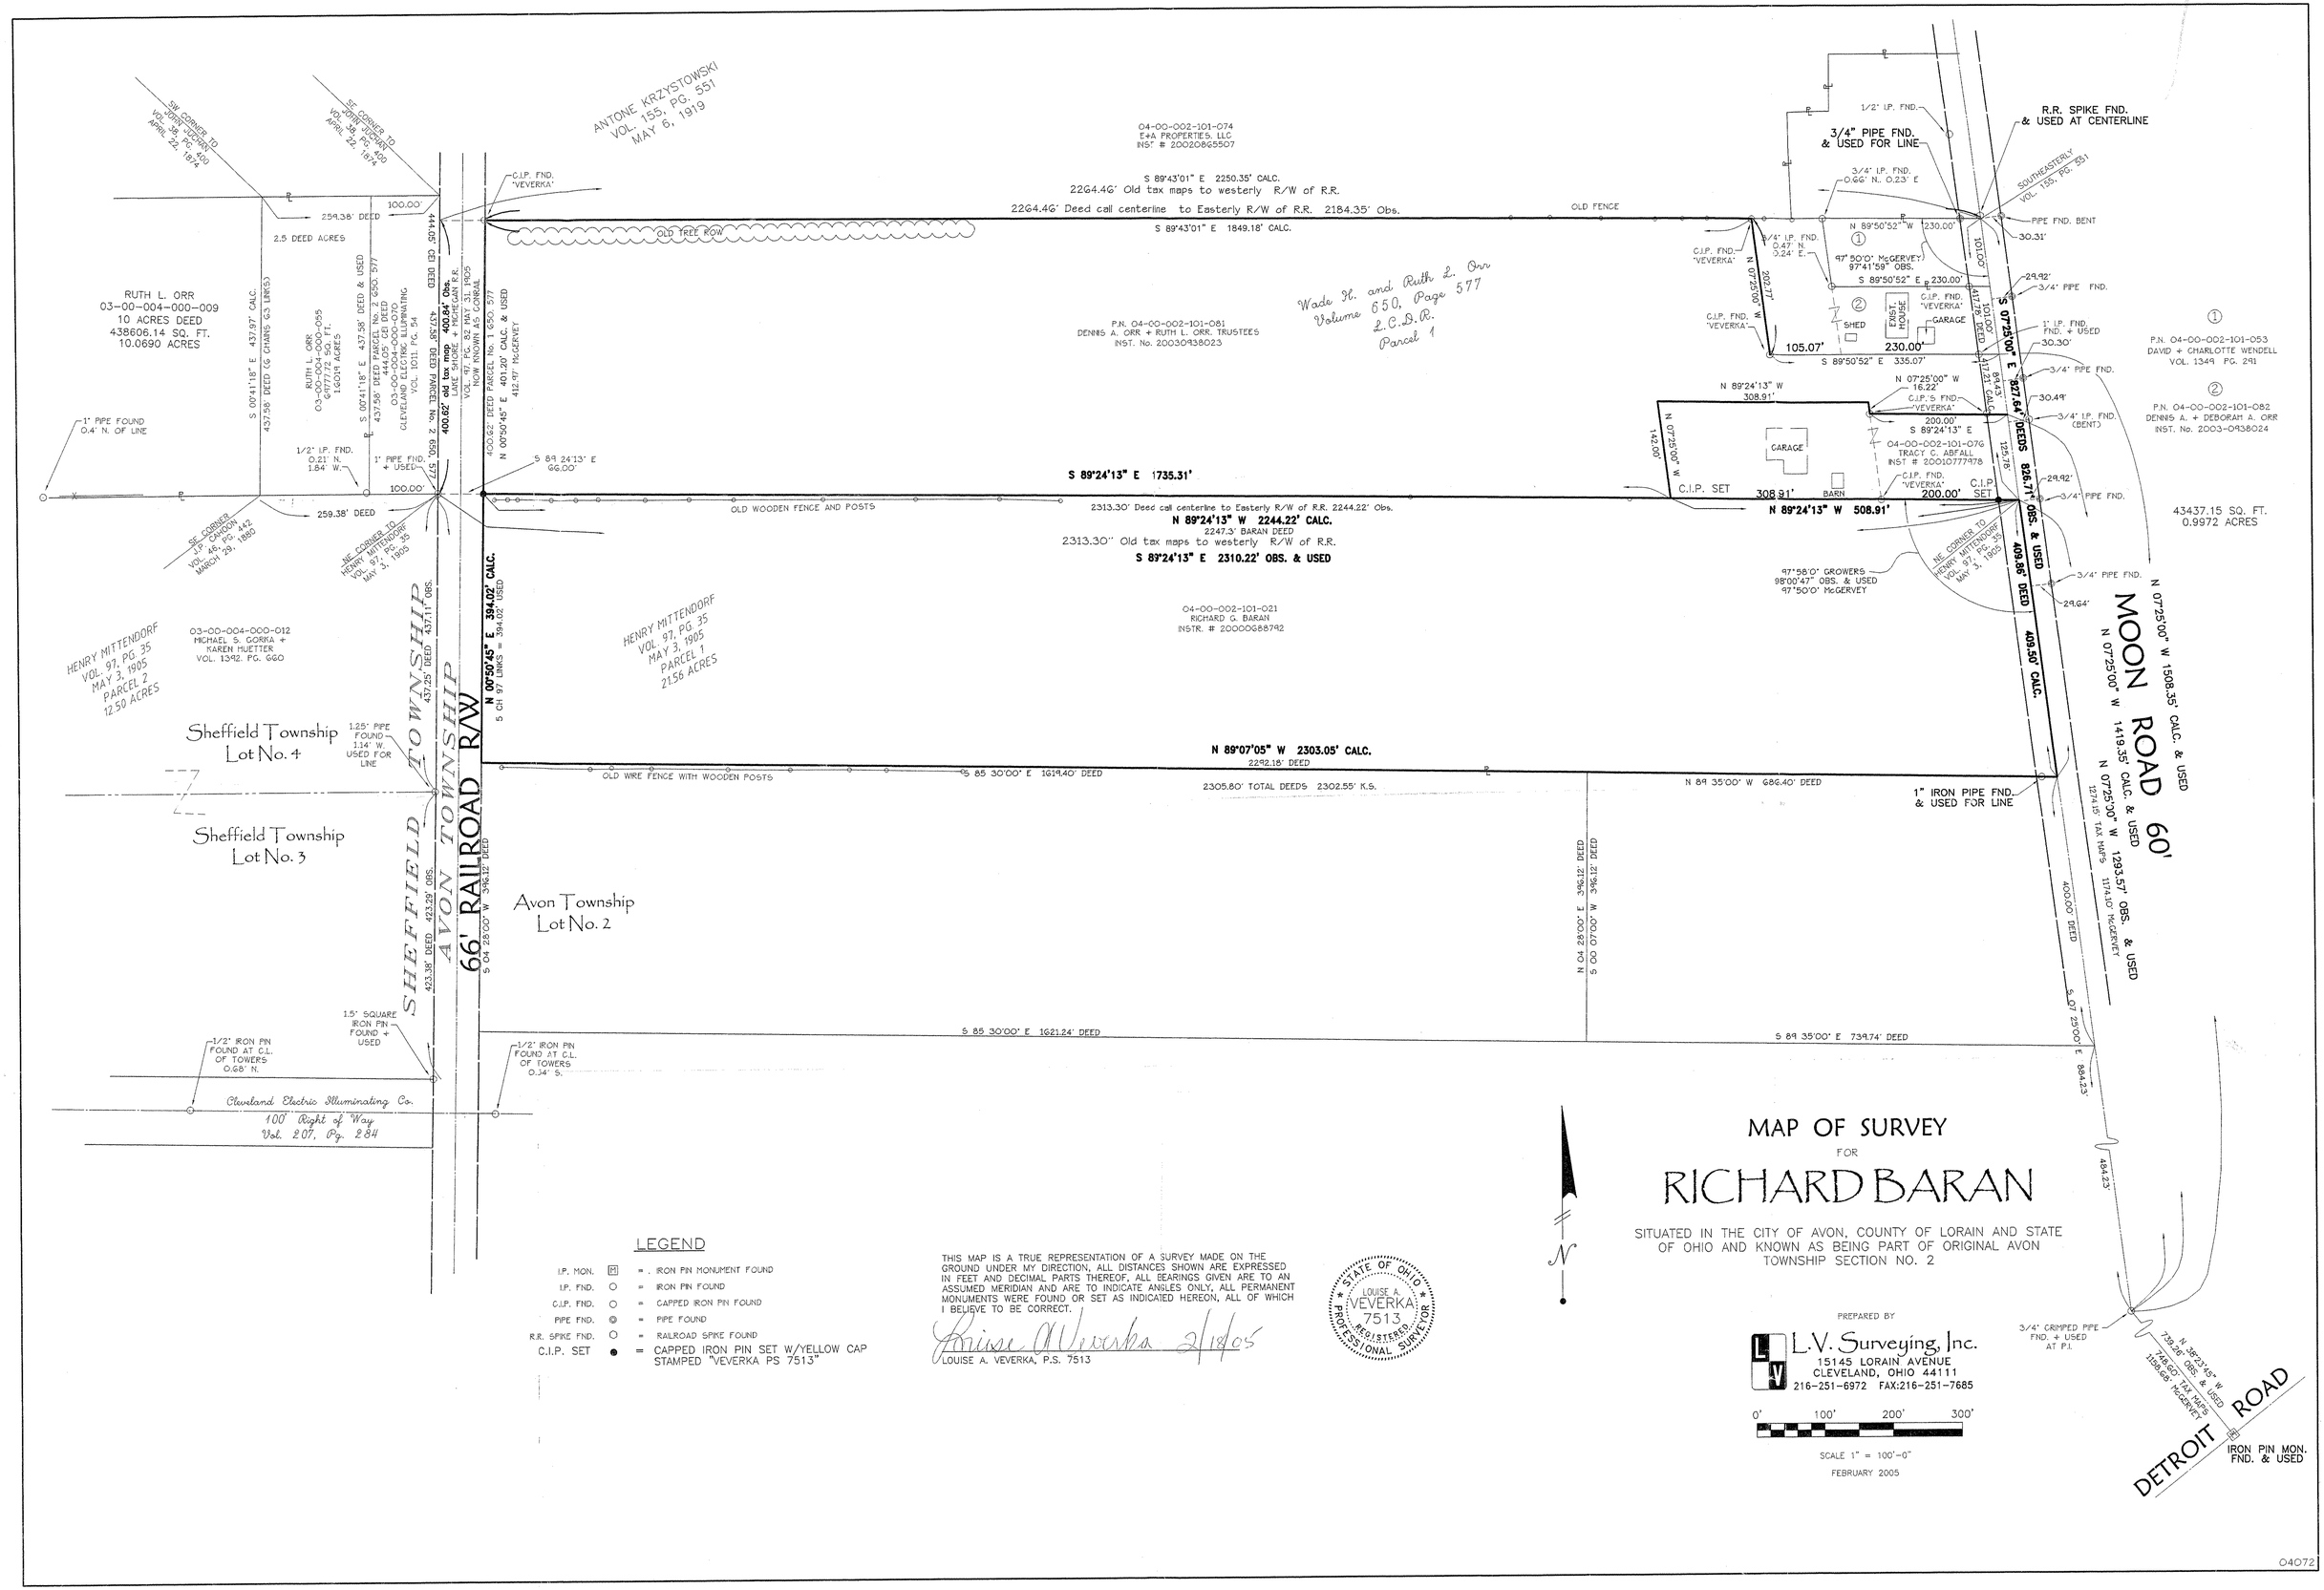

LEGEND

I.P. MON.	▣	= . IRON PIN MONUMENT FOUND
I.P. FND.	○	= IRON PIN FOUND
C.I.P. FND.	○	= CAPPED IRON PIN FOUND
PIPE FND.	◎	= PIPE FOUND
R.R. SPIKE FND.	○	= RAILROAD SPIKE FOUND
C.I.P. SET	●	= CAPPED IRON PIN SET W/YELLOW CAP STAMPED "VEVERKA PS 7513"

THIS MAP IS A TRUE REPRESENTATION OF A SURVEY MADE ON THE GROUND UNDER MY DIRECTION, ALL DISTANCES SHOWN ARE EXPRESSED IN FEET AND DECIMAL PARTS THEREOF, ALL BEARINGS GIVEN ARE TO AN ASSUMED MERIDIAN AND ARE TO INDICATE ANGLES ONLY, ALL PERMANENT MONUMENTS WERE FOUND OR SET AS INDICATED HEREON, ALL OF WHICH I BELIEVE TO BE CORRECT.

Louise A. Veverka 2/18/05

LOUISE A. VEVERKA, P.S. 7513

STATE OF OHIO
LOUISE A. VEVERKA
7513
REGISTERED
PROFESSIONAL SURVEYOR

MAP OF SURVEY

FOR

RICHARD BARAN

SITUATED IN THE CITY OF AVON, COUNTY OF LORAIN AND STATE OF OHIO AND KNOWN AS BEING PART OF ORIGINAL AVON TOWNSHIP SECTION NO. 2

PREPARED BY

L.V. Surveying, Inc.
15145 LORAIN AVENUE
CLEVELAND, OHIO 44111
216-251-6972 FAX:216-251-7685

0' 100' 200' 300'

SCALE 1" = 100'-0"

FEBRUARY 2005

04072