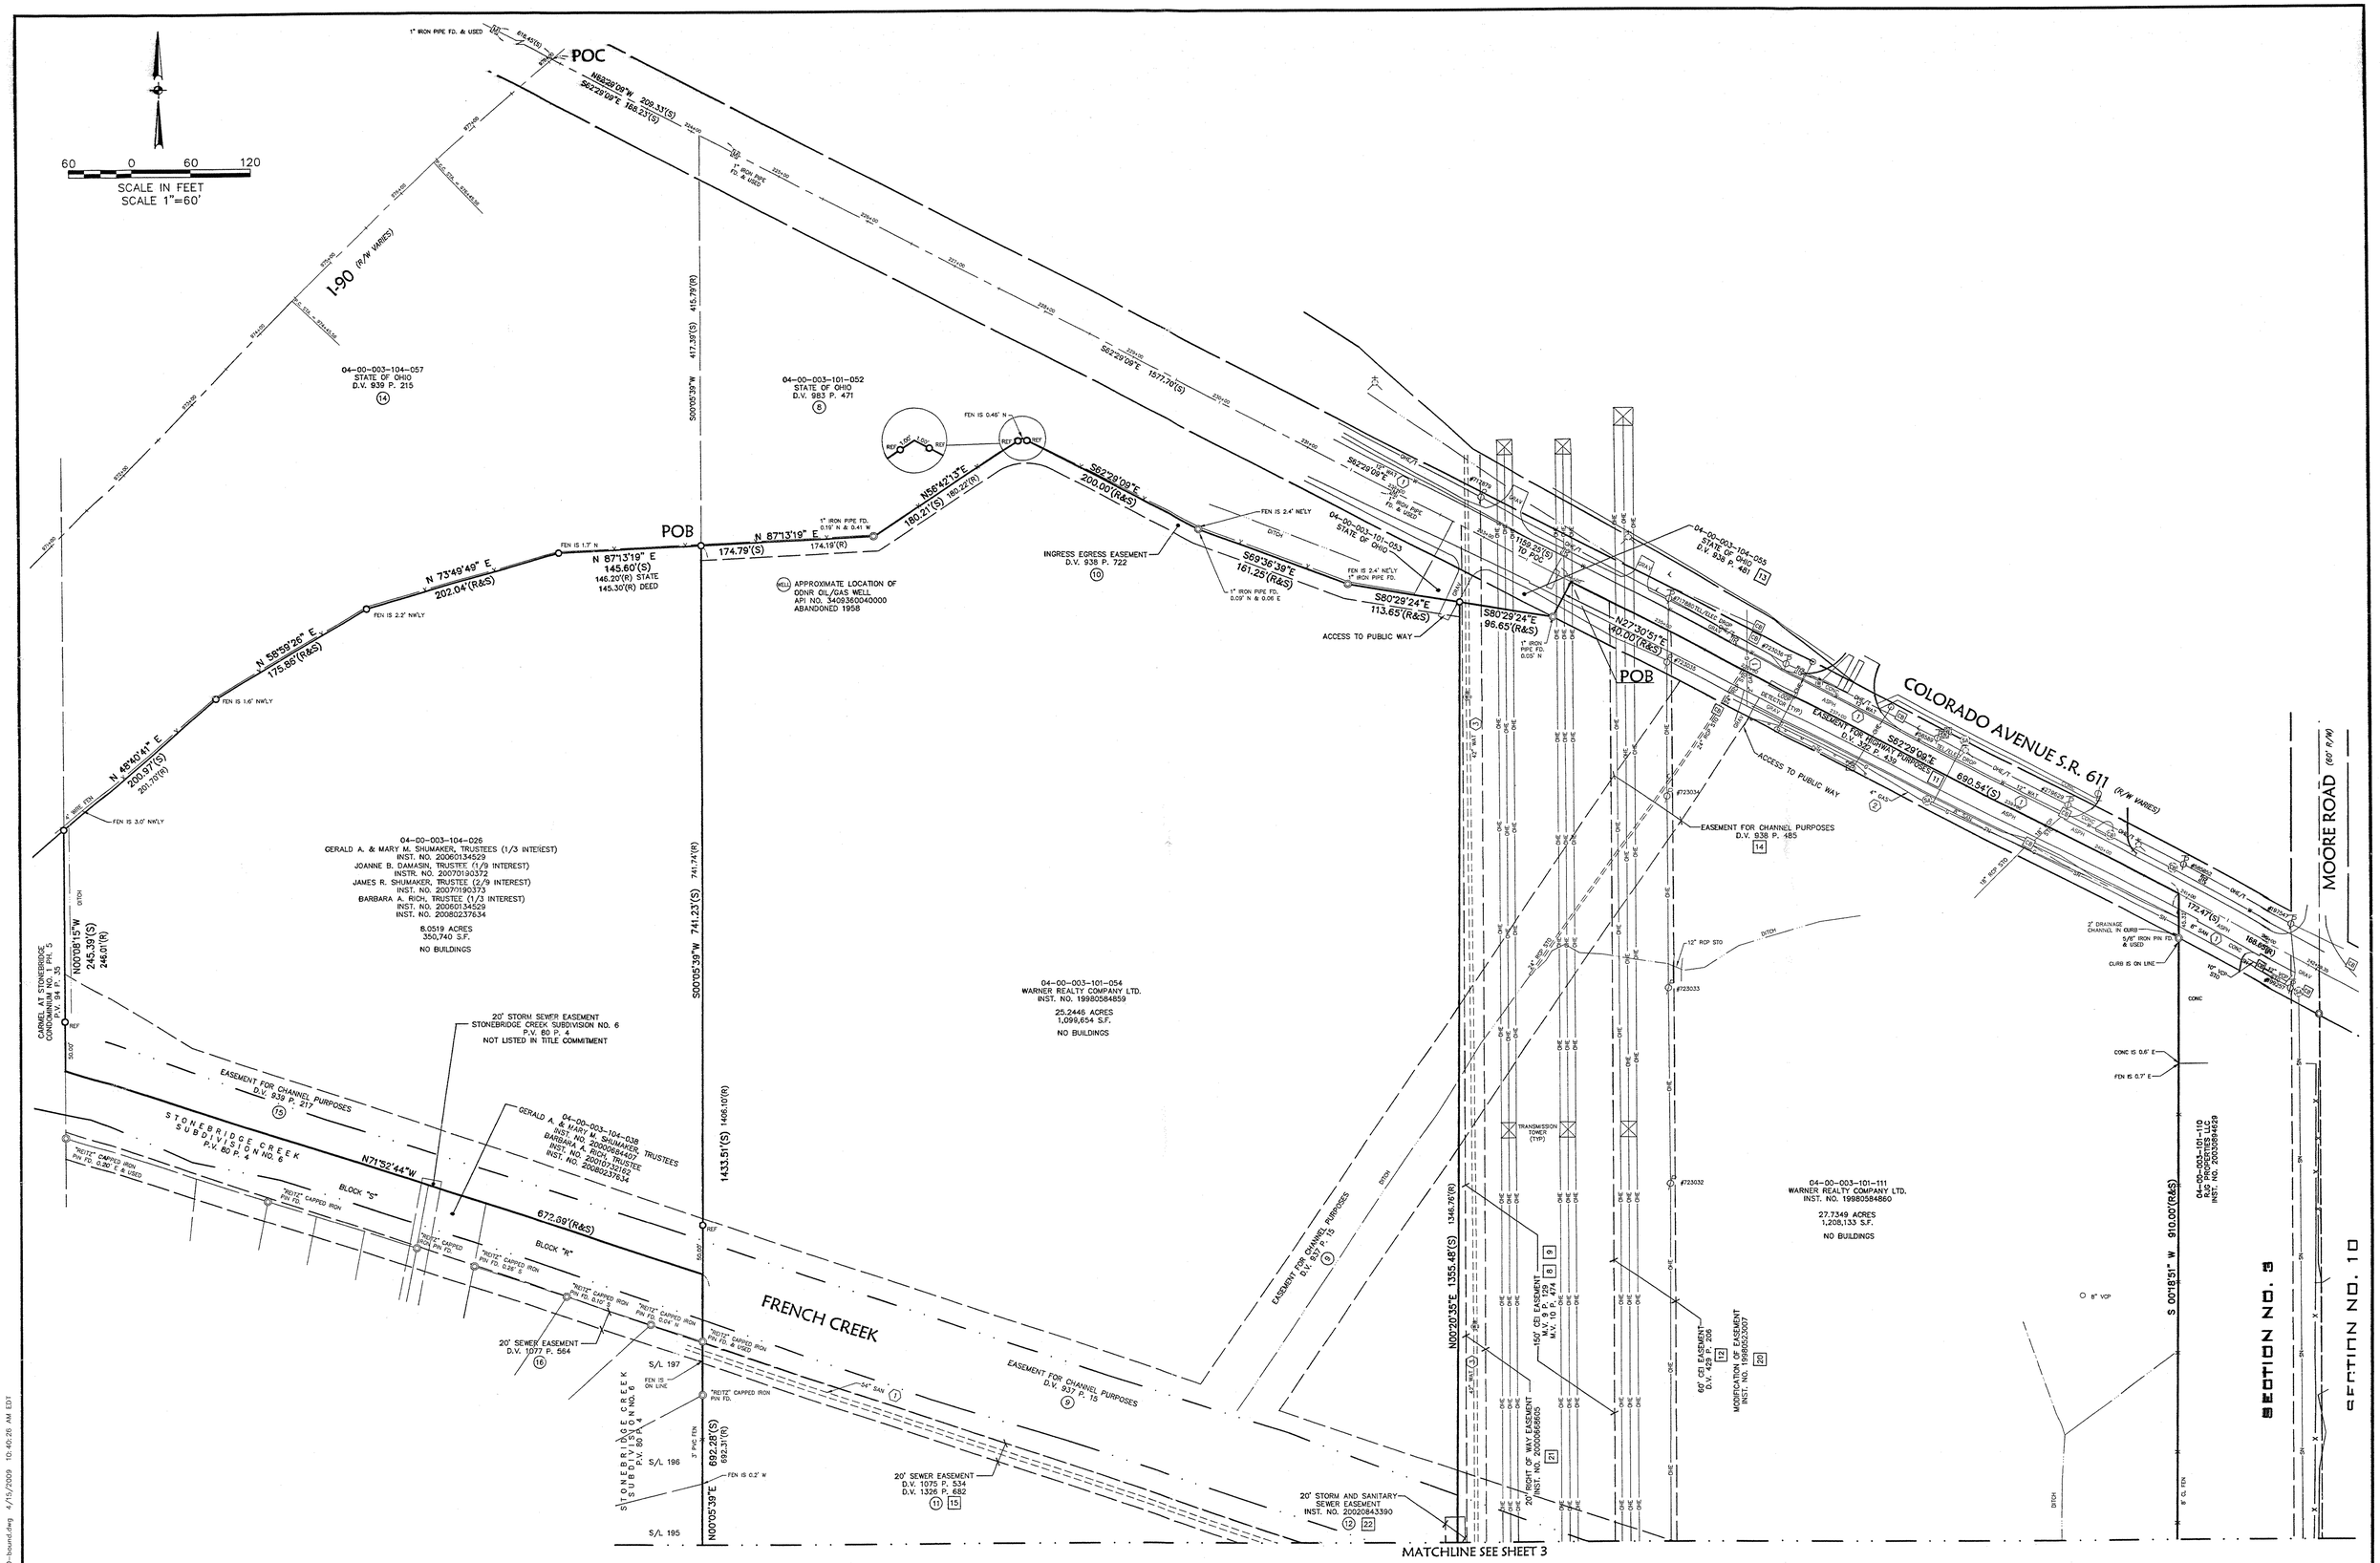

DATE:	3-20-09
DRAWN BY:	MM
CH'D BY:	TPB
DWG. NAME:	0-bound
PATH:	ldot/control
F.B.	819

REVISIONS

DATE	DESCRIPTION	BY
4-15-09	ADDED CHANNEL EASEMENT	MM

KS ASSOCIATES
KS Associates, Inc.
260 Burns Road, Suite 100
Elyria, OH 44035
P 440 365 4730
F 440 365 4790
www.ksassociates.com

ALTA / ACSM LAND TITLE SURVEY

PART OF ORIGINAL AVON TOWNSHIP SECTION NO. 3
CITY OF AVON, COUNTY OF LORAIN
STATE OF OHIO

SHEET 2 OF 4

JOB NO. 09045

R:\09000\09045\ldot\control\dwg\0-bound.dwg 4/15/2009 10:40:29 AM EDT