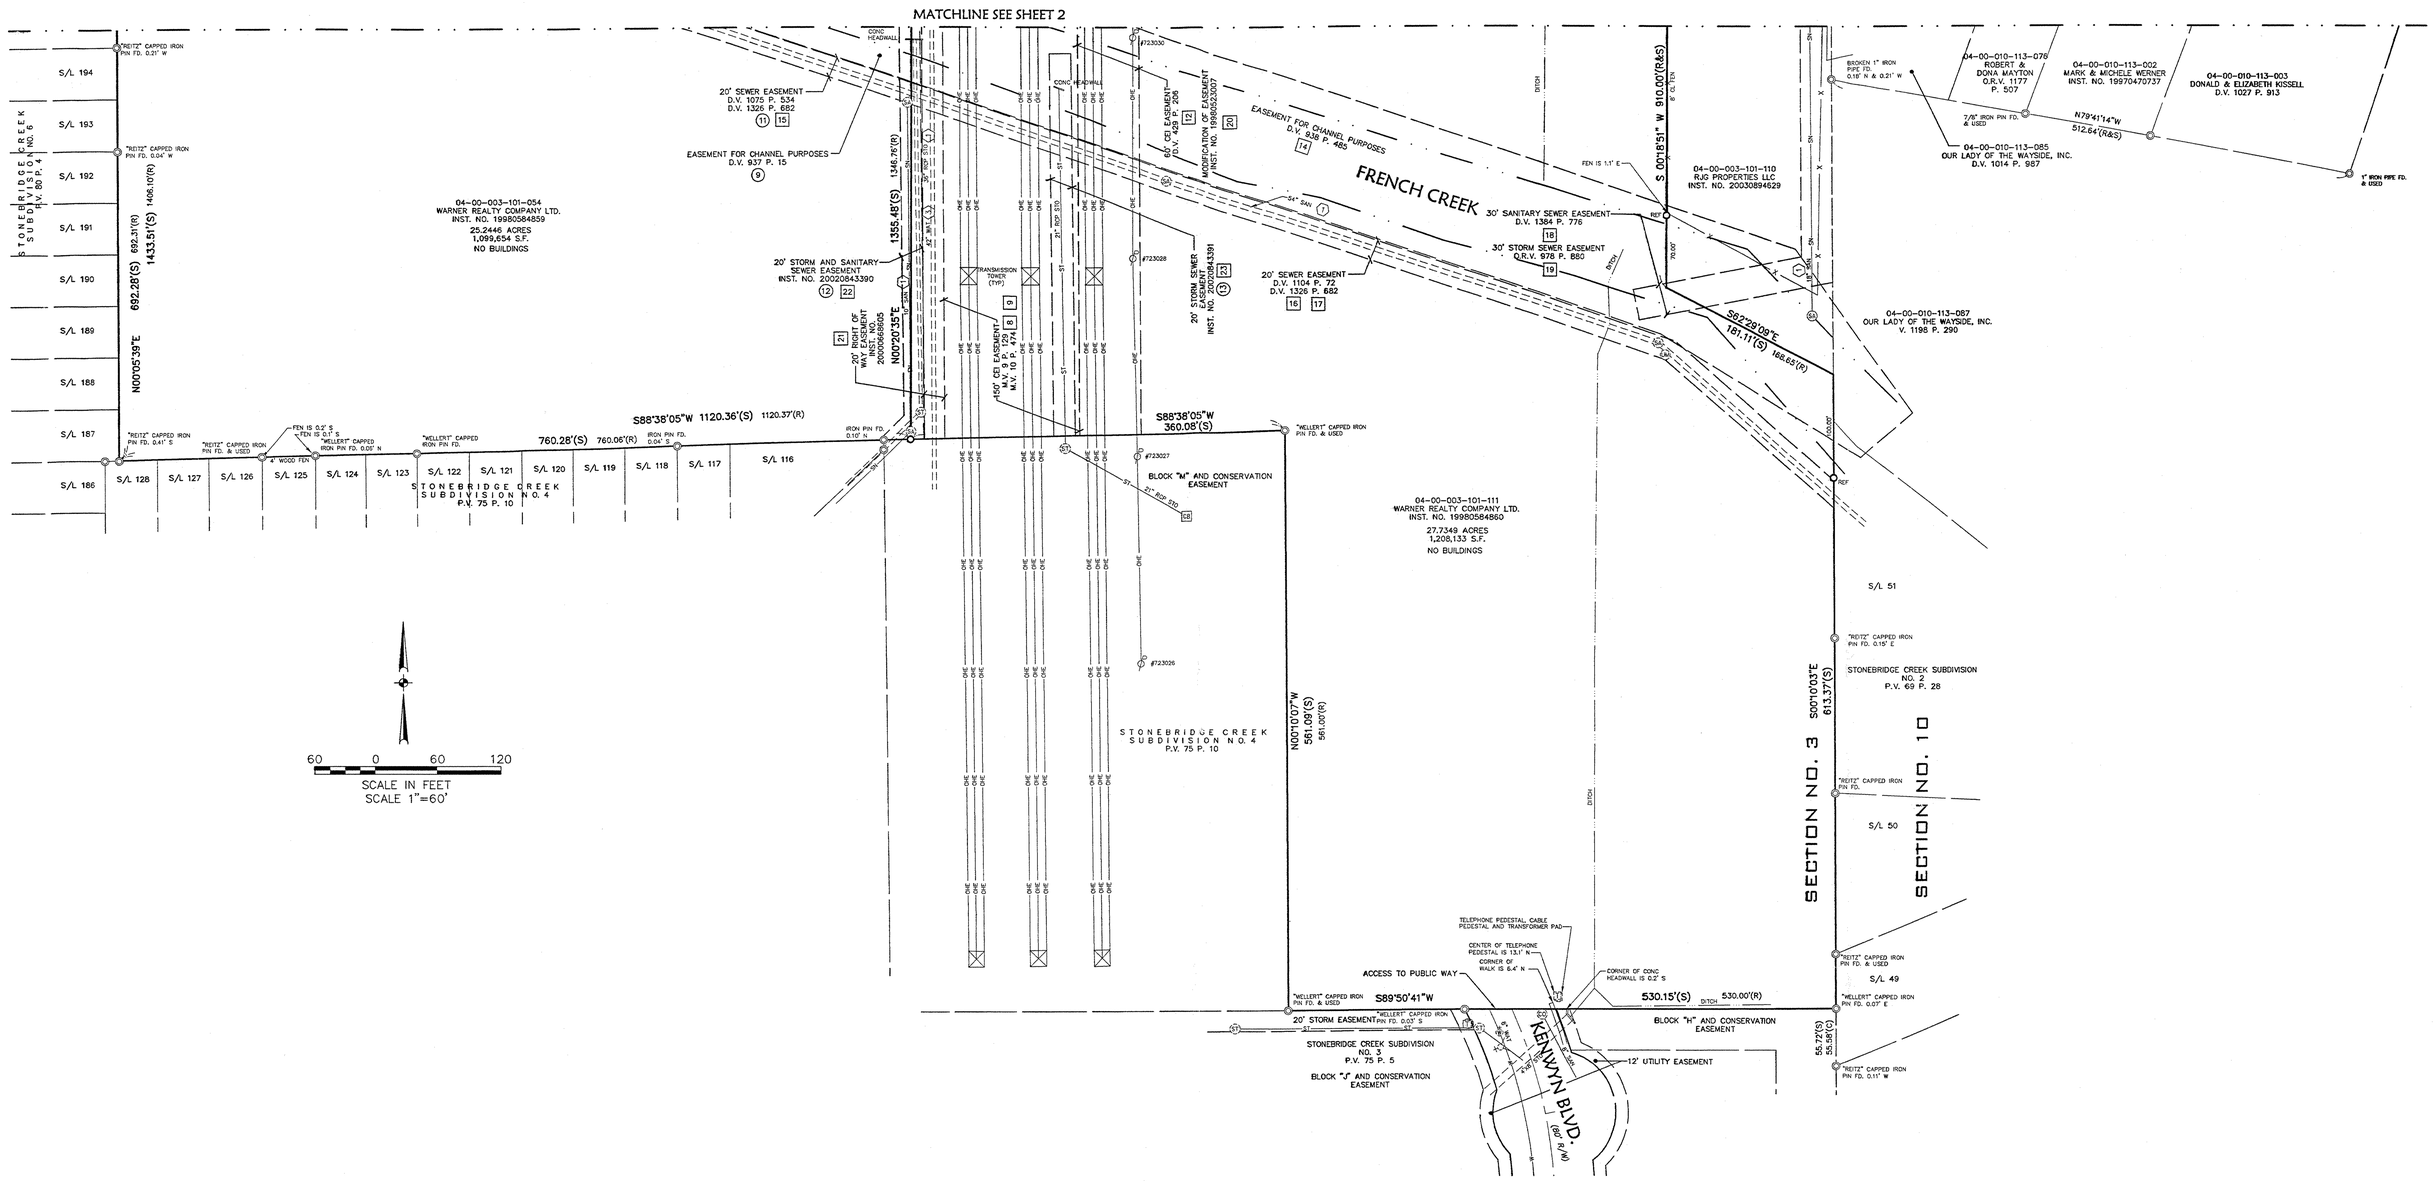

DATE: 3-20-09	REVISIONS	DATE	DESCRIPTION	BY
DRAWN BY: MM				
CH'D BY: TAB				
DWG. NAME: O-bound				
PATH: ldot/control				
F.B. 819		4-15-09	ADDED CHANNEL EASEMENT	MM

KS ASSOCIATES
KS Associates, Inc.
260 Burns Road, Suite 100
Elyria, OH 44035
P 440 365 4730
F 440 365 4790
www.ksassociates.com

ALTA / ACSM LAND TITLE SURVEY

PART OF ORIGINAL AVON TOWNSHIP SECTION NO. 3
CITY OF AVON, COUNTY OF LORAIN
STATE OF OHIO

SHEET 3 OF 4

JOB NO. 09045

R:\09000\09045\ldot\control\dwg\O-bound.dwg 4/15/2009 10:40:26 AM EDT