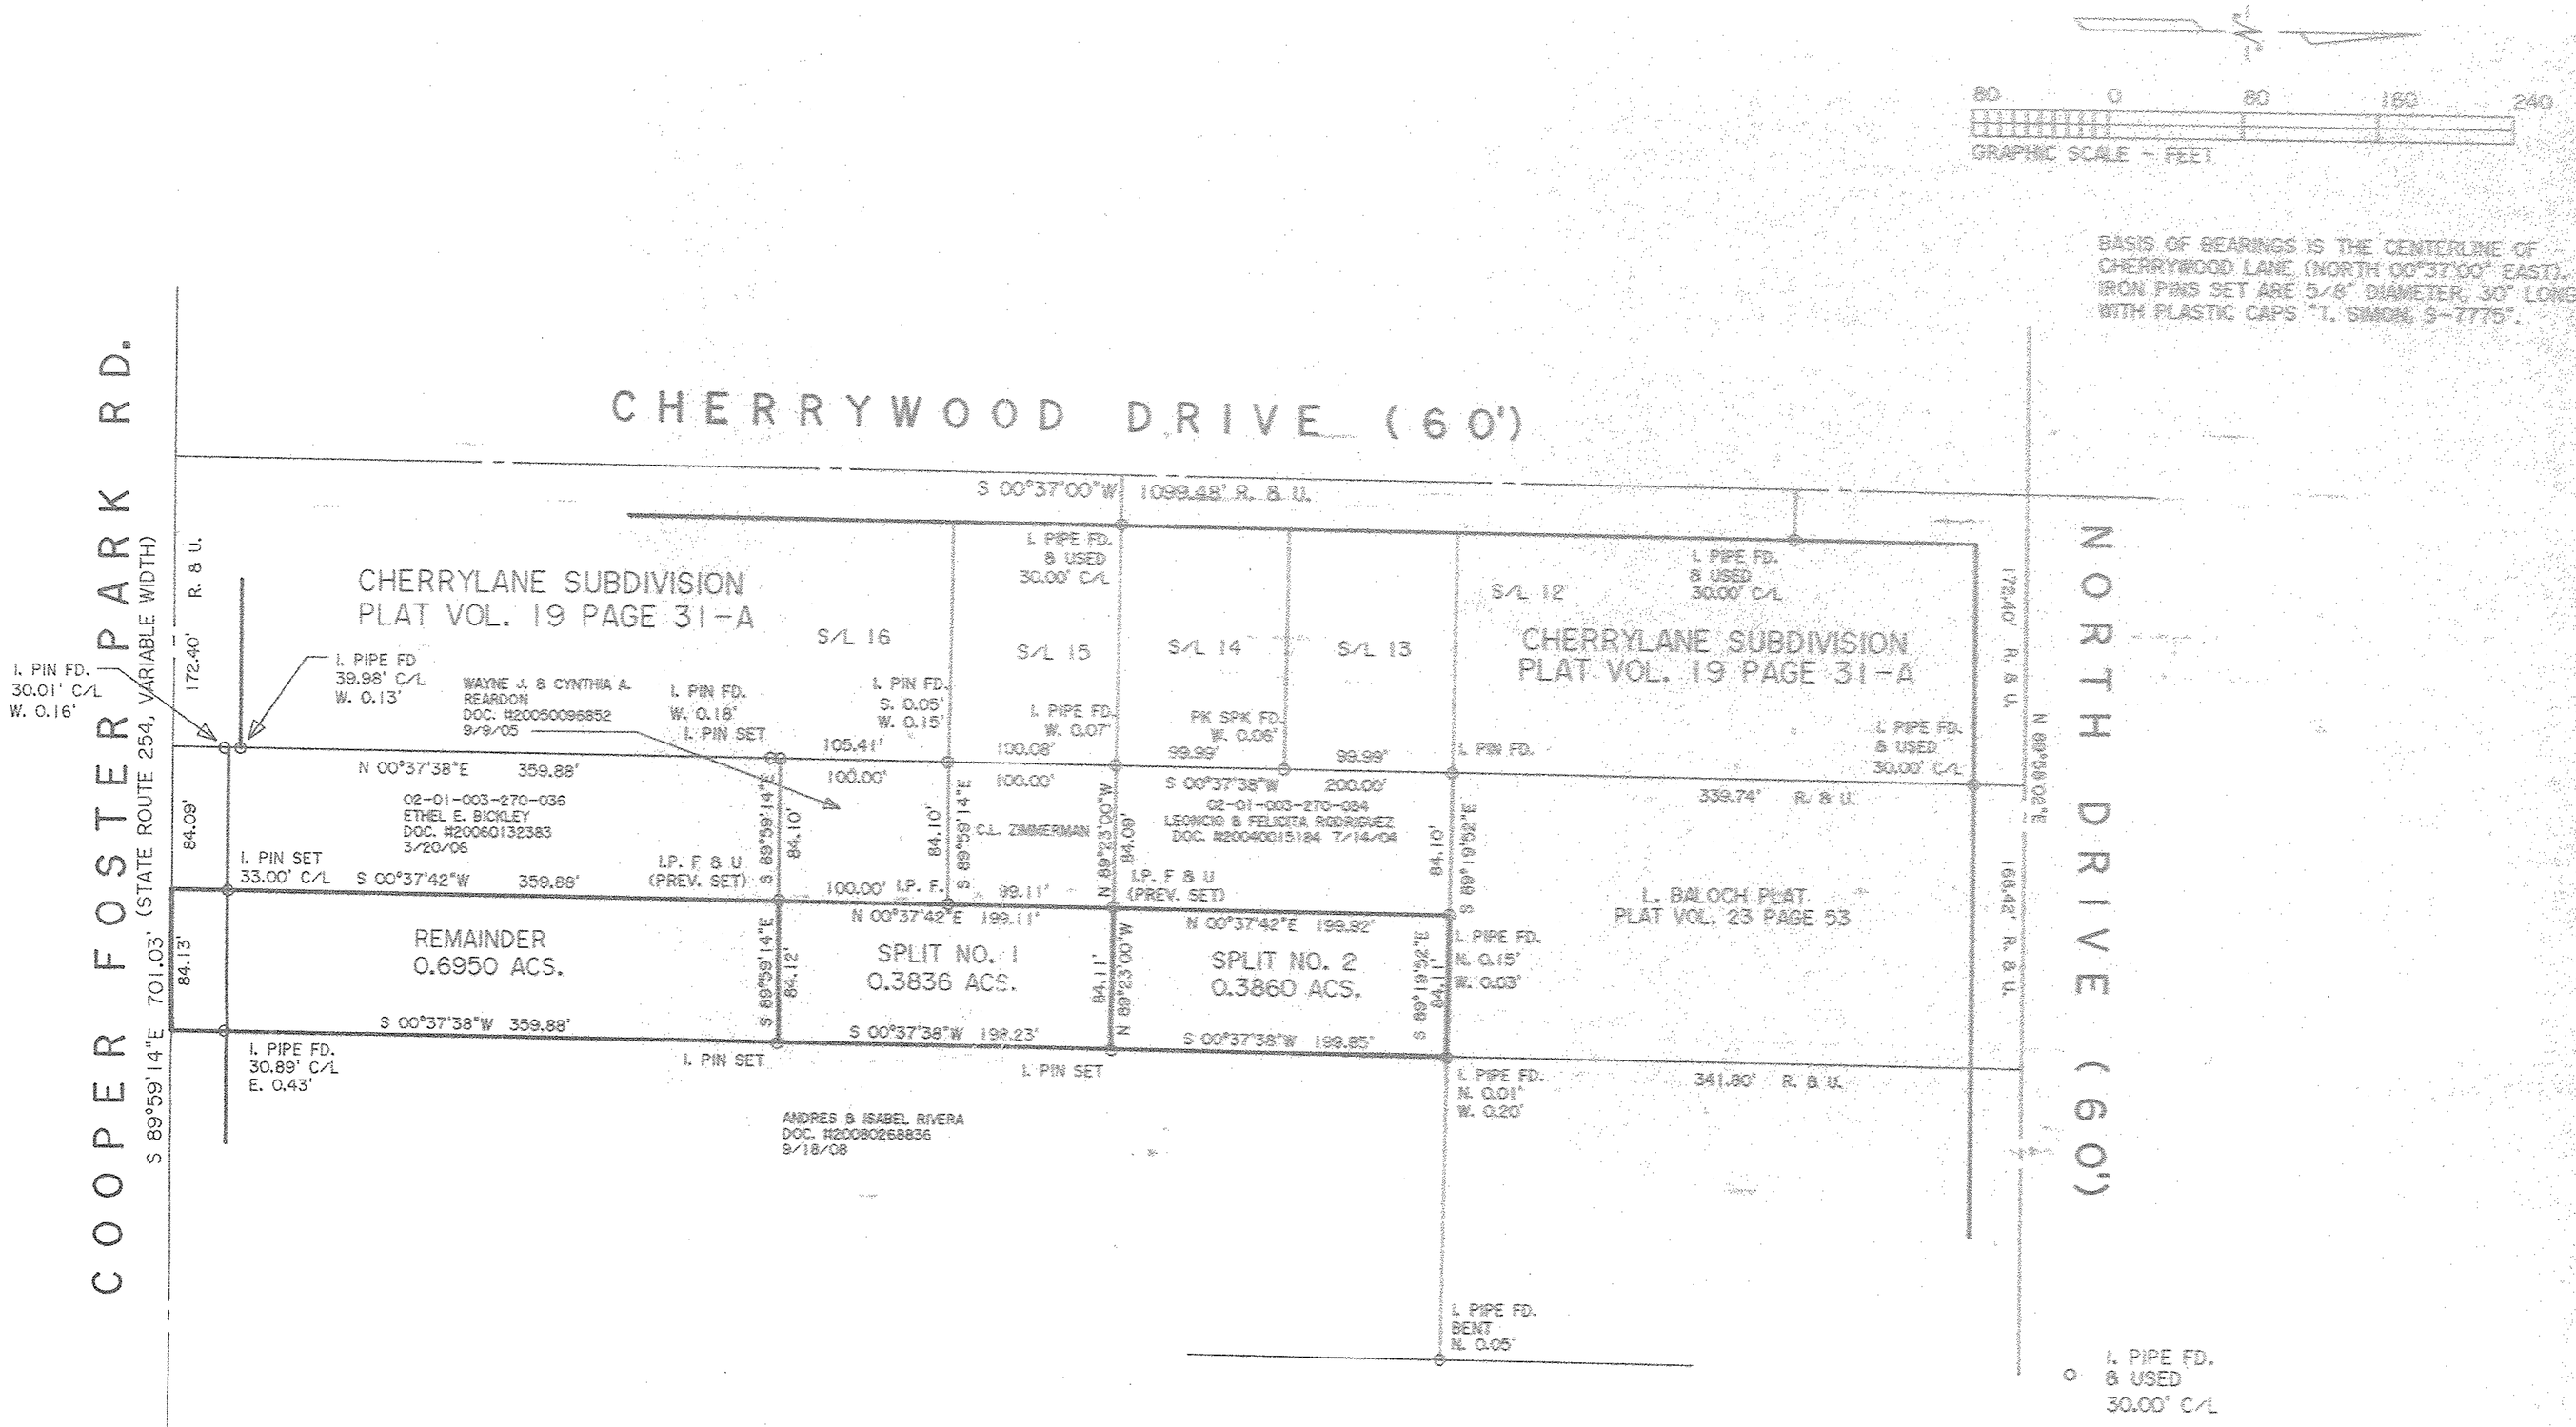

02746
APPROVED
LORAIN CO.
MAP DEPT
DATE 9-25-09
PAGE 027-003-270-013
027-01-003-270-034
BY JHH
A 09-02746

DIMENSIONS SHOWN ON THIS PLAT ARE EXPRESSED IN FEET AND DECIMAL PARTS THEREOF, ALL BEARINGS ARE TO AN ASSUMED MERIDIAN AND ARE USED TO INDICATE ANGLES ONLY. PERMANENT MONUMENTS WERE FOUND OR SET AT ALL POINTS INDICATED HEREON, ALL OF WHICH I CERTIFY TO BE CORRECT.

STATE OF OHIO THOMAS A. SIMON S-7775 REGISTERED PROFESSIONAL SURVEYOR

THOMAS A. SIMON
REG. PROFESSIONAL SURVEYOR
NO. S-7775

APPROVED
DESCRIPTION ONLY
8-19-09
City of Lorain
by Jessica S. Potter
Engineering Dept.

APPROVED BY THE LORAIN CITY PLANNING COMMISSION..... NO PLAT REQUIRED
8-20-09
SECRETARY LORAIN CITY PLANNING COMMISSION

PLAT OF SURVEY AND SPLIT FOR ALBERT A. & LINDA J. DOHANYOS

BEING KNOWN AS PART OF ORIGINAL BLACK RIVER TOWNSHIP LOT NO. 3, TRACT I

CITY OF LORAIN COUNTY OF LORAIN
STATE OF OHIO

JULY, 2009 SCALE: 1" = 80'

THOMAS SIMON & ASSOCIATES, INC.
PROFESSIONAL LAND SURVEYORS
150 SOUTH OLIVE STREET
ELYRIA, OHIO 44035
(440) 327-2925
FAX 327-2964

JOB NO. 2009-030
CRD. 2002-068
JOB NO. 2002-068