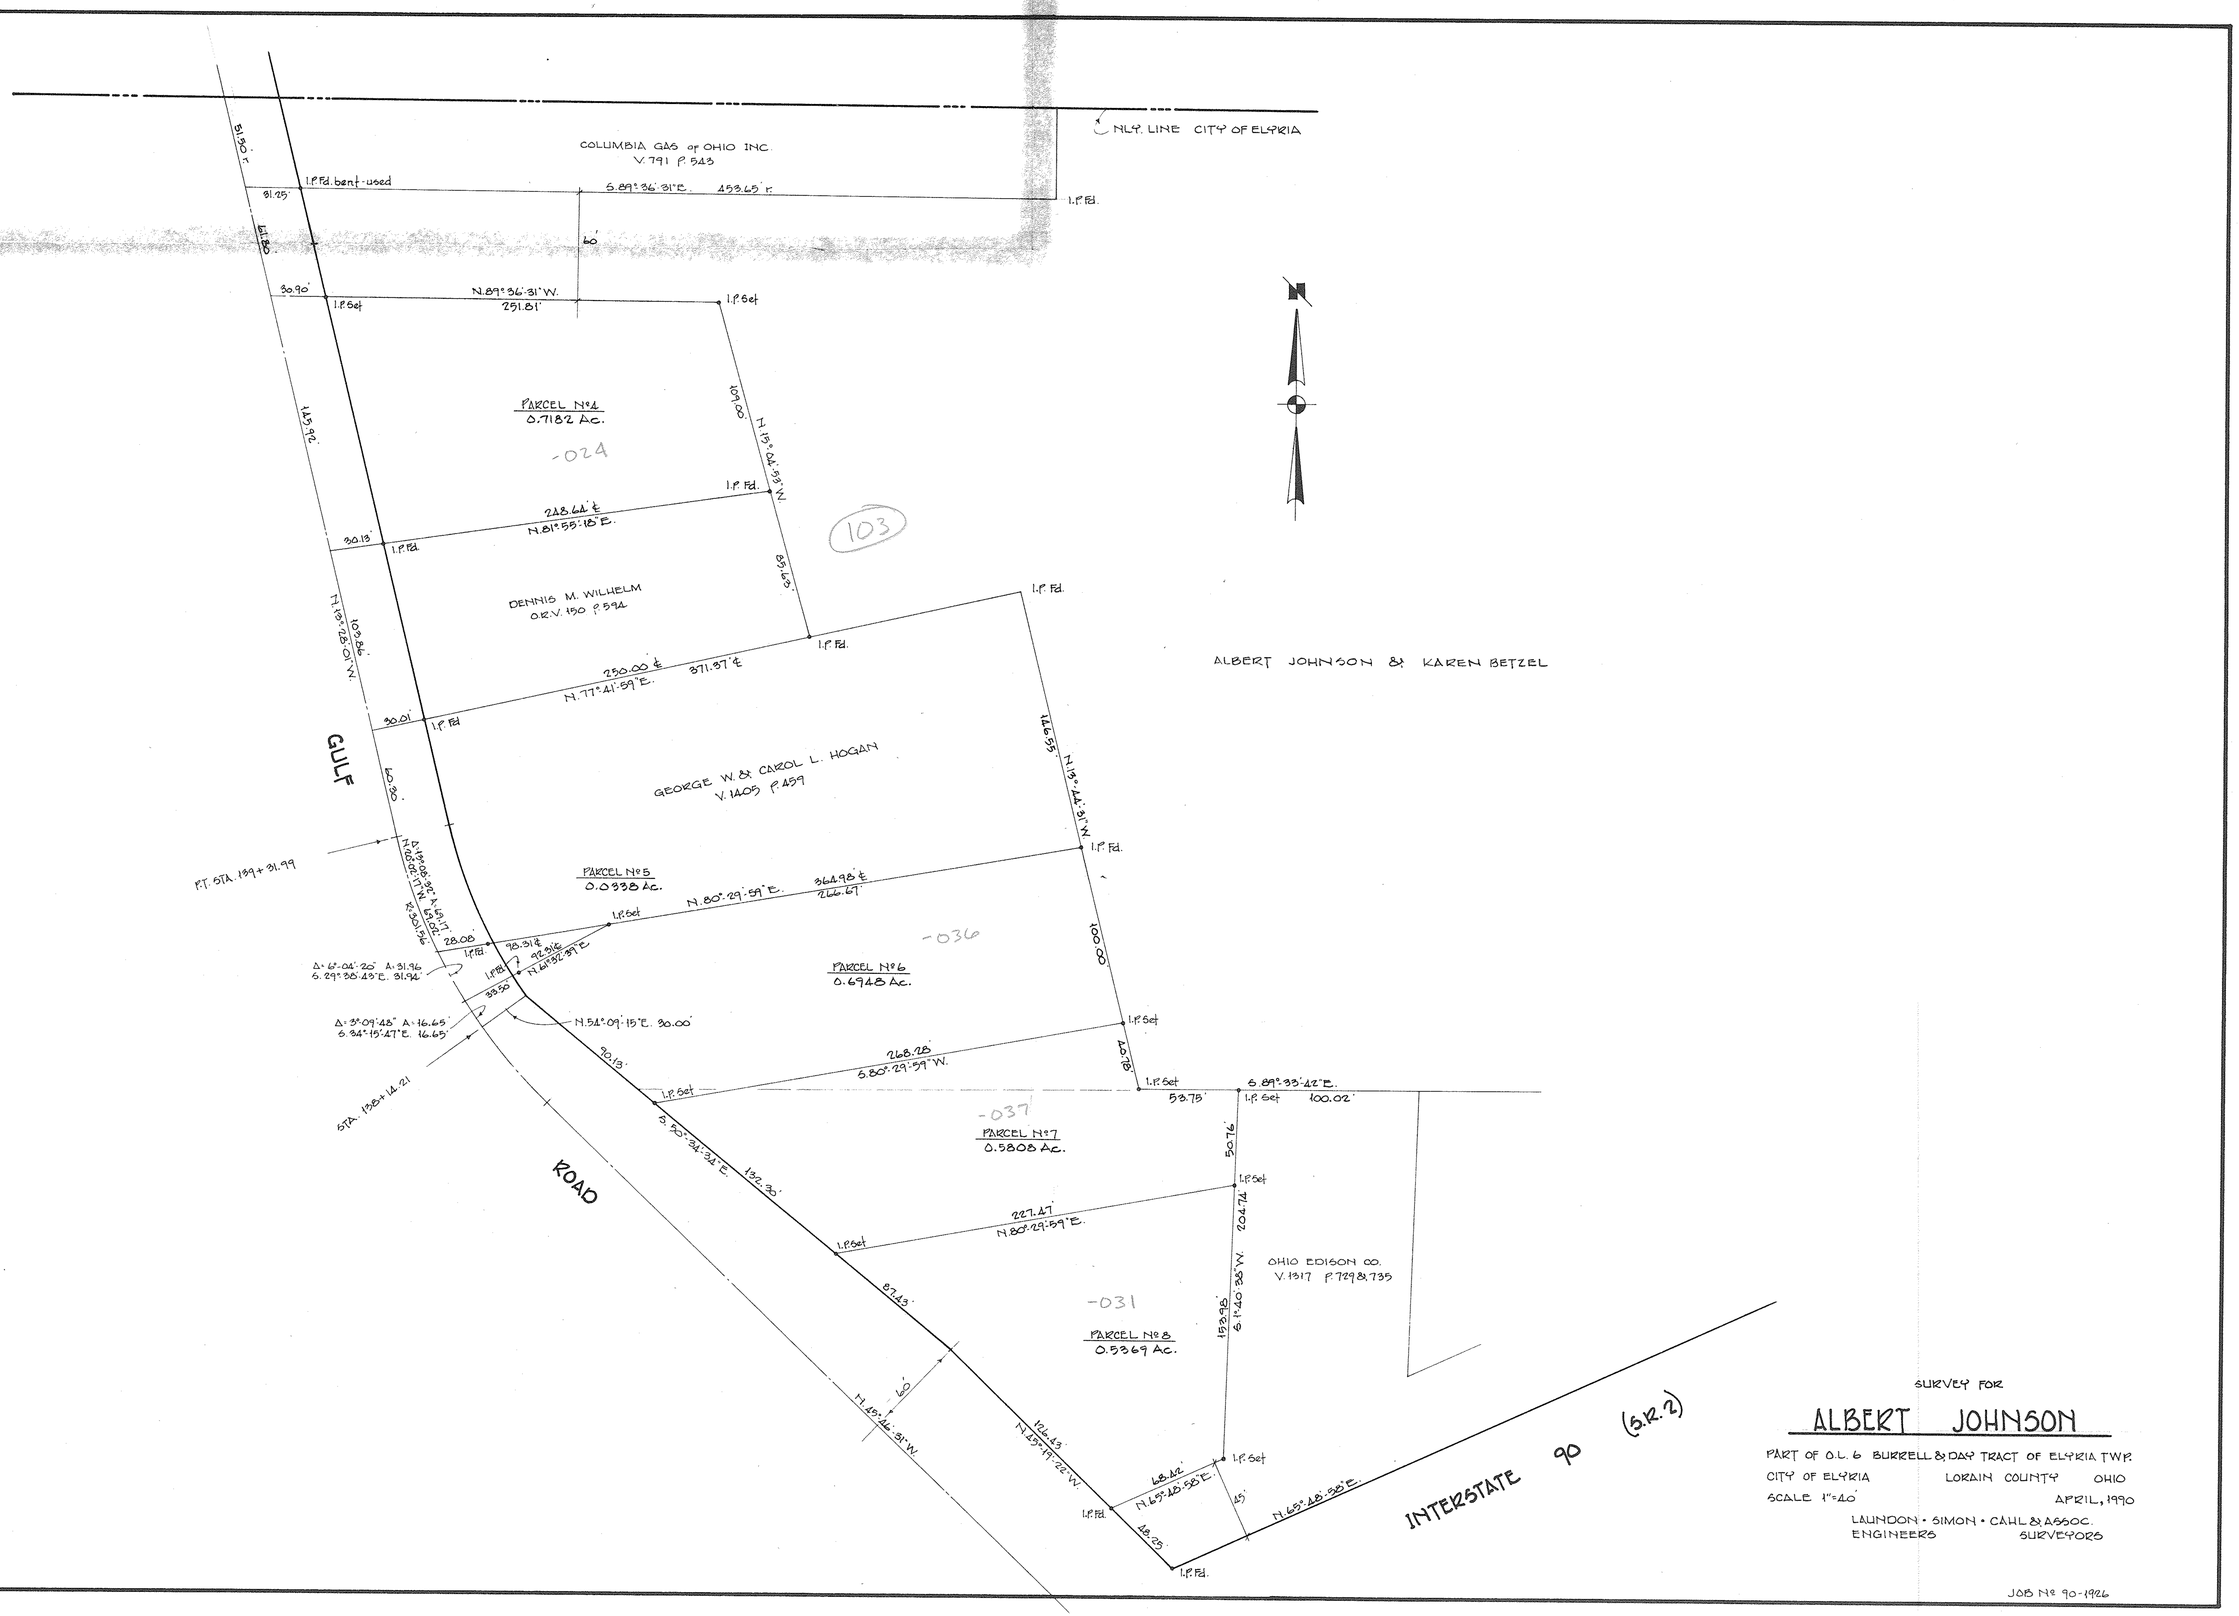

SURVEY FOR

ALBERT JOHNSON

PART OF O.L. 6 BURRELL & DAY TRACT OF ELYRIA TWP.
CITY OF ELYRIA LORAIN COUNTY OHIO
SCALE 1"=40' APRIL, 1990

LAUNDON · SIMON · CAHL & ASSOC.
ENGINEERS SURVEYORS

JOB No 90-1926

06-22-006-103-024, -031, -036, 037 06-14 249