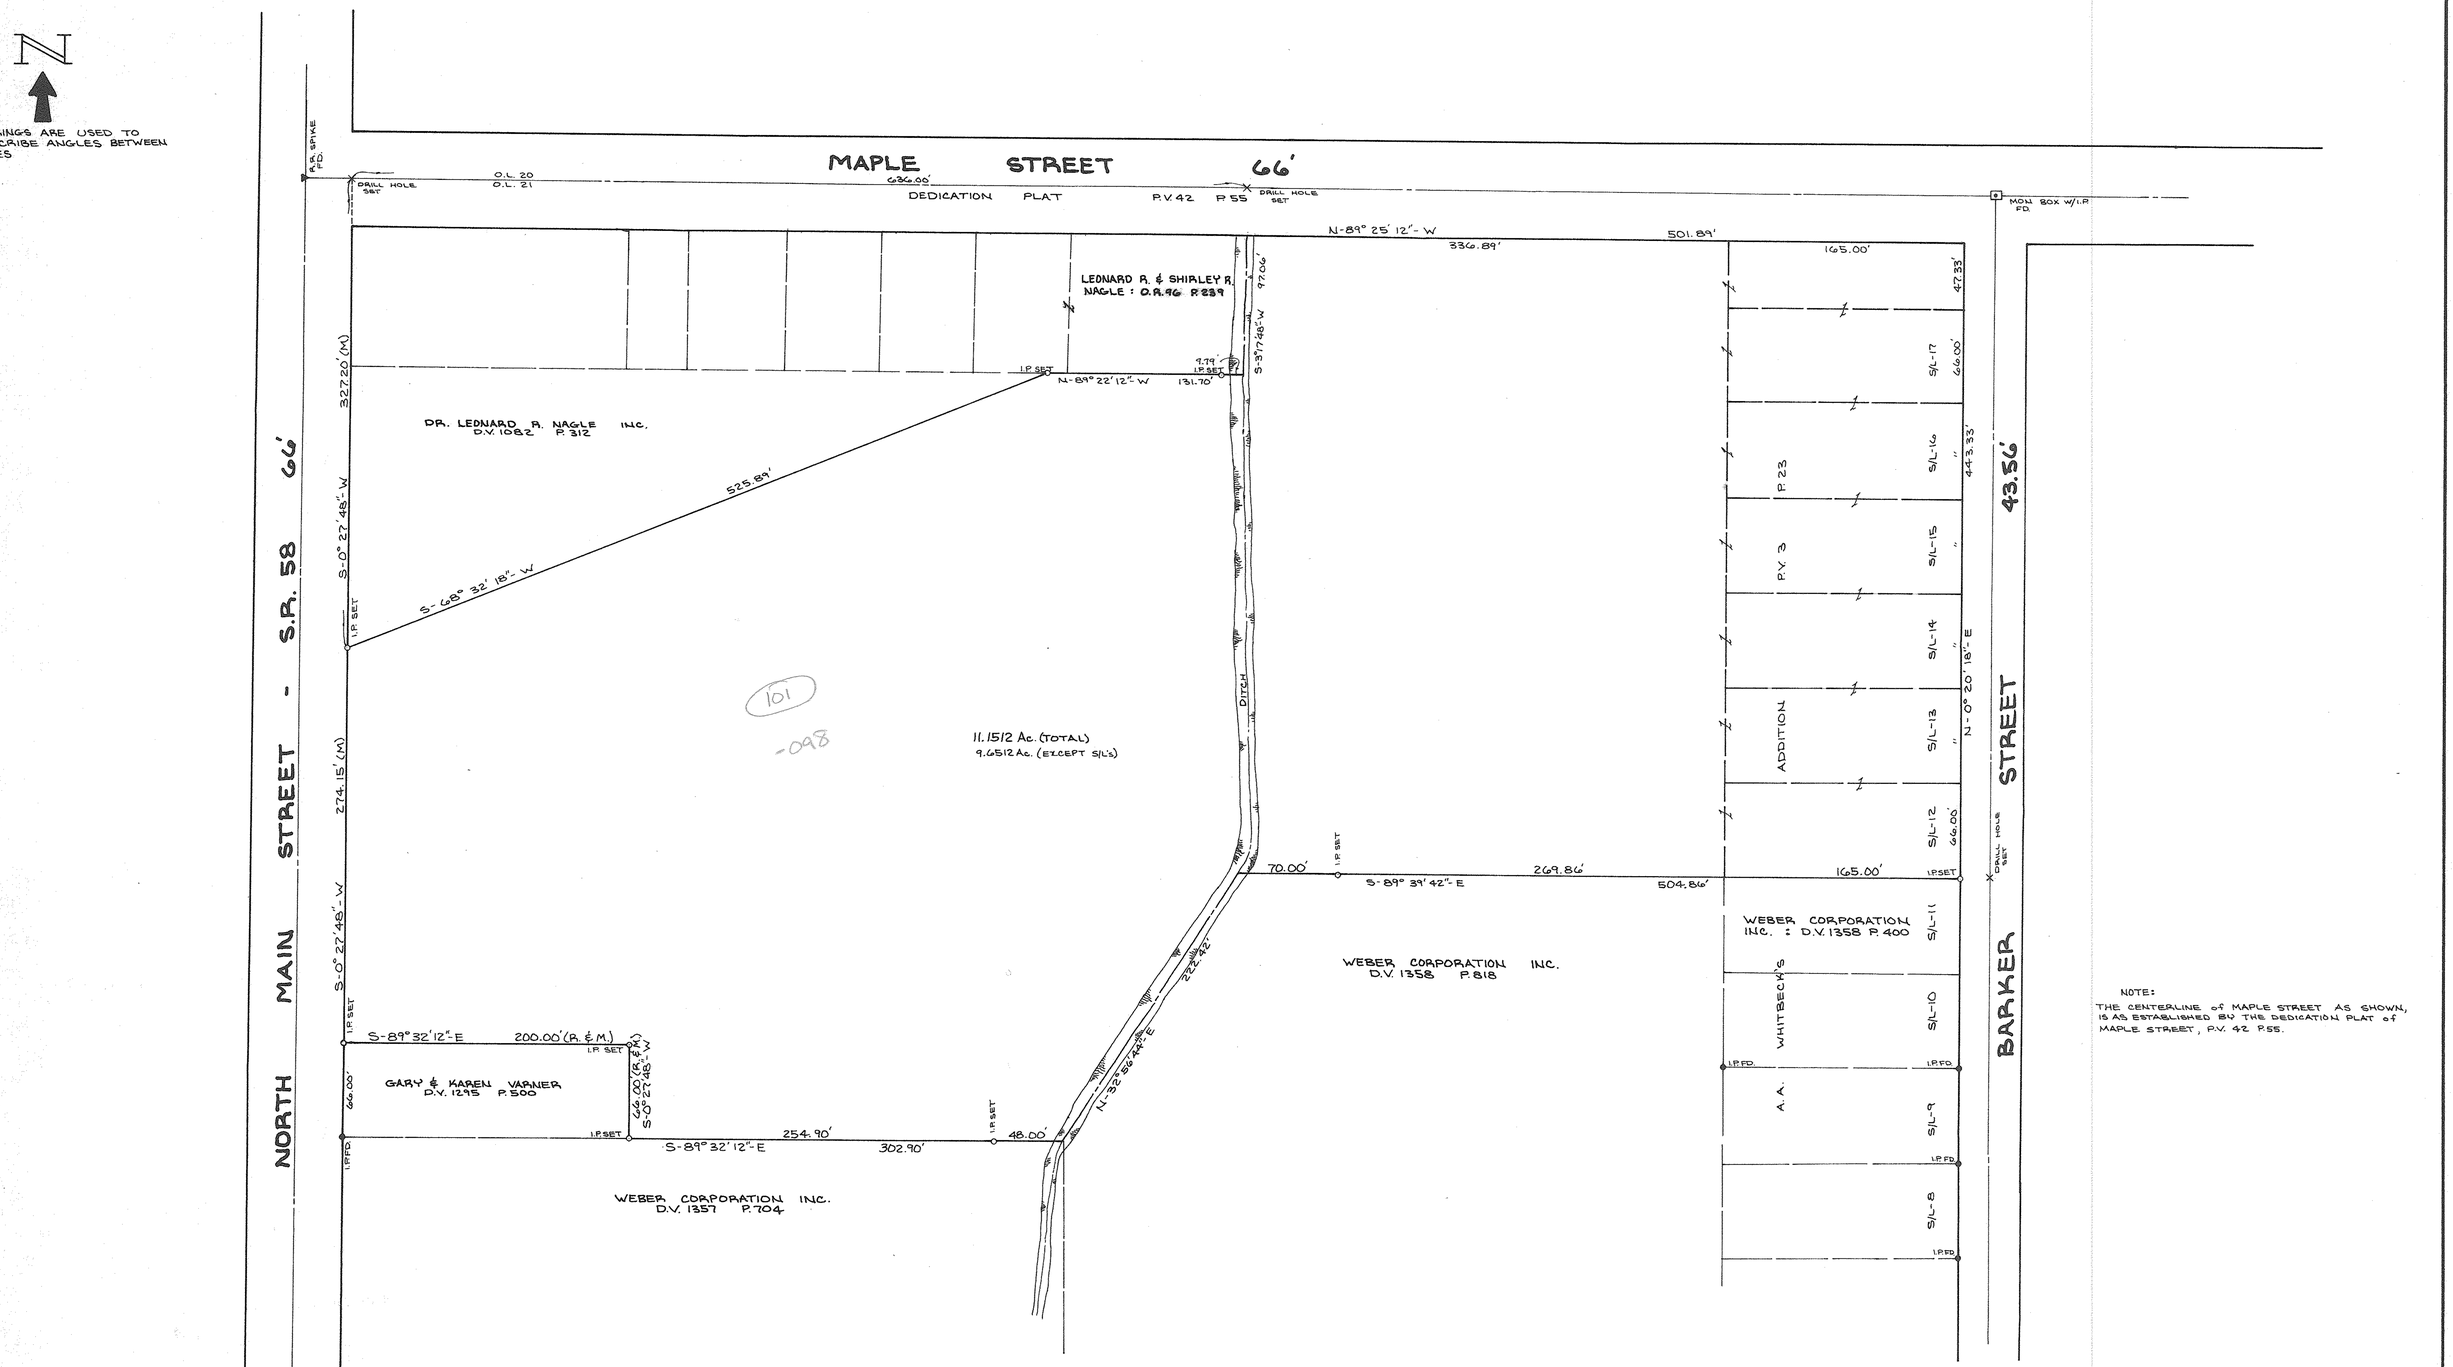

NOTE:
THE CENTERLINE of MAPLE STREET AS SHOWN, IS AS ESTABLISHED BY THE DEDICATION PLAT of MAPLE STREET, P.V. 42 P.55.

SURVEY for ESTATE of STEVE J. KOMIVES

PART of WELLINGTON TOWNSHIP, ORIGINAL LOT Nº 21

A.A. WHITBECK'S ADDITION - P.V. 3 P.23 - S/L's 12-17

VILLAGE of WELLINGTON COUNTY of LORAIN

STATE of OHIO

SCALE: 1" = 50' SEPT. 18, 1989

REGISTERED SURVEYOR: ROGER G. SIMON # 5101

GRAPHIC SCALE: 1" = 50'

20 10 0 25 15 35 50 75 100 125 175 250

18-00-021-101-098

18-00-021-A

PREPARED BY

LAUNDON-SIMON-CAHL & ASSOCIATES INC.
106 MIDDLE AVENUE
ELYRIA, OHIO 44035

210

89-1858