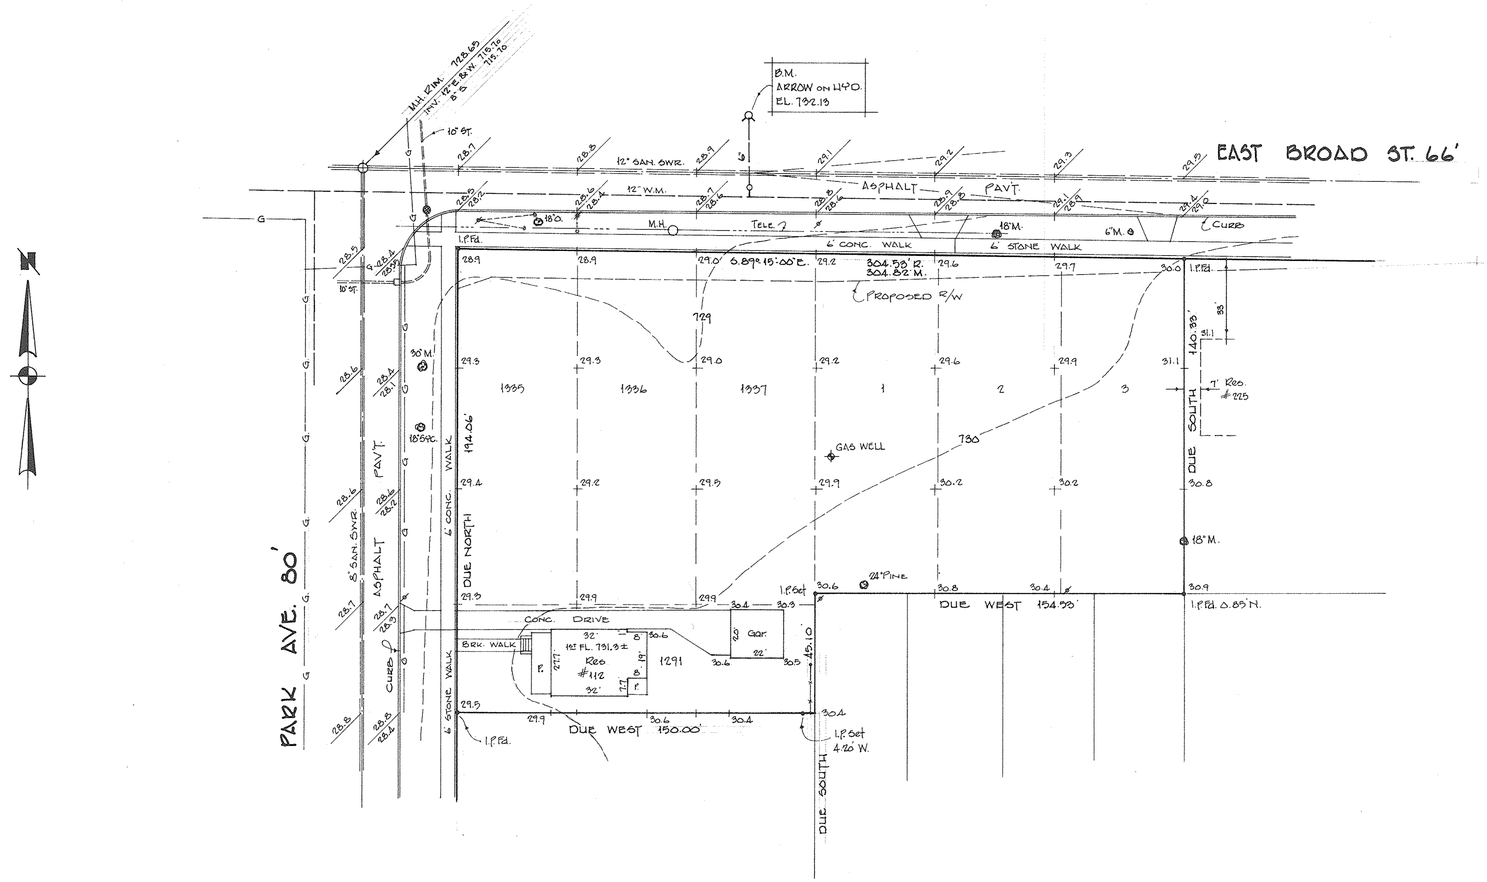

BOUNDARY & TOPOGRAPHICAL SURVEY FOR

ELYRIA MEMORIAL HOSPITAL

S/L's 1291, 1335, 1336 & 1337 IN EASTERN HEIGHTS LAND CO'S. SUB'N. No 1 P.V. 7 P.52 &
S/L's 1, 2 & 3 IN HILL REALTY CO'S. SUB'N. No 1 P.V. 6 P.55
PART OF O.L. 70 & 76 EAST OF BLACK RIVER TOWNSHIP OF ELYRIA
CITY OF ELYRIA COUNTY OF LORAIN STATE OF OHIO

SCALE 1" = 30' APRIL, 1989

LAUNDON • SIMON • CAHL & ASSOC.
ENGINEERS SURVEYORS
219 COURT ST. ELYRIA, OHIO
89-1816

06-25-076-102-001 06-122

241A