PART OF RIDGEVILLE TOWNSHIP LOT NO. 28
CITY OF NORTH RIDGEVILLE
COUNTY OF LORAIN, STATE OF OHIO

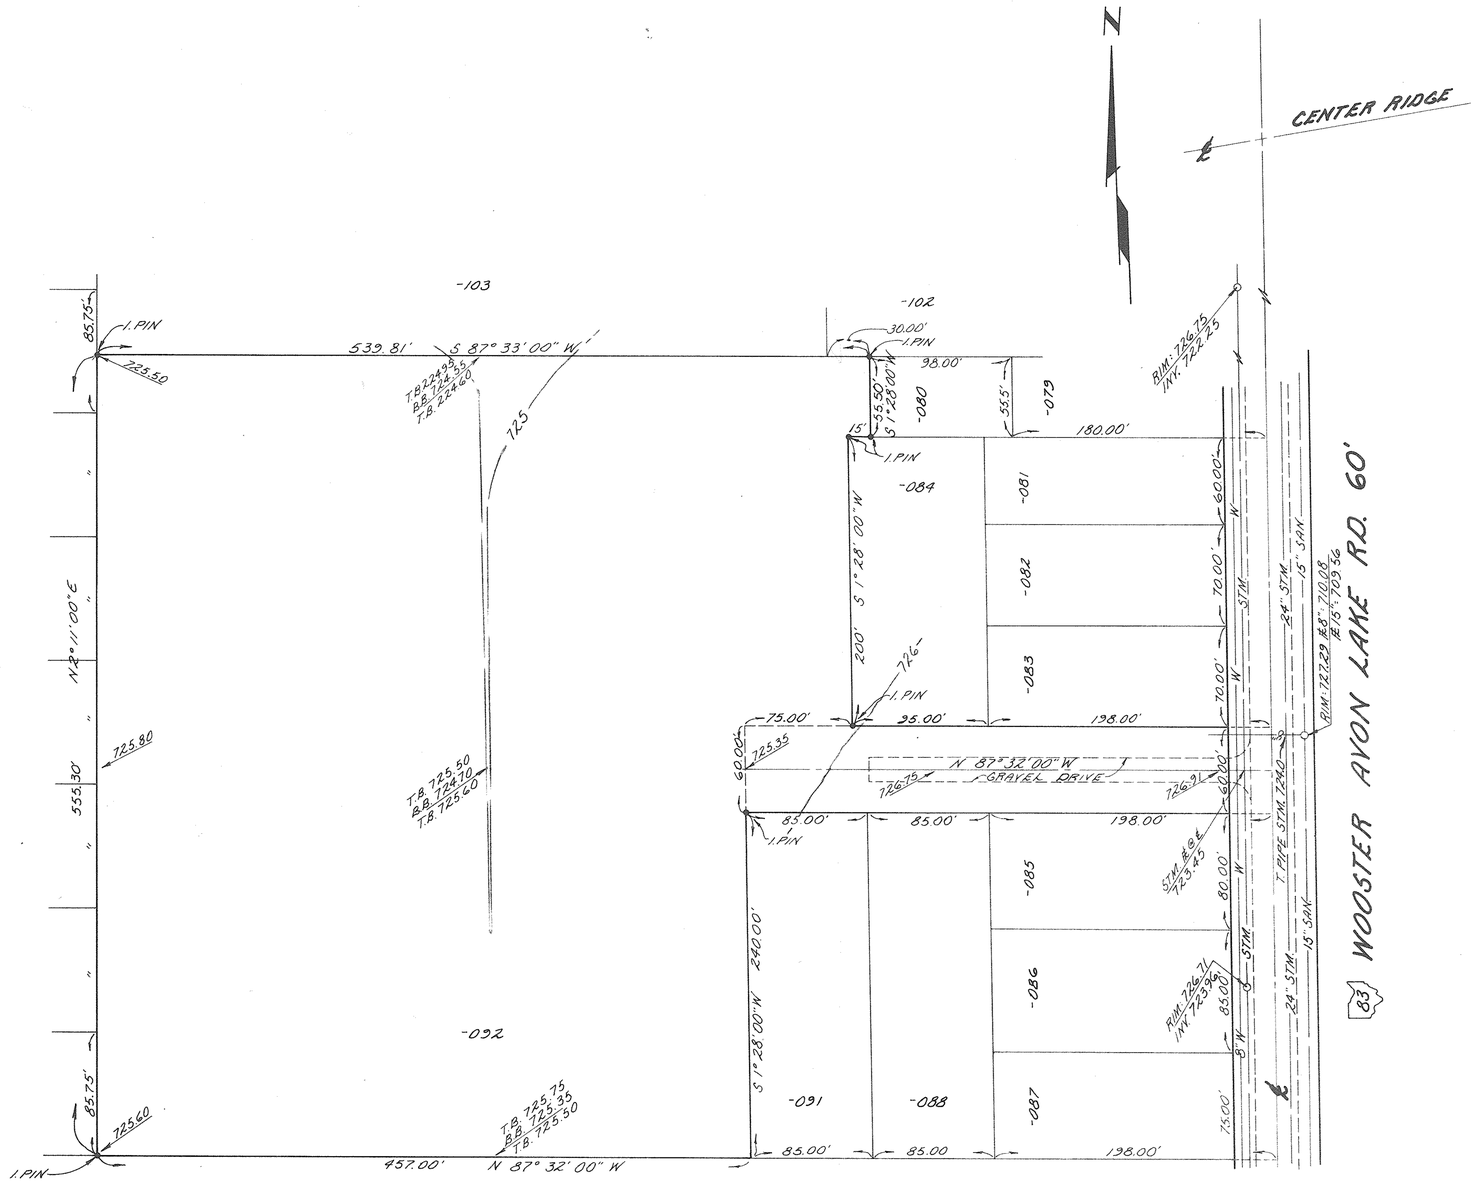

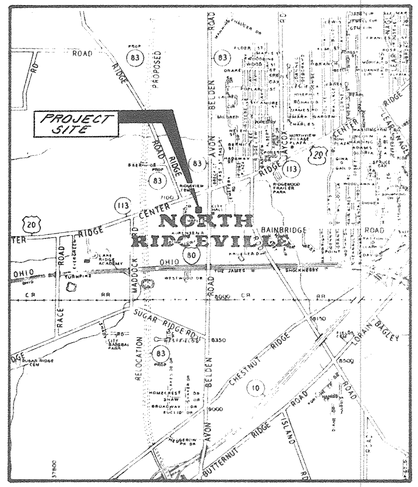

LOCATION MAP
SCALE: 1" = 3300'

Pt. OF MAPLEWOOD SUB. No. 1

07-00-028-103-116

STATE OF OHIO
PETER C. ZWICK
4929
REGISTERED SURVEYOR

07-00-028-D
07-00-028-103