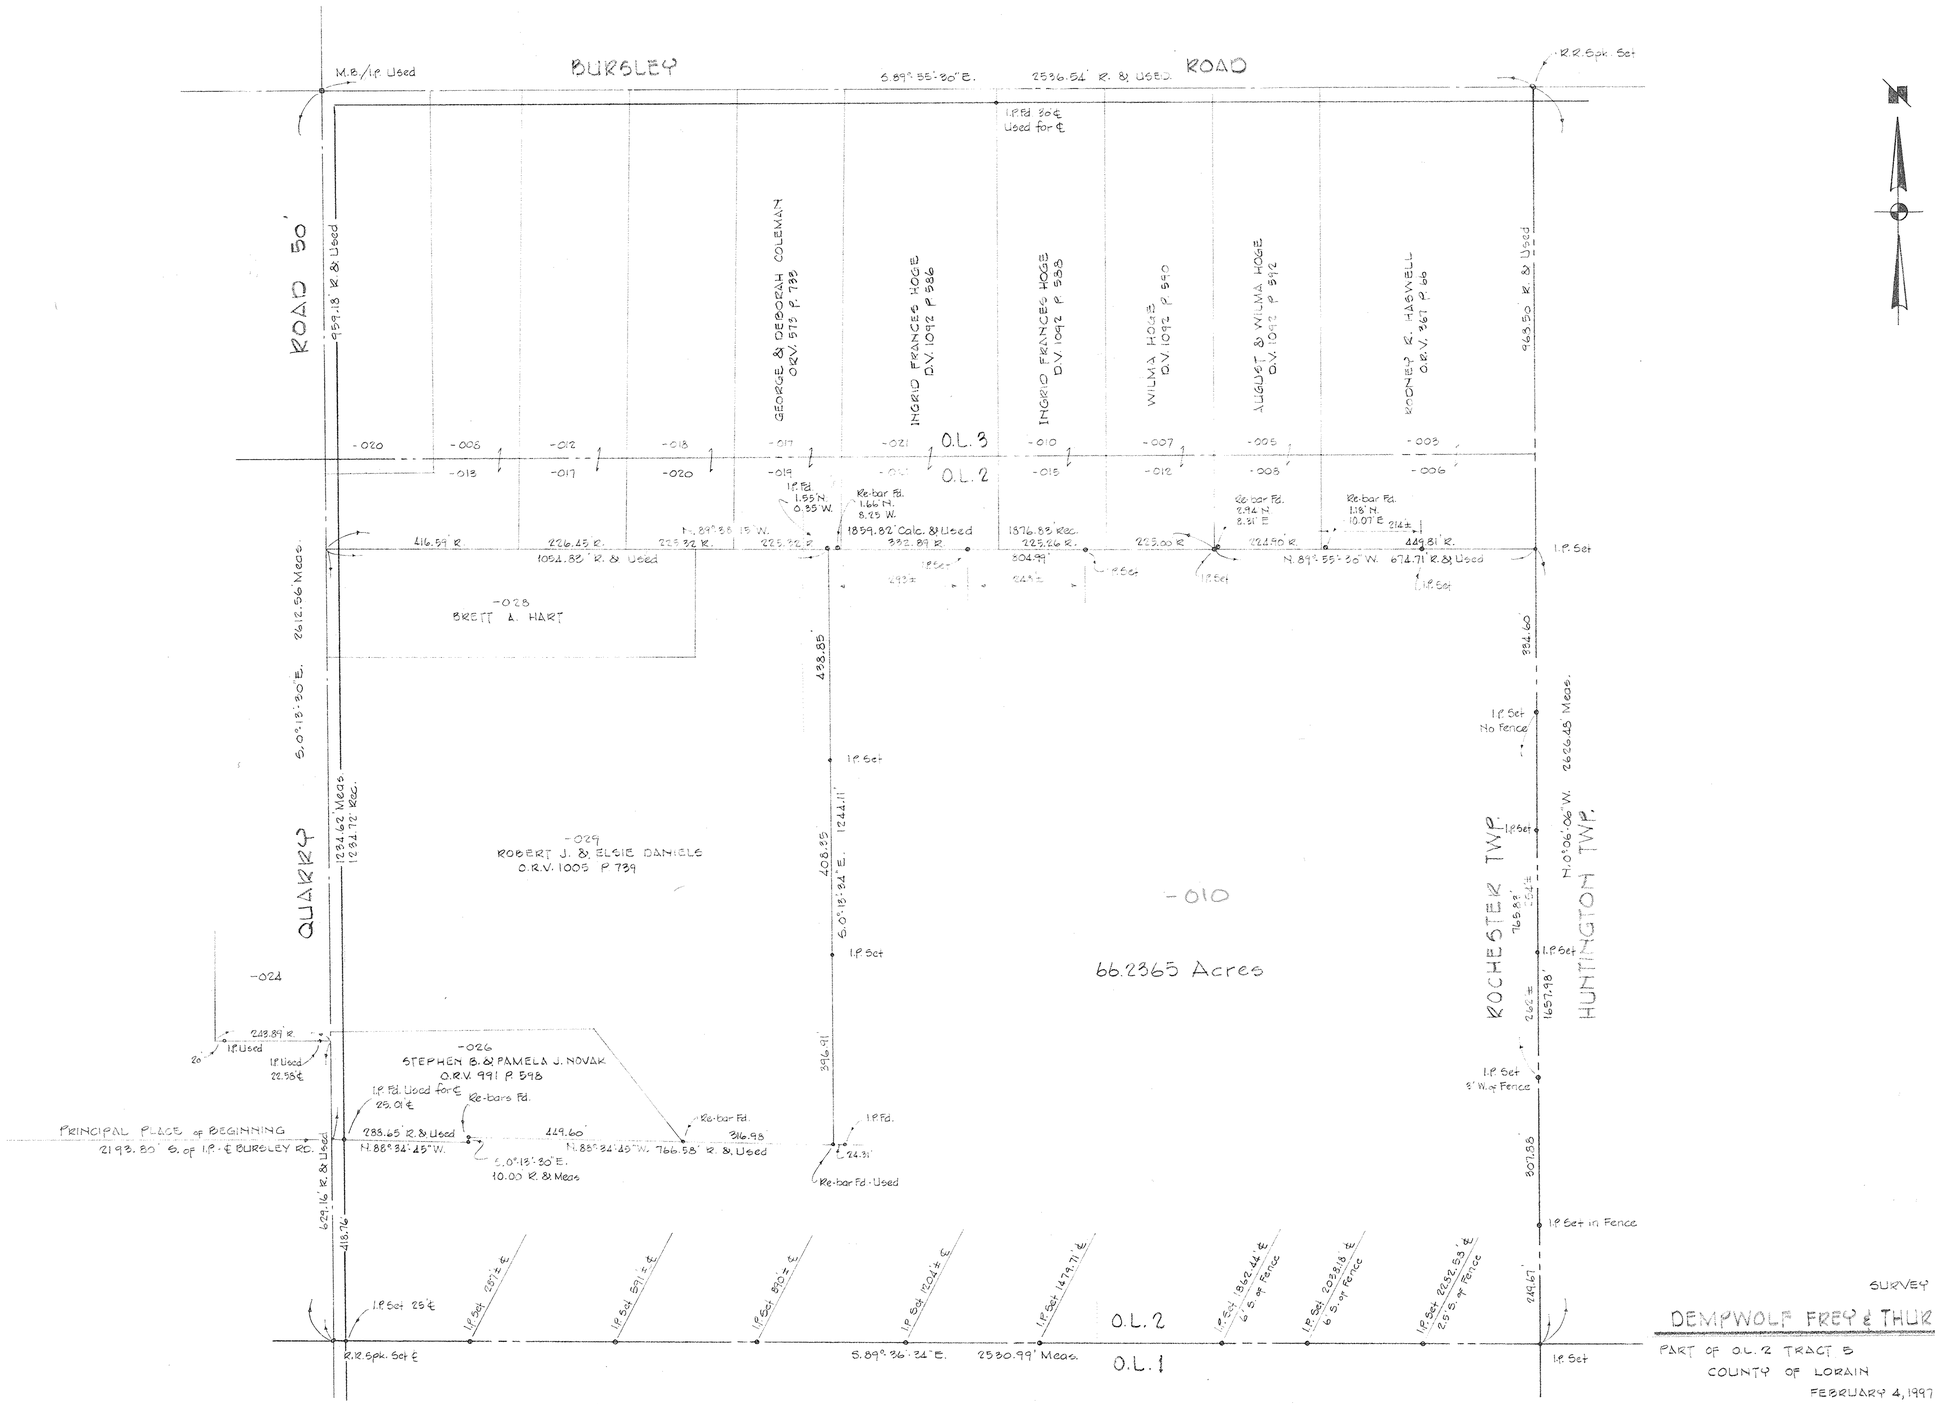

SURVEY FOR

DEMPWOLF FREY & THURMAN DOWNING, TRUSTEES

PART OF O.L. 2 TRACT B — TOWNSHIP OF ROCHESTER

COUNTY OF LORAIN — STATE OF OHIO

FEBRUARY 4, 1997 — SCALE 1"=150'

LAUNDON • SIMON • CAHL & ASSOC.
PROFESSIONAL LAND SURVEYORS
110 MIDDLE AVE. ELYRIA, O. 44035

JOB Nº 96-2923 F.B. 240 P. 32-35

REV. 2-19-97 Add intermediate I.P.s

20-05-002-000-010 20-D

344