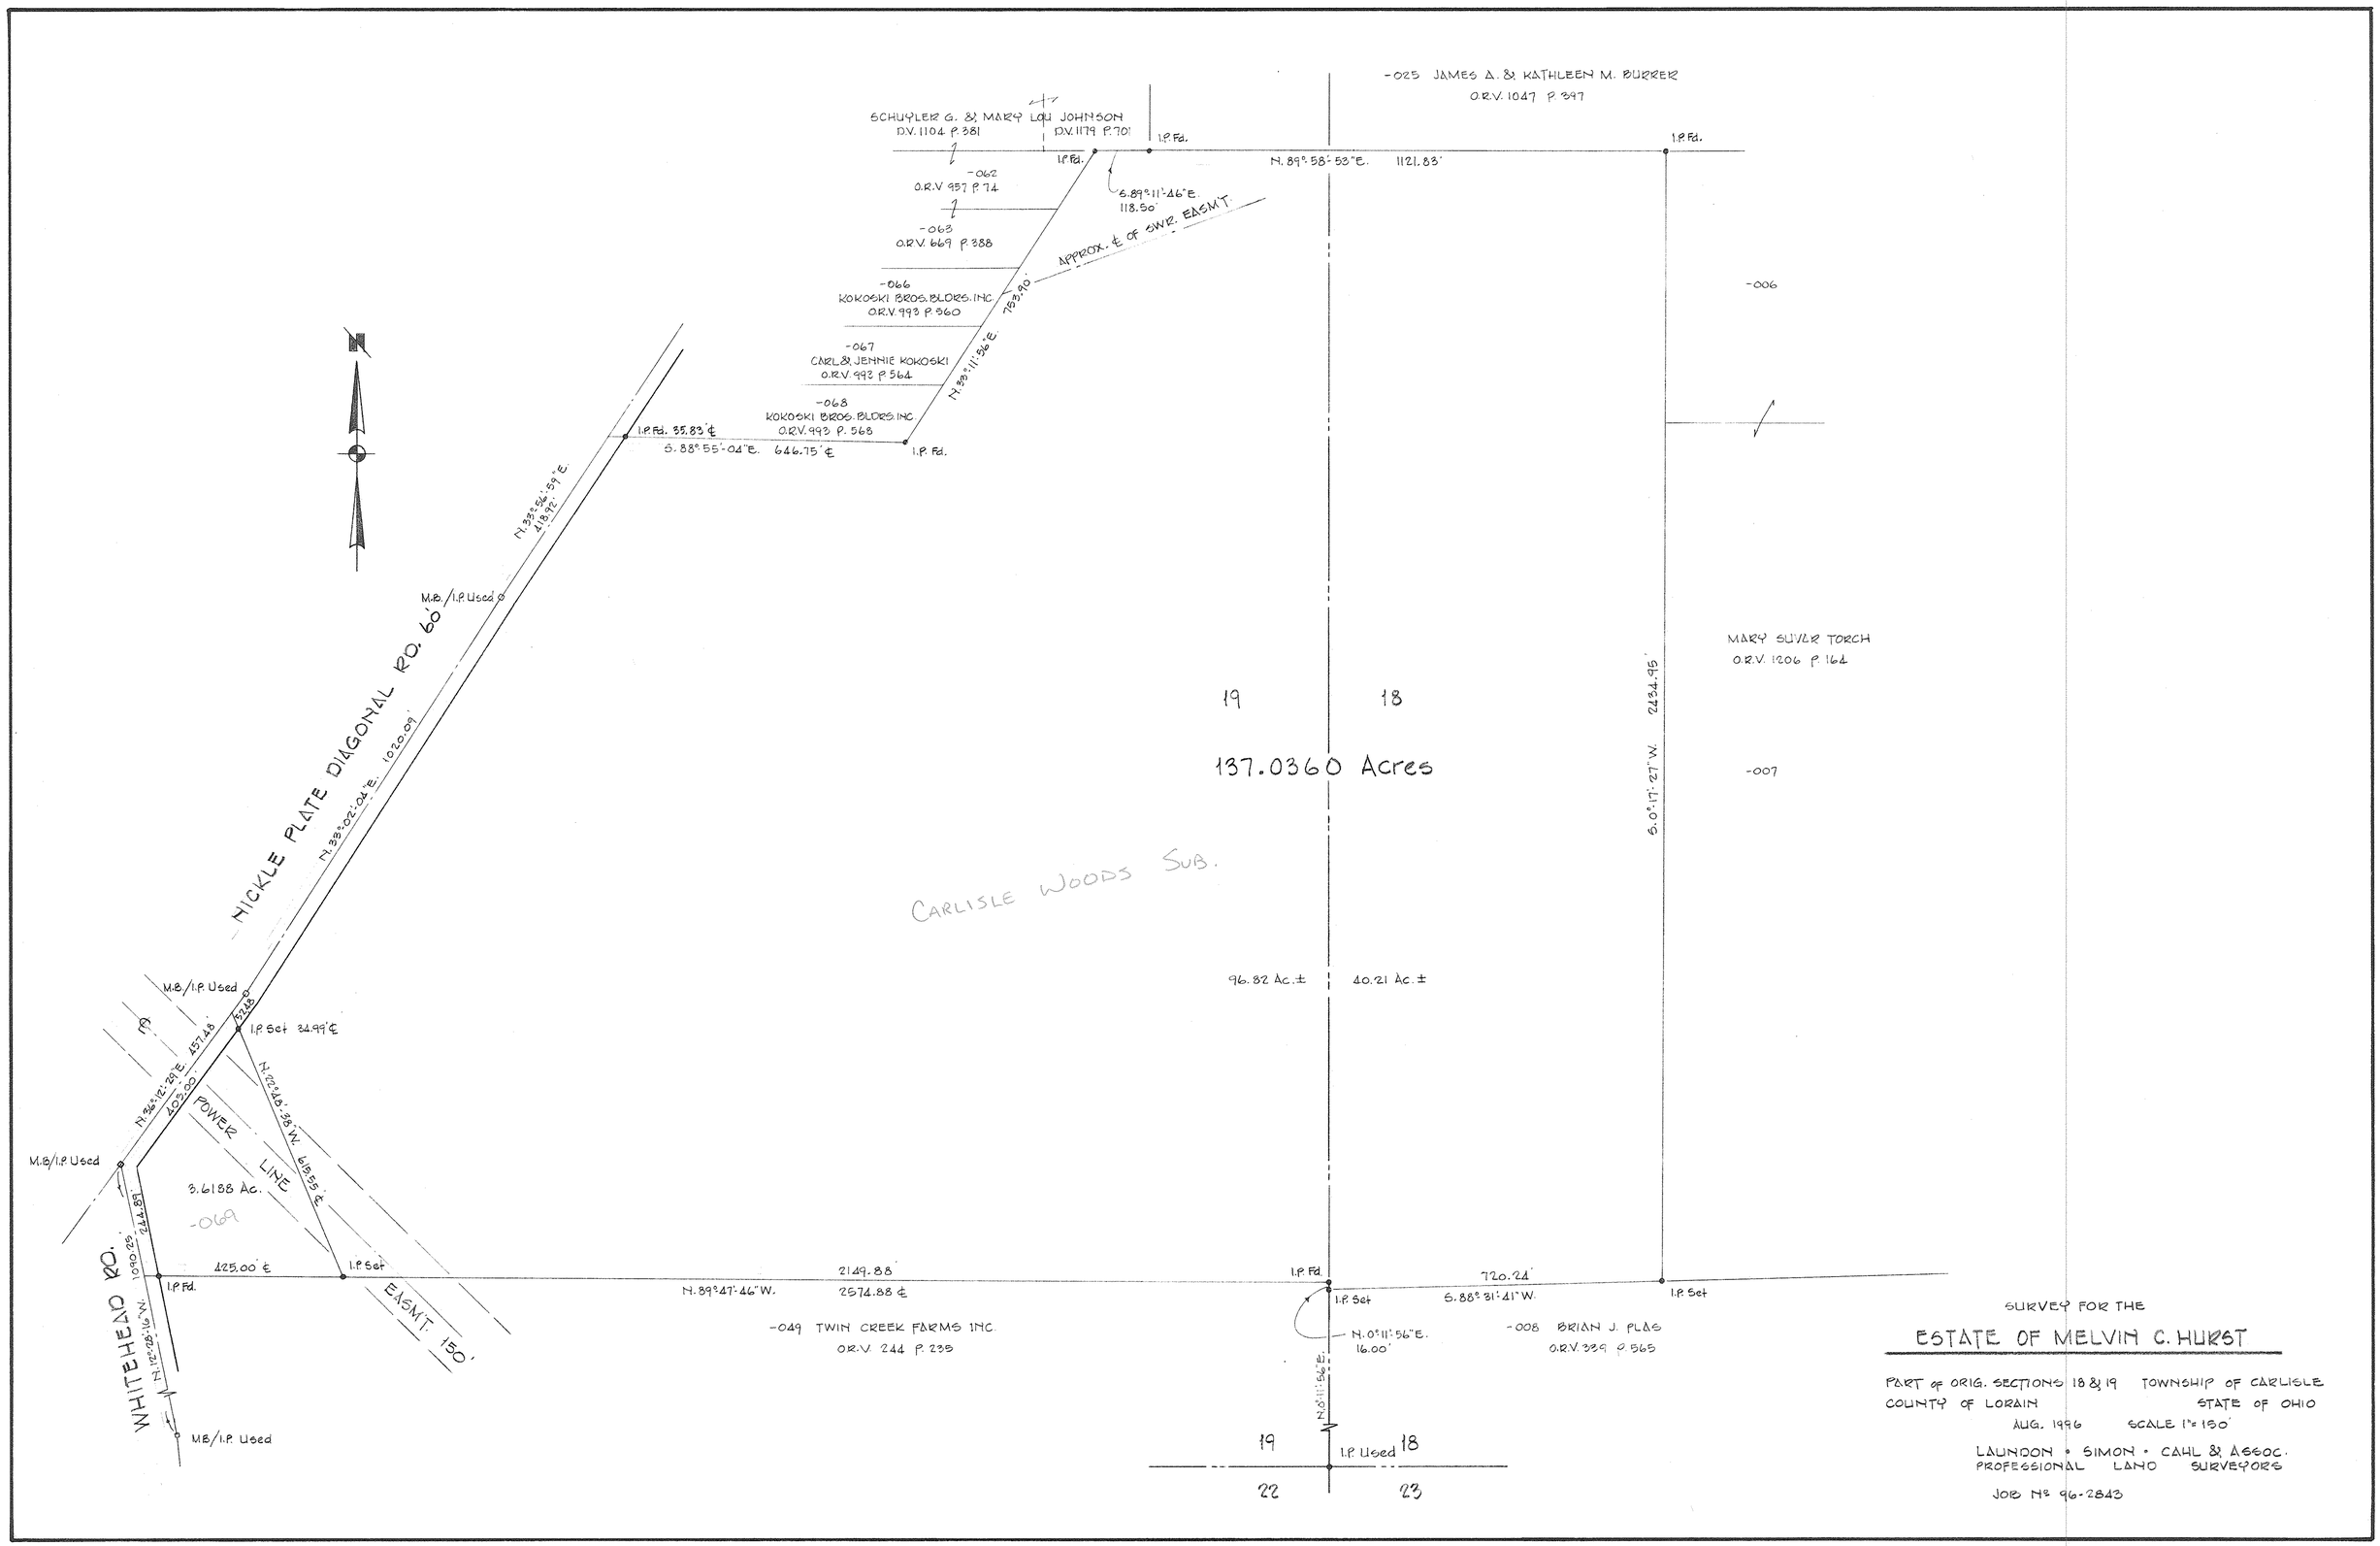


SURVEY FOR THE

## ESTATE OF MELVIN C. HURST

PART OF ORIG. SECTIONS 18 & 19 TOWNSHIP OF CARLISLE
COUNTY OF LORAIN STATE OF OHIO
AUG. 1996 SCALE 1"= 150'

LAUNDON • SIMON • CAHL & ASSOC.
PROFESSIONAL LAND SURVEYORS

JOB Nº 96-2843

10-00-019-000-069 10.F

337